



SUPERELEVATION PER FT. OF ROADWAY

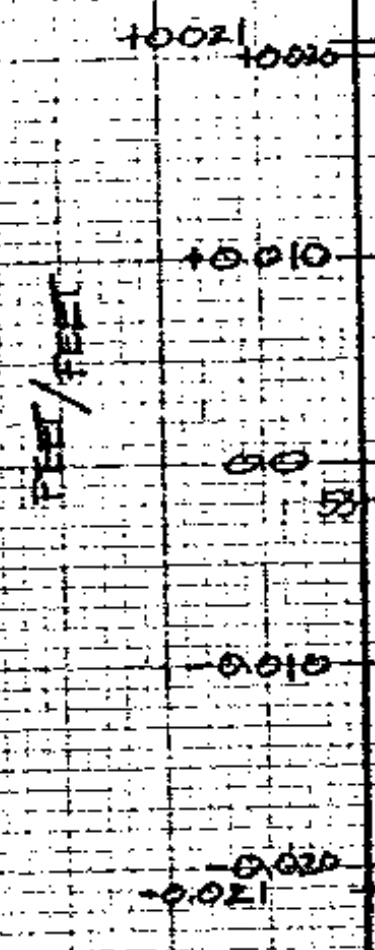


BANKING TRANSITION.

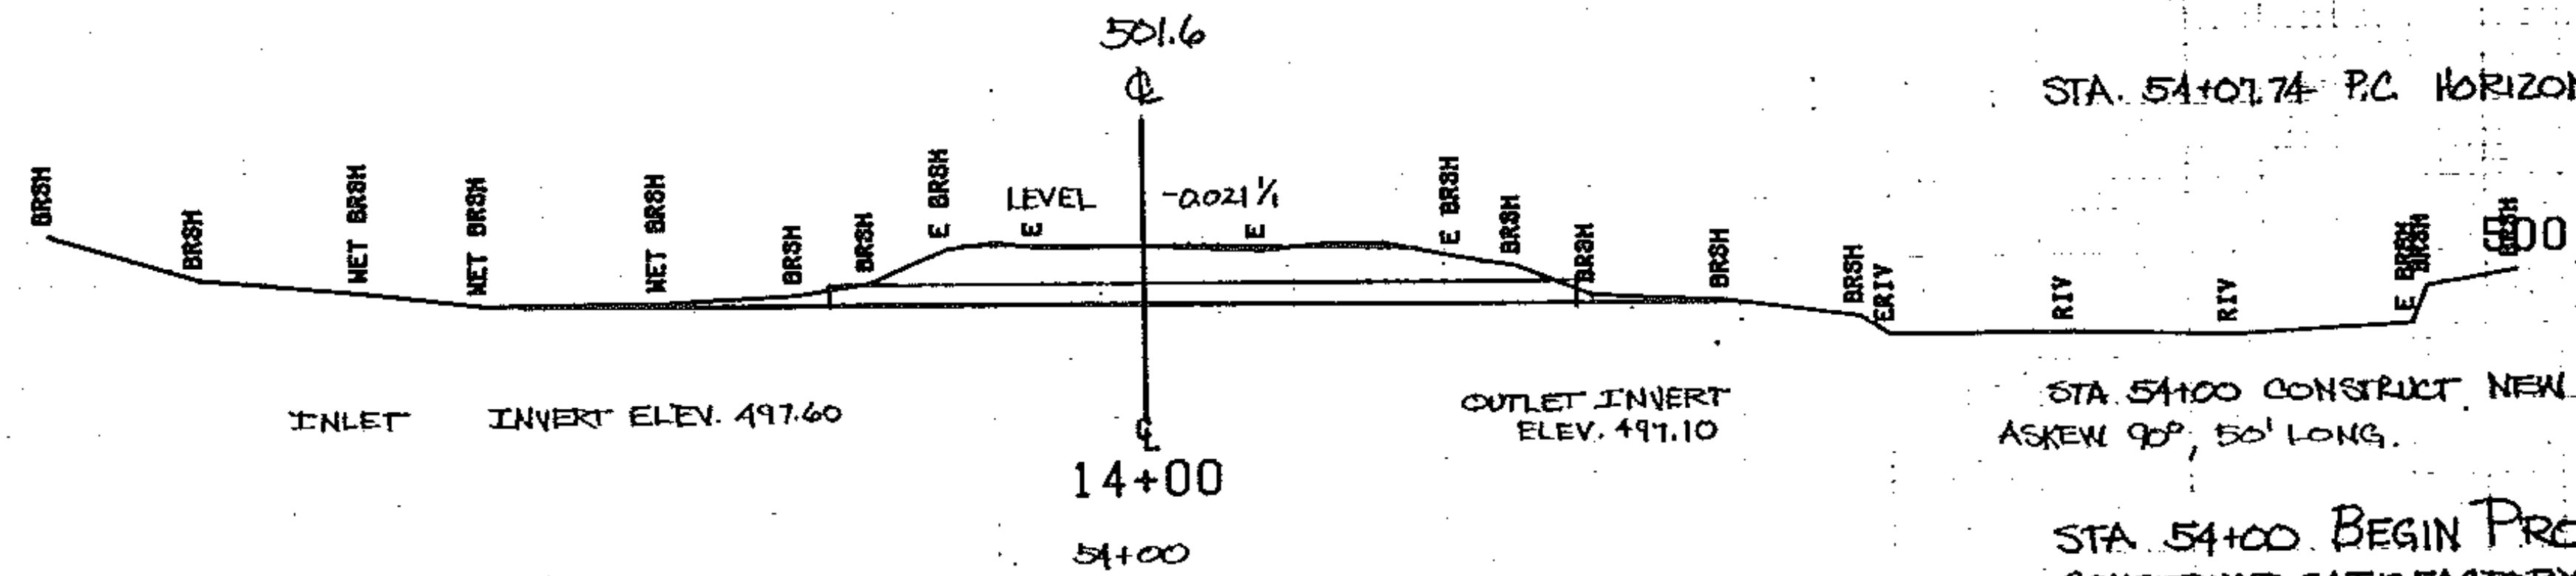


STA. 54+07.74 P.C. HORIZONTAL CURVE.

STA. 54+00 CONSTRUCT NEW 18" ACCGMP (0.064") ASKEW 90°, 50' LONG.

STA. 54+00 BEGIN PROJECT, CONSTRUCT SATISFACTORY APPROACH.

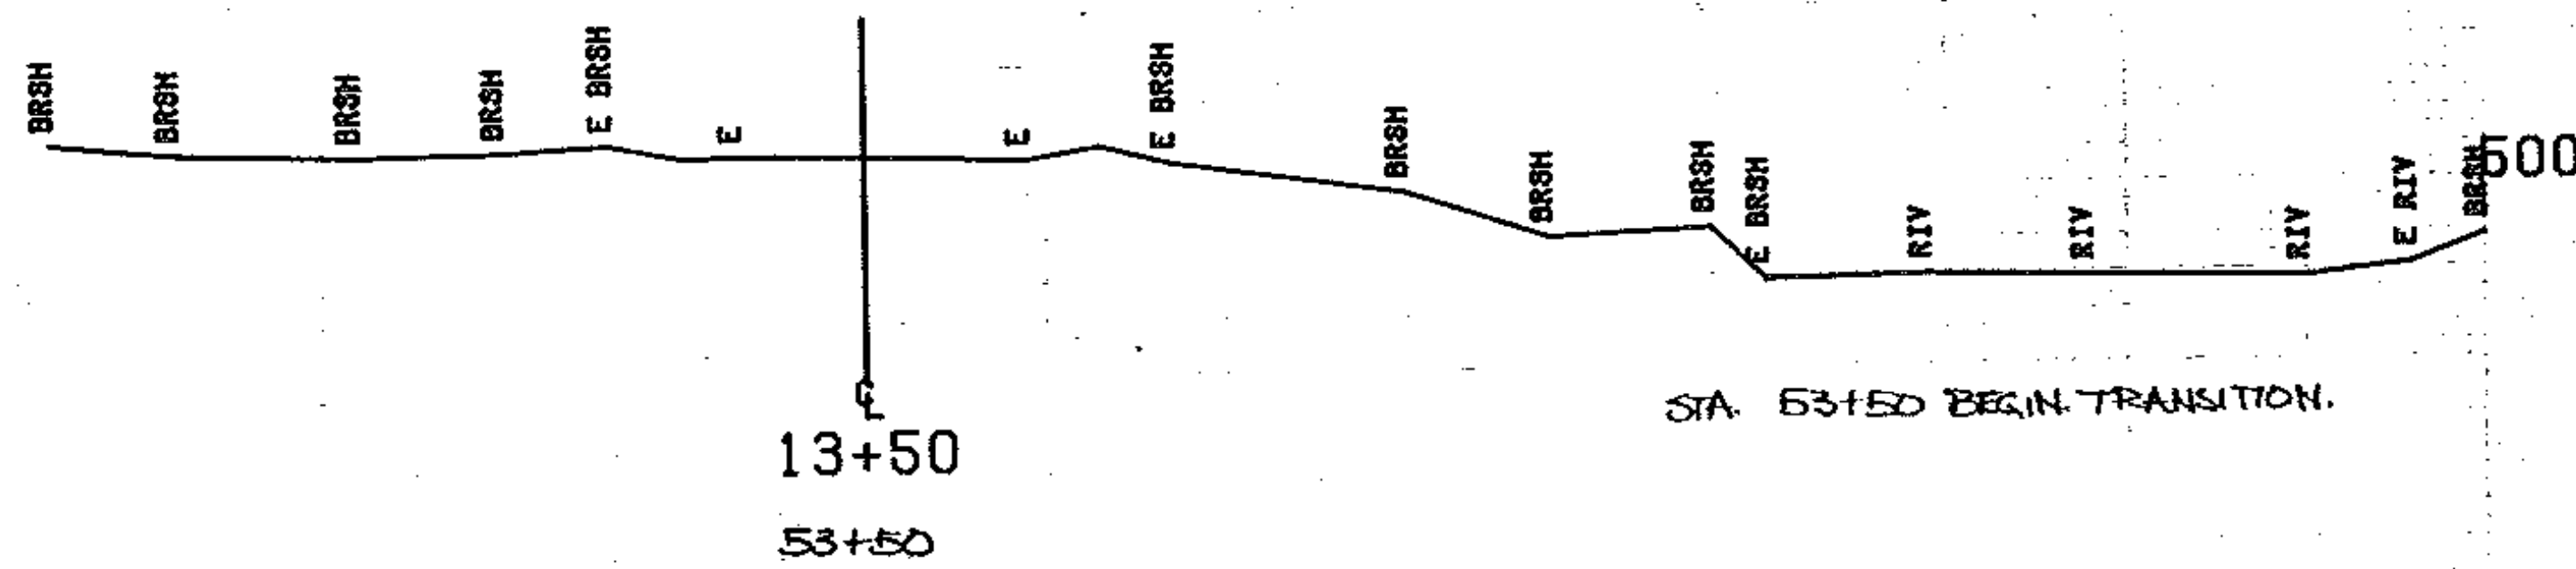

STA. 53+50 BEGIN TRANSITION.

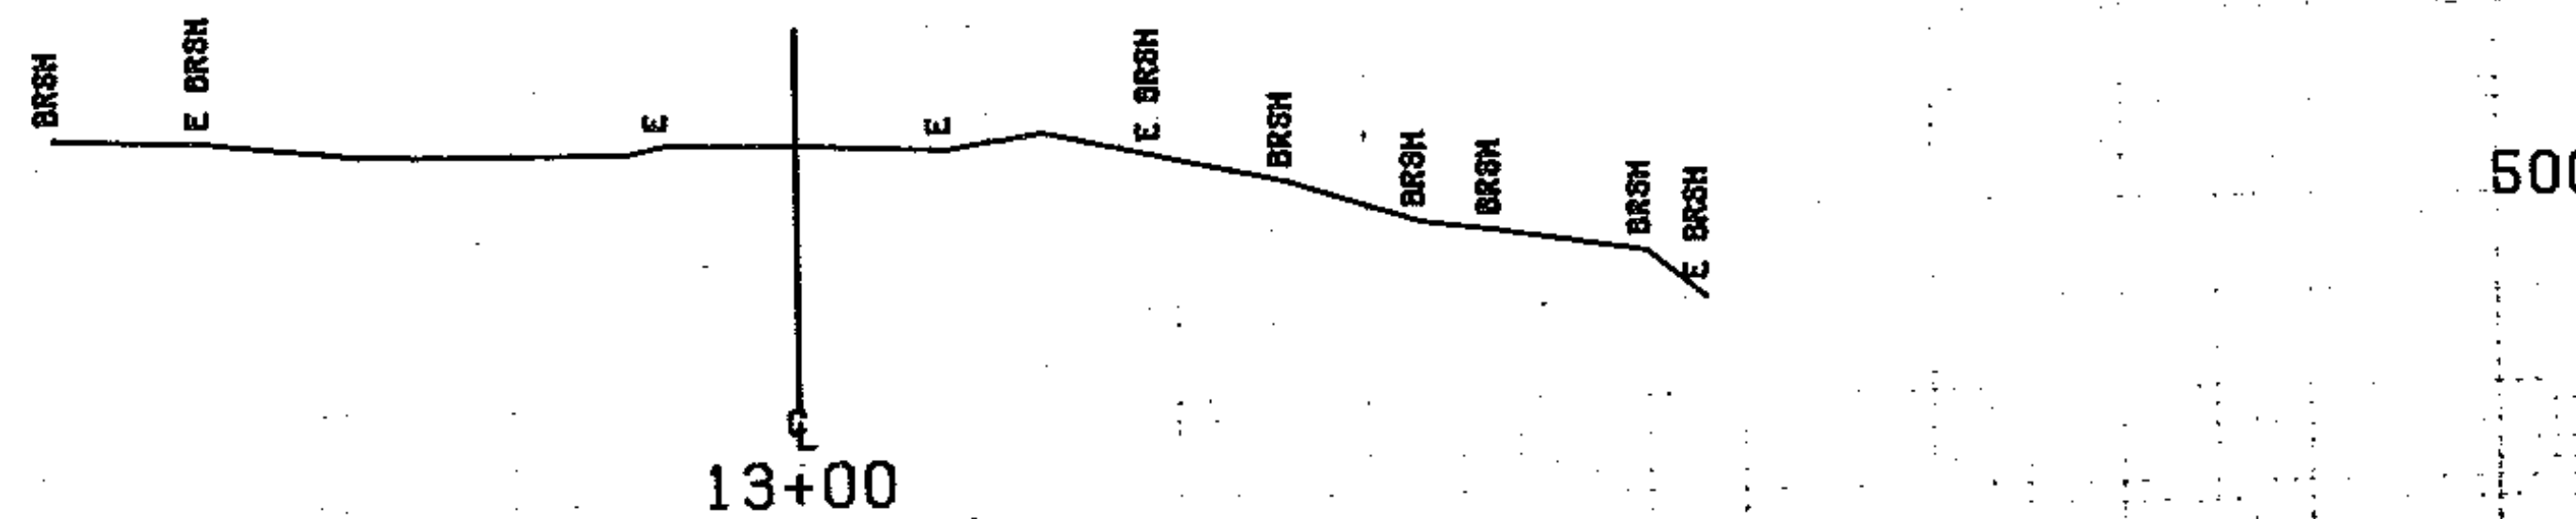

FROM STA. 13+00	TO STA. 14+00
PROJECT NAME CONCORD MAIN	
NO. BR21447(10)	PLOTTED 11/16/62
SURVEYED BY SARGENT	JANUARY 1962
SHEET 15 OF 27	SHEET 15

SCALE 1" = 10 FEET