


490

STA. 57+36 PVI CURVE No. 3

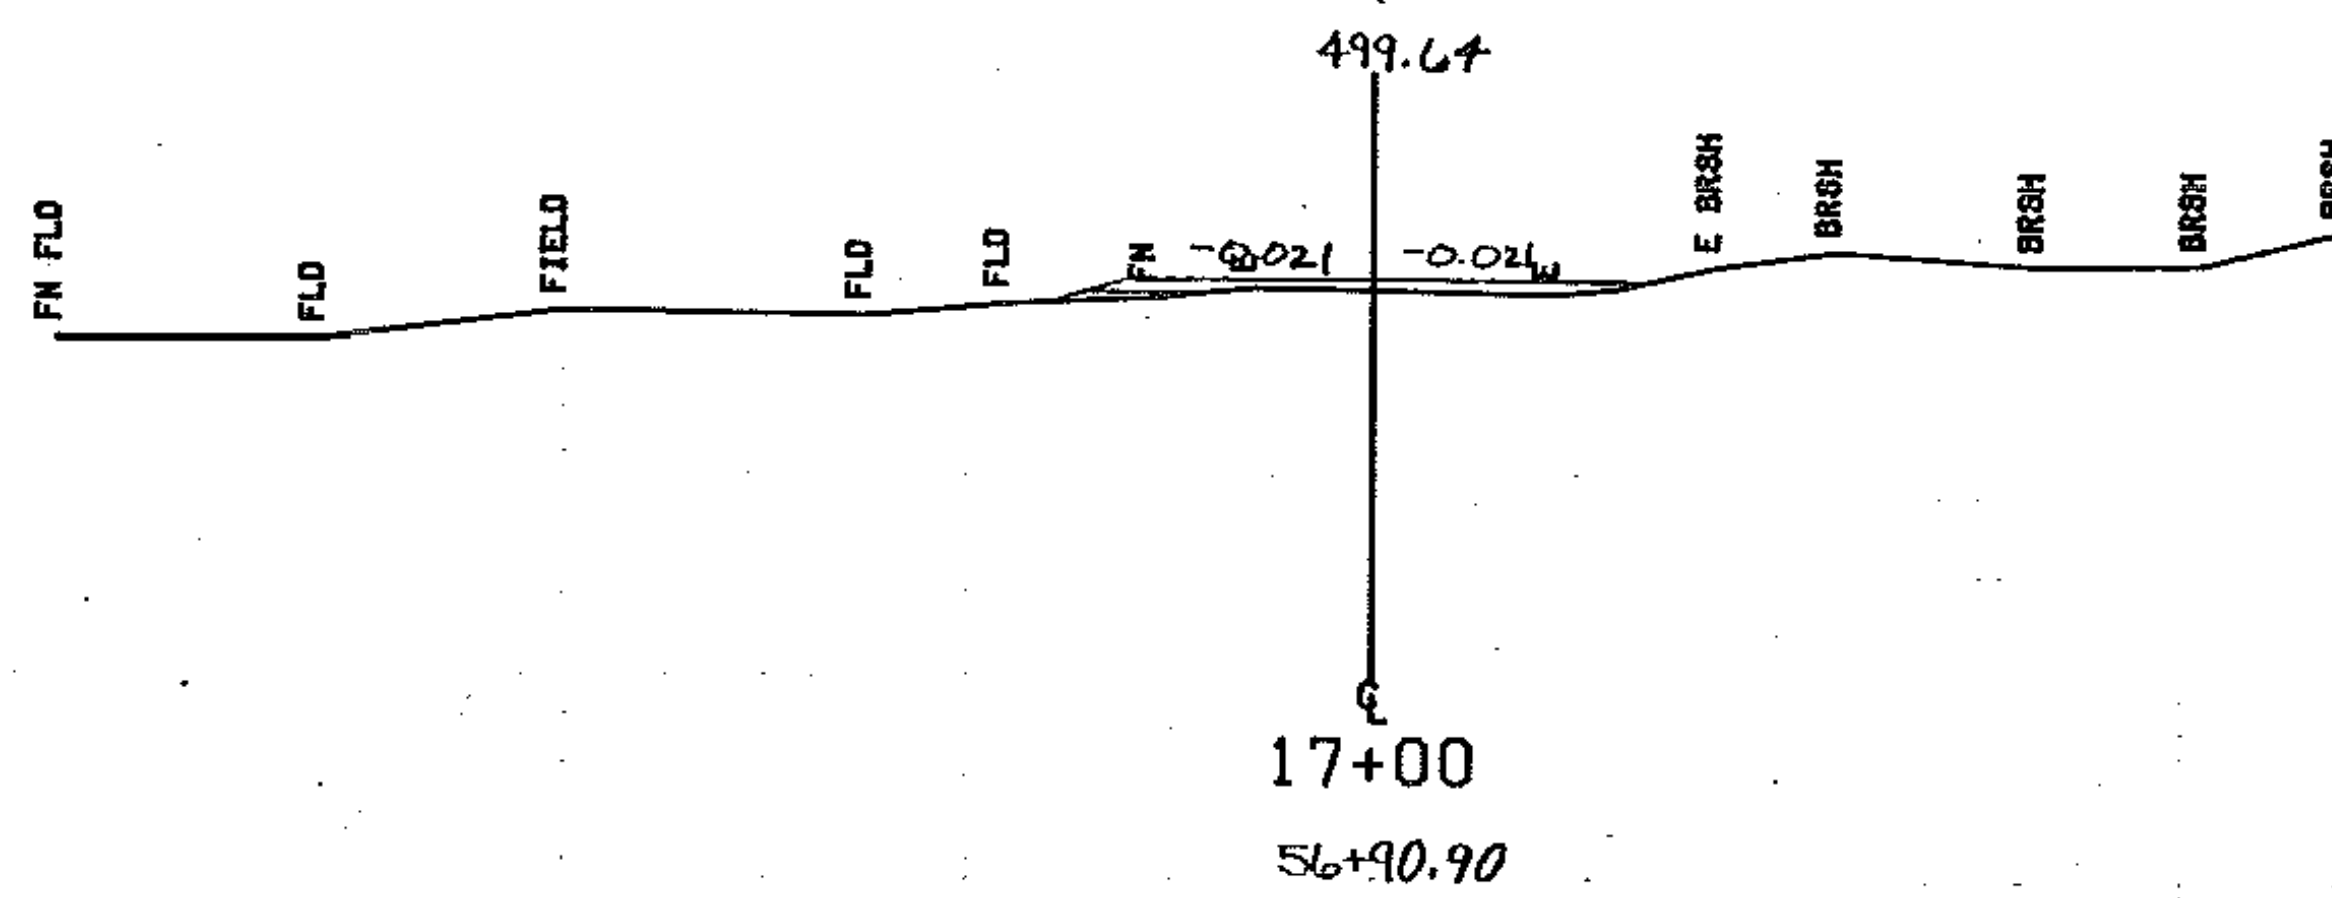



STA 57+00 END PROJECT
CONSTRUCT SATISFACTORY APPROACH.

490

STA 57+00 END TRANSITION

STA. 56+86 PVI CURVE No. 3

SUPERELEVATION PER FT OF ROADWAY

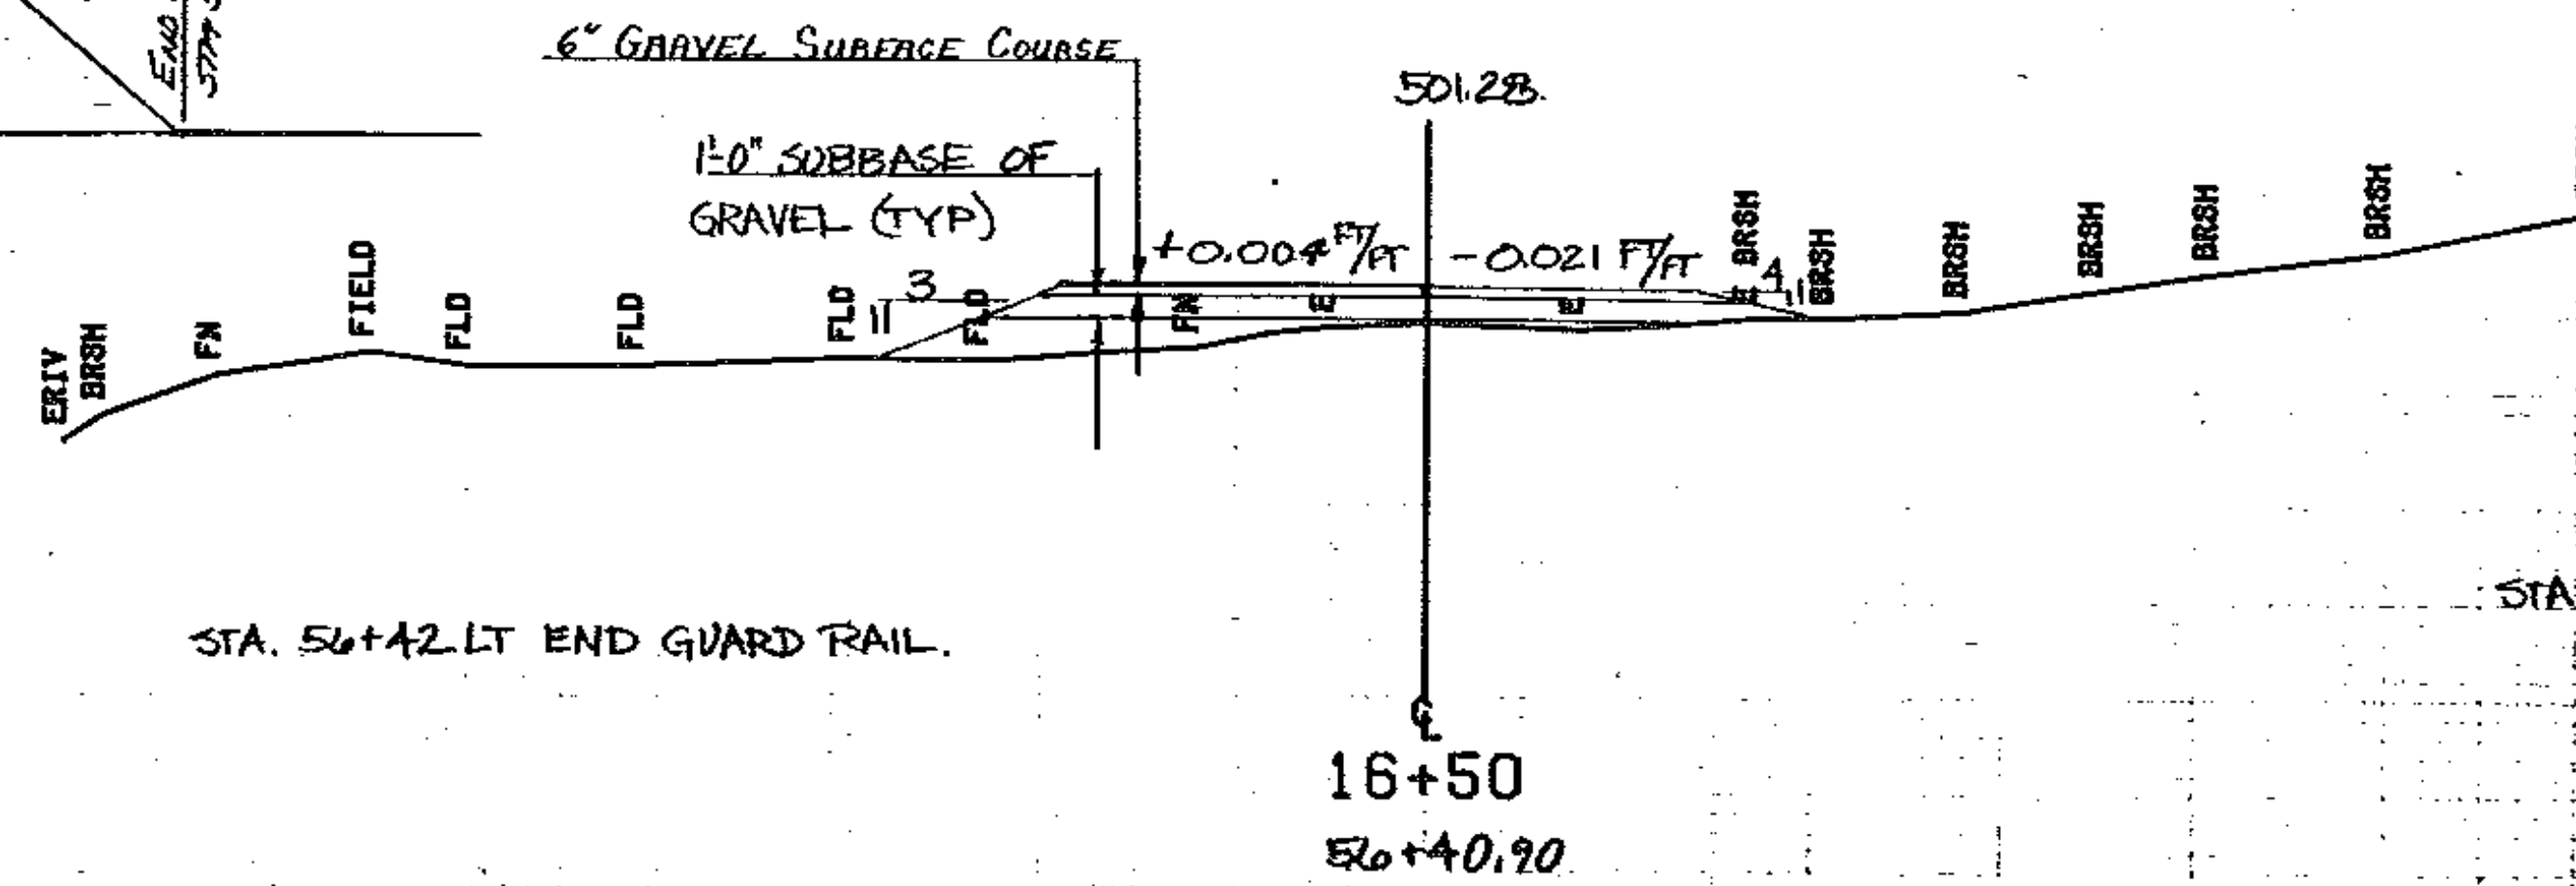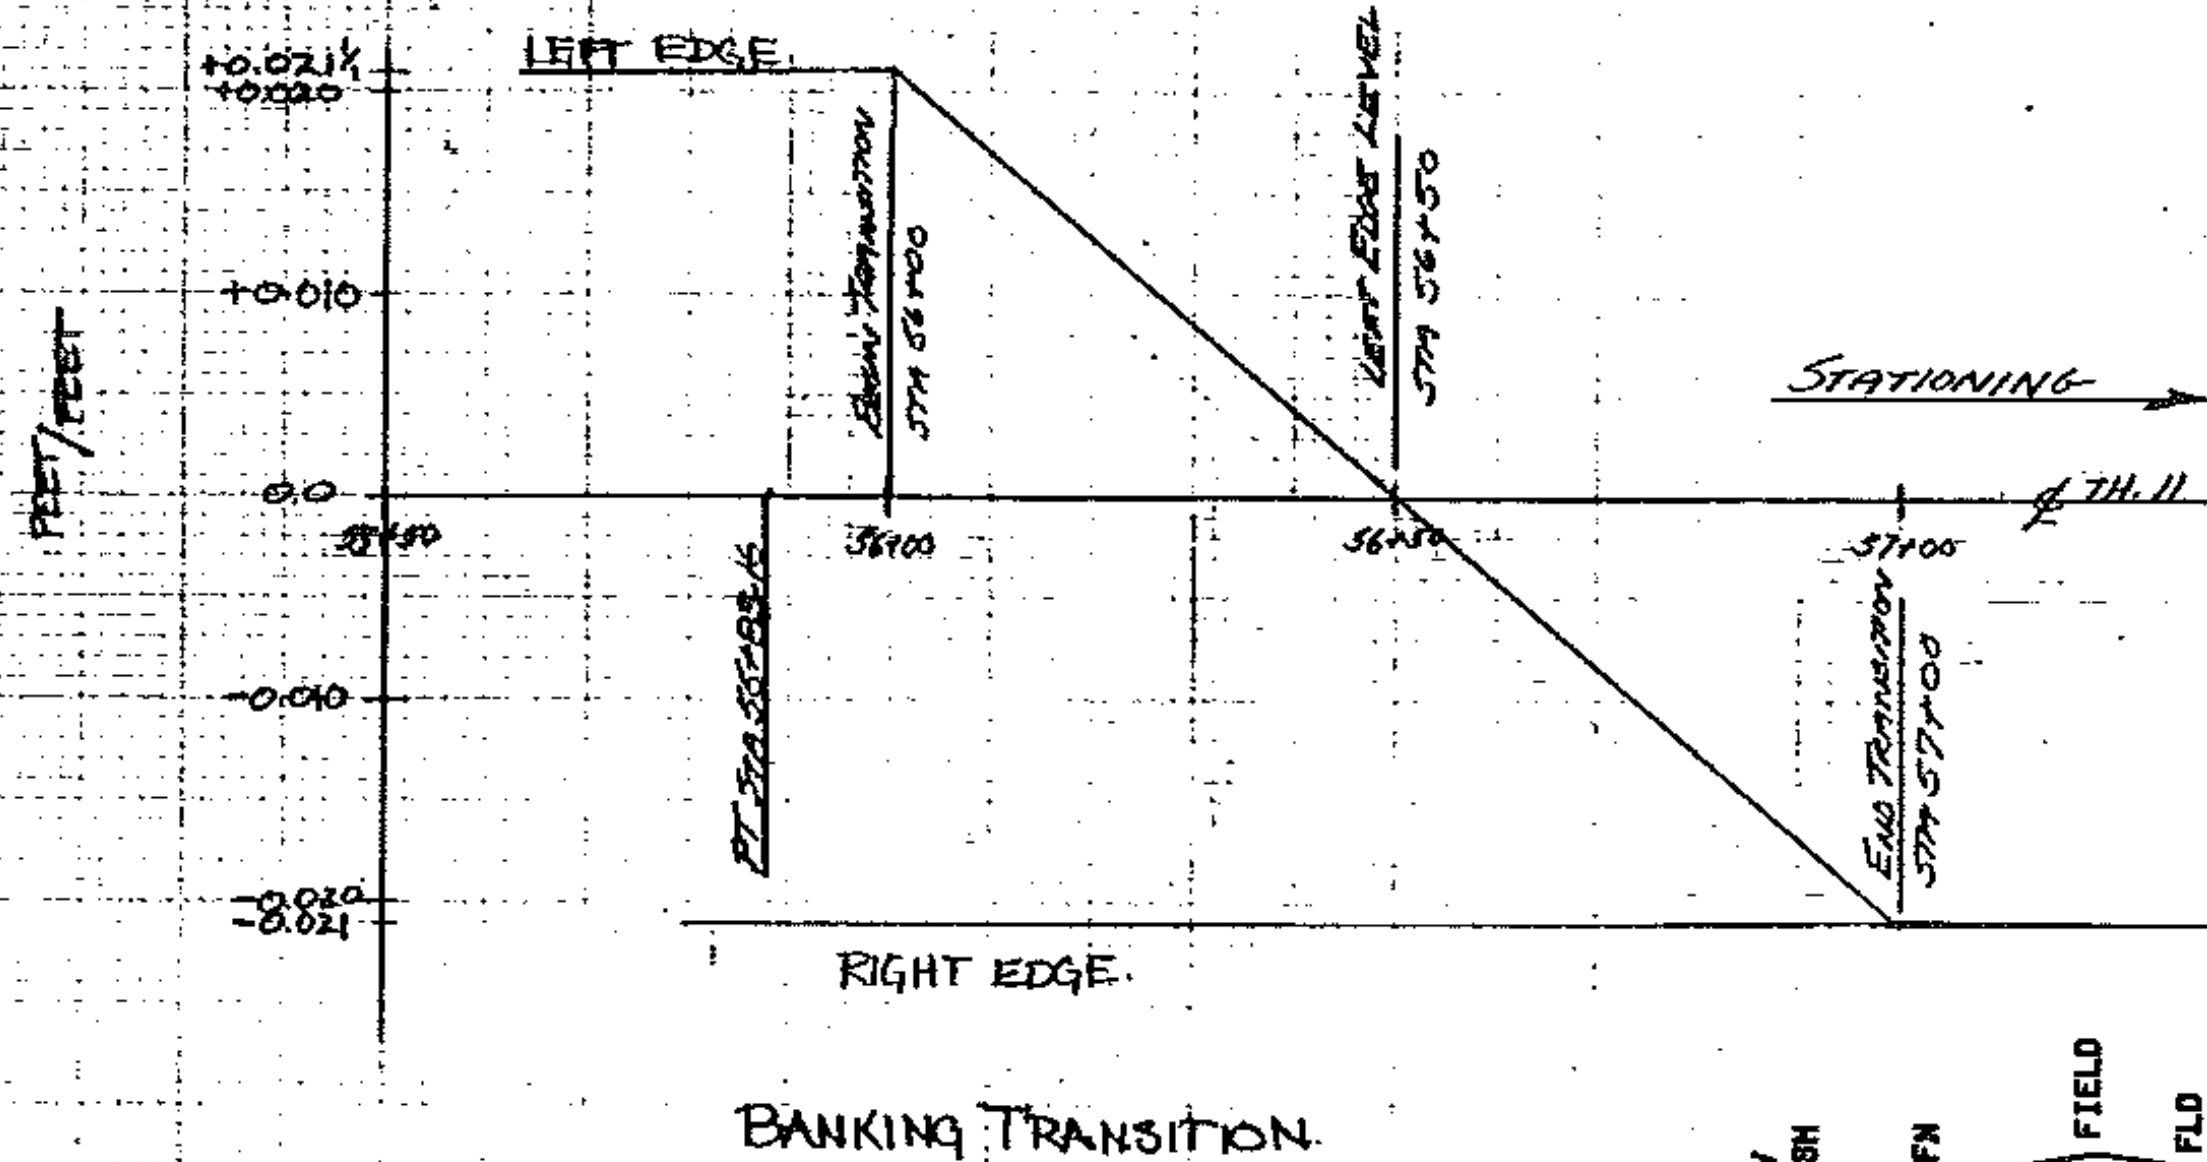

STA. 56+42 LT END GUARD RAIL.

STA. 56+34
E PVI VERTICAL CURVE No. 2
FVC VERTICAL CURVE No. 3

490

FROM STA. 16+80	TO STA. 17+50
PROJECT NAME CONCORD MAIN	NO. BR21447(10)
SURVEYED BY BAROENT	PLOTTED 11/15/82
SHEET 18 OF 27 SHEETS	JANUARY 1982

SCALE 1" = 10 FEET