



490

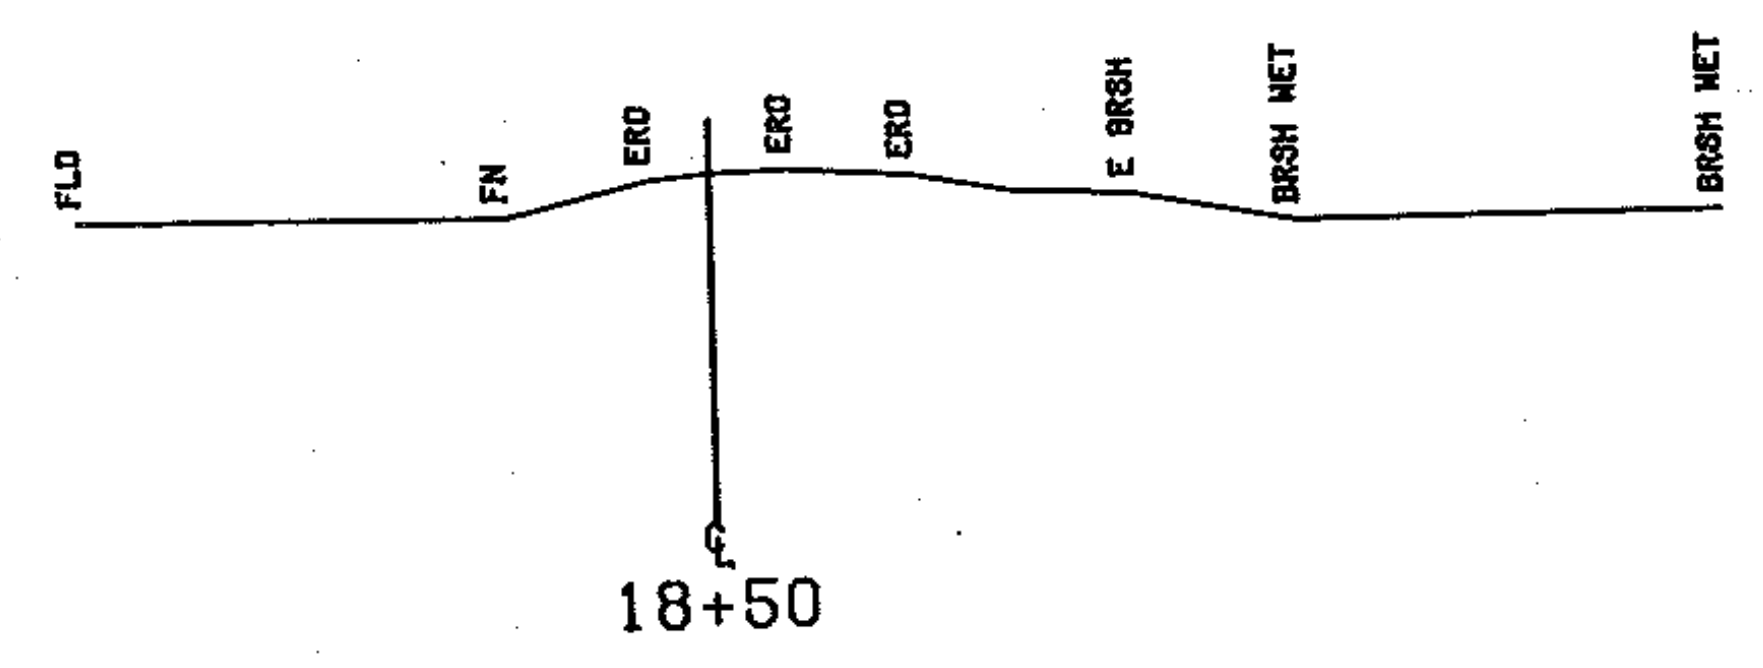

490

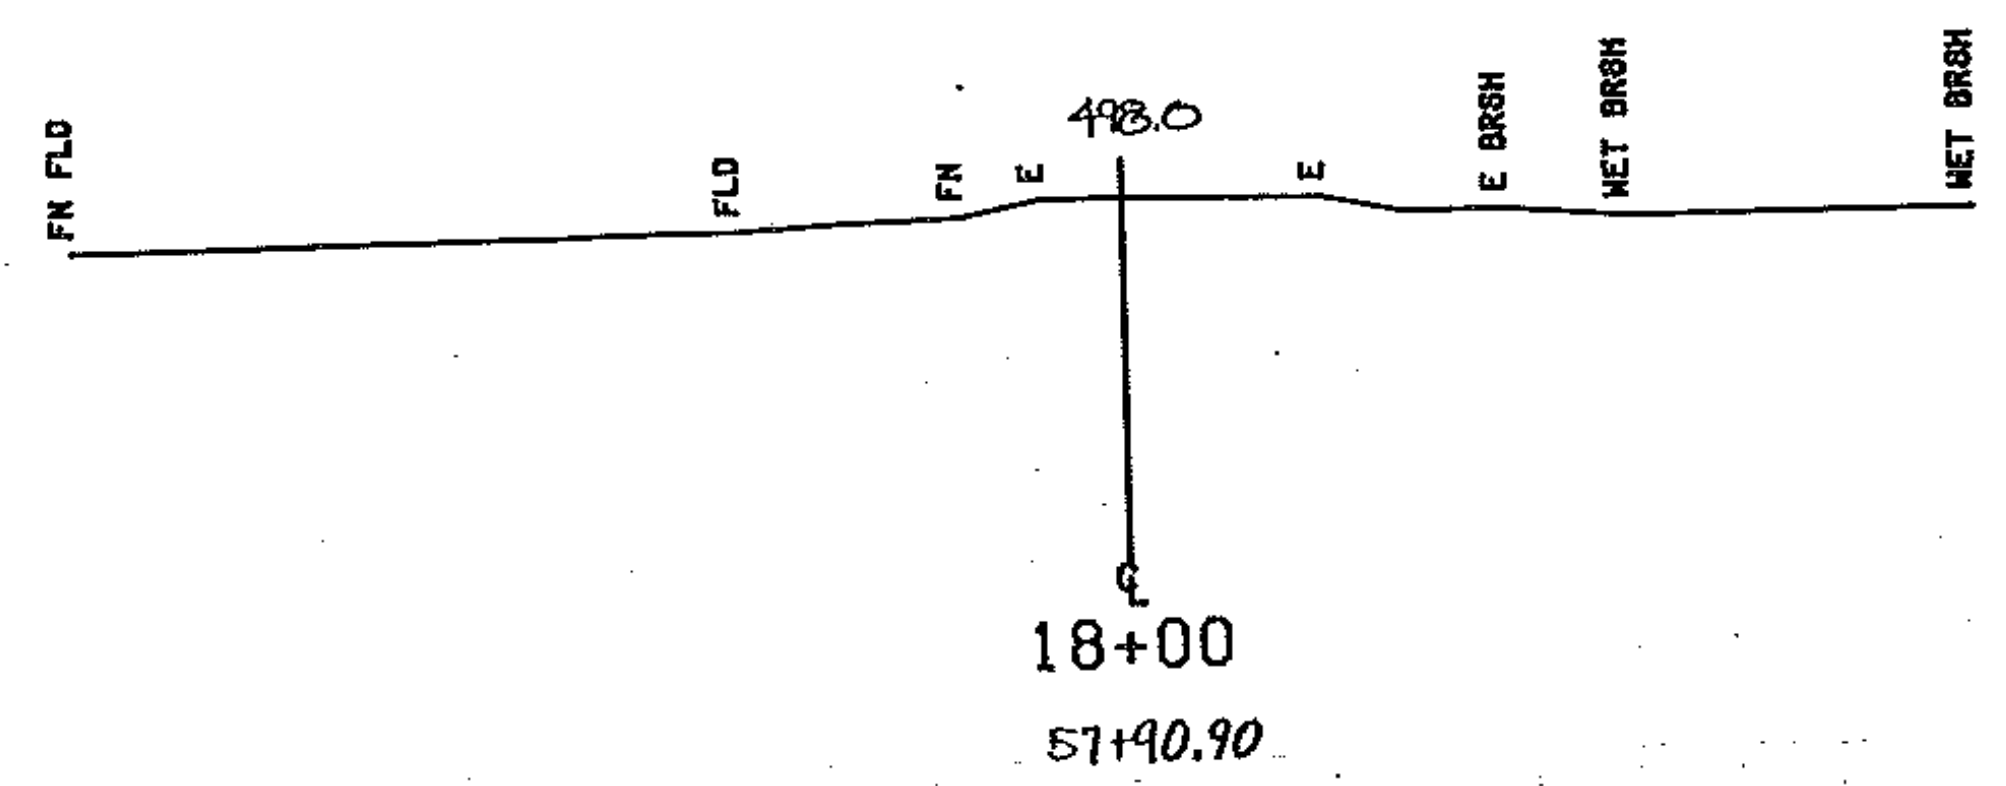

490

FROM STA.	18+00	TO STA.	19+00
PROJECT NAME	CONCORD MAIN		
NO.	BRZ1447(10)		
SURVEYED BY	SARGENT	PLOTTED	11/15/82
SHEET 19	OF 29	SHEETS	JANUARY 1982

SCALE 1" = 10 FEET