



490

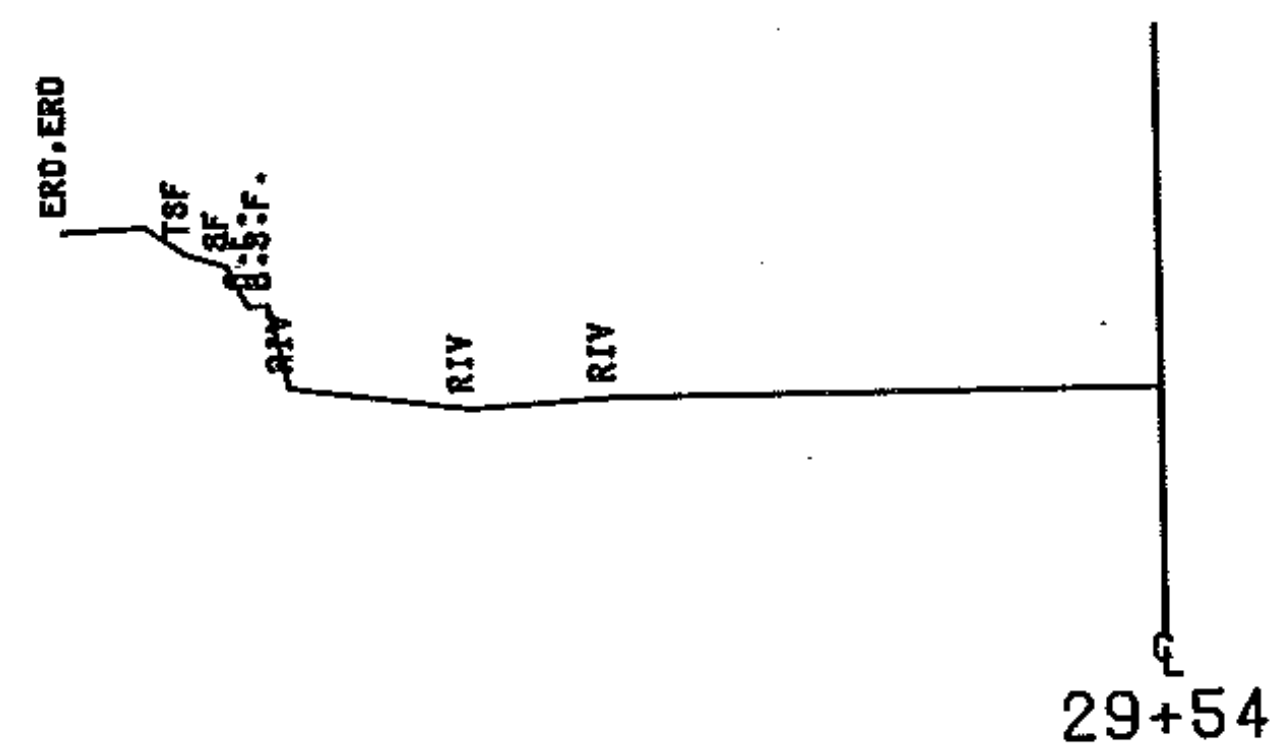

490

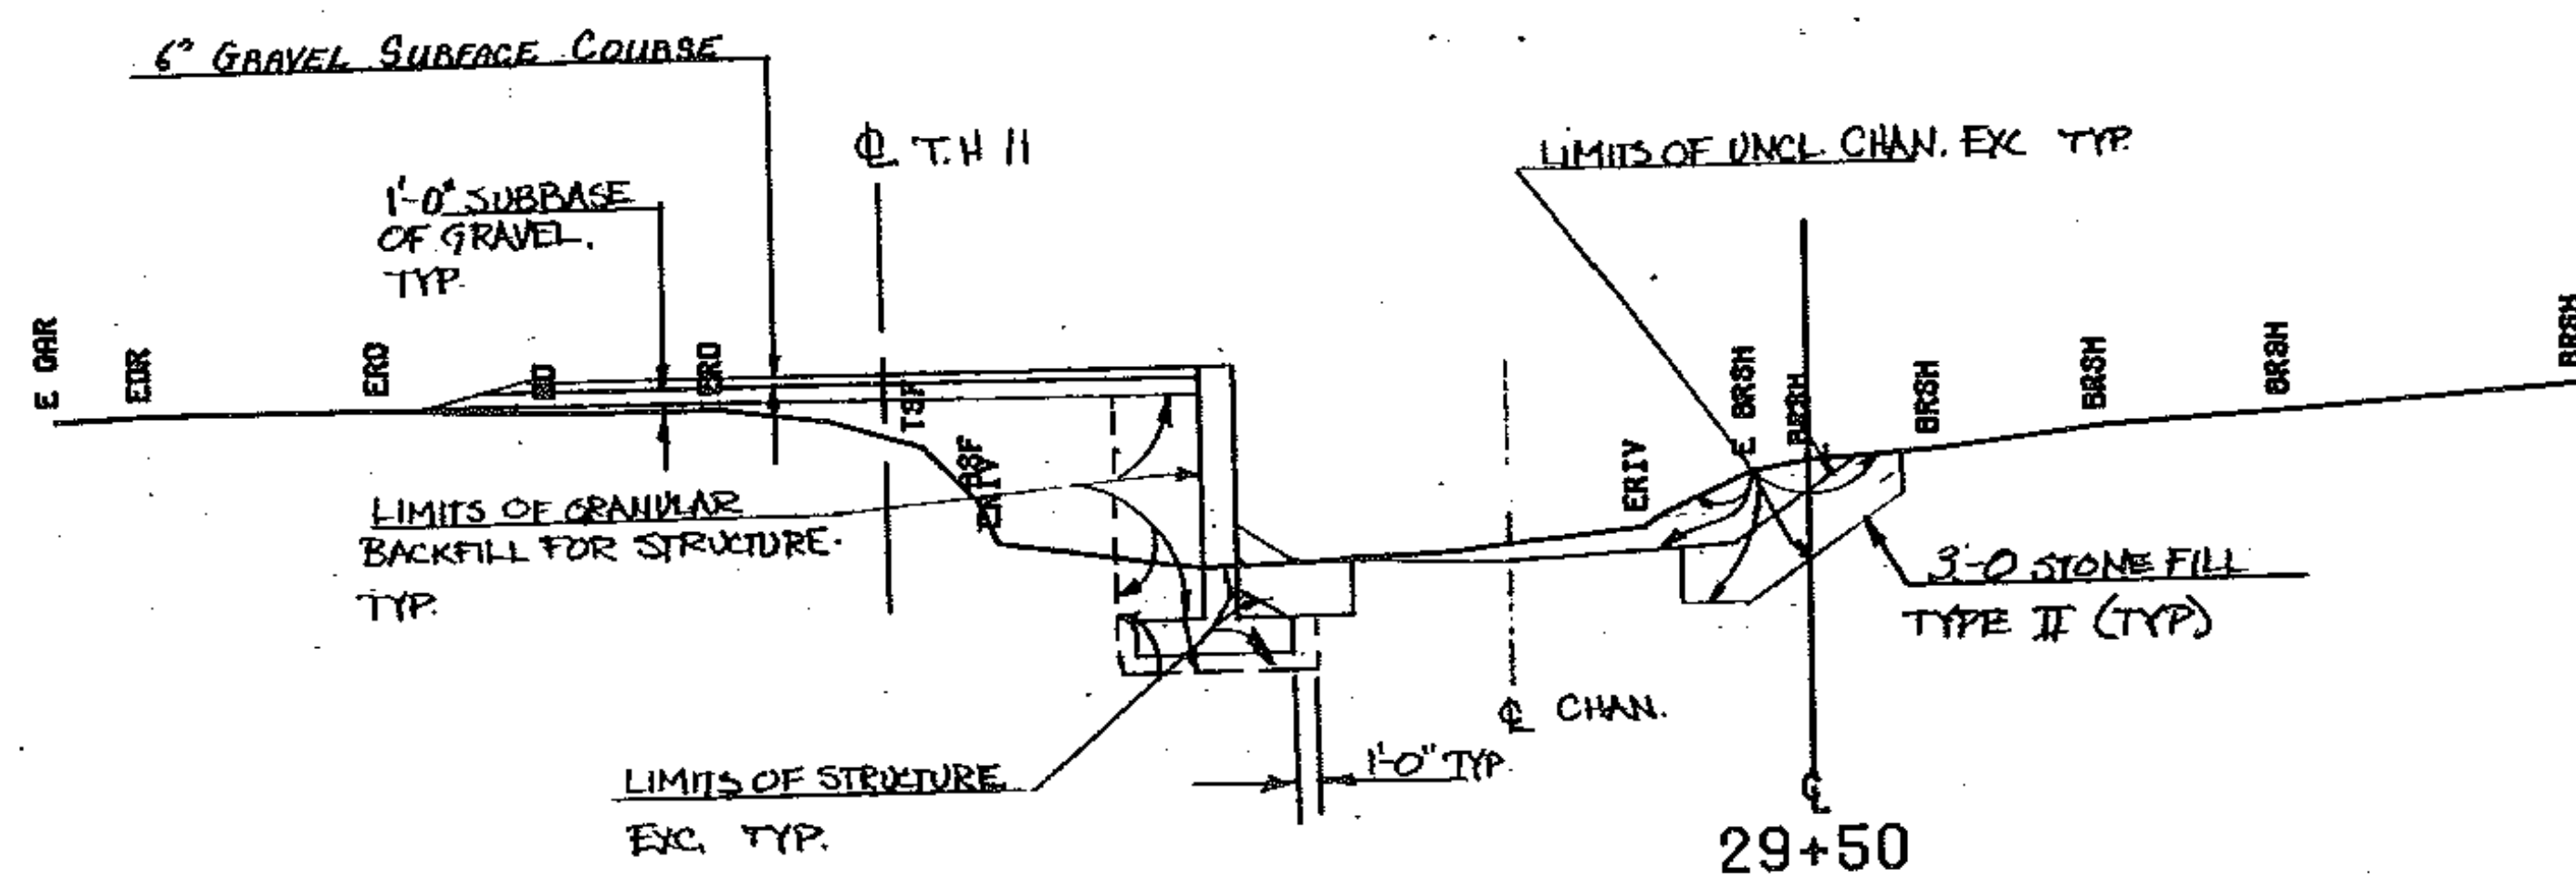

490

FROM STA. 29+50 TO STA. 29+54.10
PROJECT NAME CONCORD CHAN
NO. BRZ1447(10) PLOTTED 11/16/02
SURVEYED BY SARCENT JANUARY 1982
SHEET 22 OF 22 SHEETS

SCALE 10 FEET