

SUR. CURVE #2
 $\Delta = 41^\circ 56' \text{ LT.}$
 $D = 47'$
 $R = 121.91$
 $T = 46.71$
 $E = 8.64$
 $L = 89.22$
 $\text{BANK} = 0.042 \text{ FT.}$

ORIGINAL SURVEY CURVE No. 2
 $\Delta = 75^\circ 15' 30'' \text{ LT.}$
 $D = 74^\circ 00'$
 $R = 77.43$
 $T = 59.69$
 $E = 20.34$
 $L = 101.70$



ORIGINAL SURVEY CURVE No. 1
 $\Delta = 78^\circ 04' 30'' \text{ RT.}$
 $D = 78^\circ 00'$
 $R = 73.46$
 $T = 59.56$
 $E = 21.11$
 $L = 100.10$

BRIDGE RAILING - HEAVY DUTY STEEL BEAM
 LENGTH RT. 82.50 FT
 LENGTH LT. 82.50 FT

GUARD RAIL, HEAVY DUTY STEEL BEAM W/ WOOD POSTS, TYPE II.
 RT. BRG. STA 10+50 TO BRIDGE
 LT. BRG. STA 0+26 TO BRIDGE, 16' RND.
 LT. BRIDGE TO T.H. 9 STA. 15+00

ANCHORS FOR STEEL BEAM RAIL W/ WOOD POSTS @ OPENINGS.
 T.H. 9 STA. 10+50 RT.
 T.H. 29 STA. 0+05 RT.
 T.H. 14 STA. 0+26 RT.
 T.H. 9 STA. 15+00 LT.

NOTE: ORIGINAL SURVEY BY TESSIER IN FEB 1983 FROM STA. 10+00 TO 15+00
 REVISED LINE SURVEYED BY FANTONI IN MAY 1984 STA. 11+20 TO 13+80

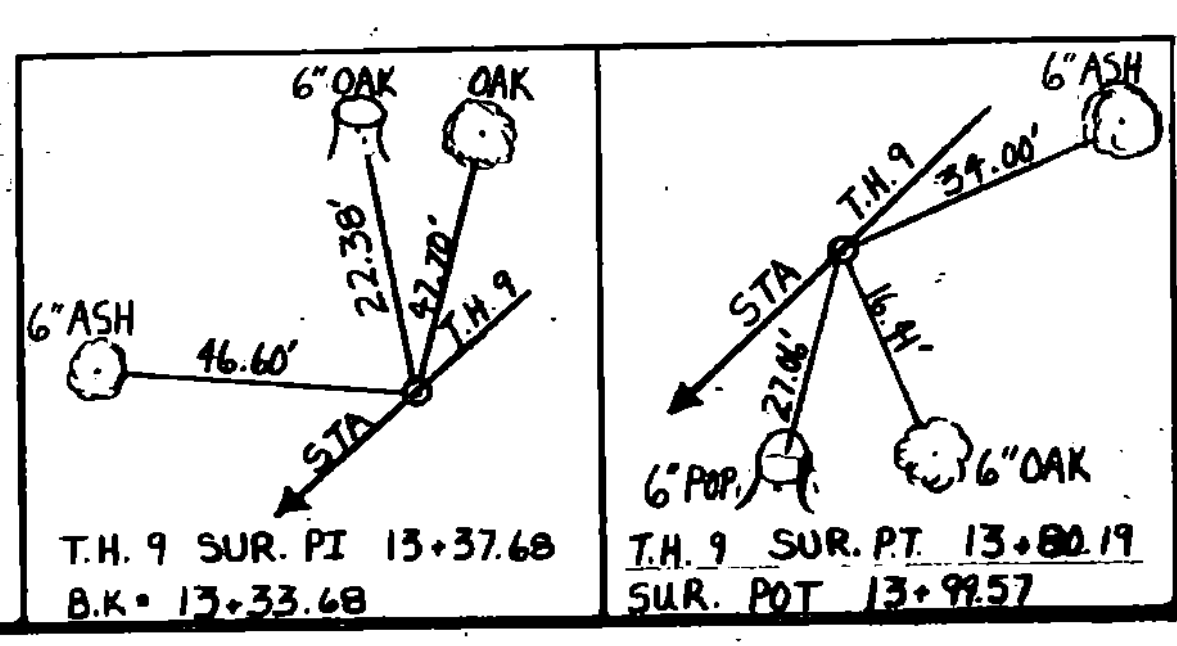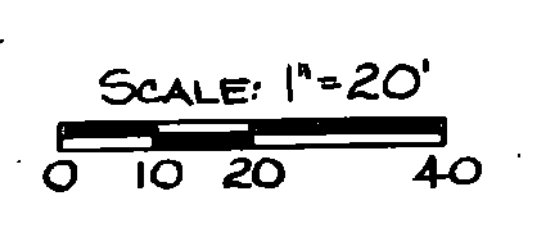

STATE OF VERMONT AGENCY OF TRANSPORTATION

TOWN OF	CHESTER	Bridge No.	67
HIGHWAY NO.	T.H. No. 9	Log Sta.	
		Surv. Sta.	12+53.5
T.H. No. 9 OVER WILLIAMS RIVER			
PLAN			
Designed by	R.P. Gendron	Drawn by	P.M. PELKEY
Checked by		Bridge Design Supervisor	
		EL. Oatley	date 11-86
PROJECT	CHESTER	PROJECT NO.	BRZ 1442(10)
Bridge Sheet No.		Sheet	3 of 28