


FOR ADDITIONAL DETAILS SEE STD. SCB-D7-71 DETAILS 'C' & 'D'

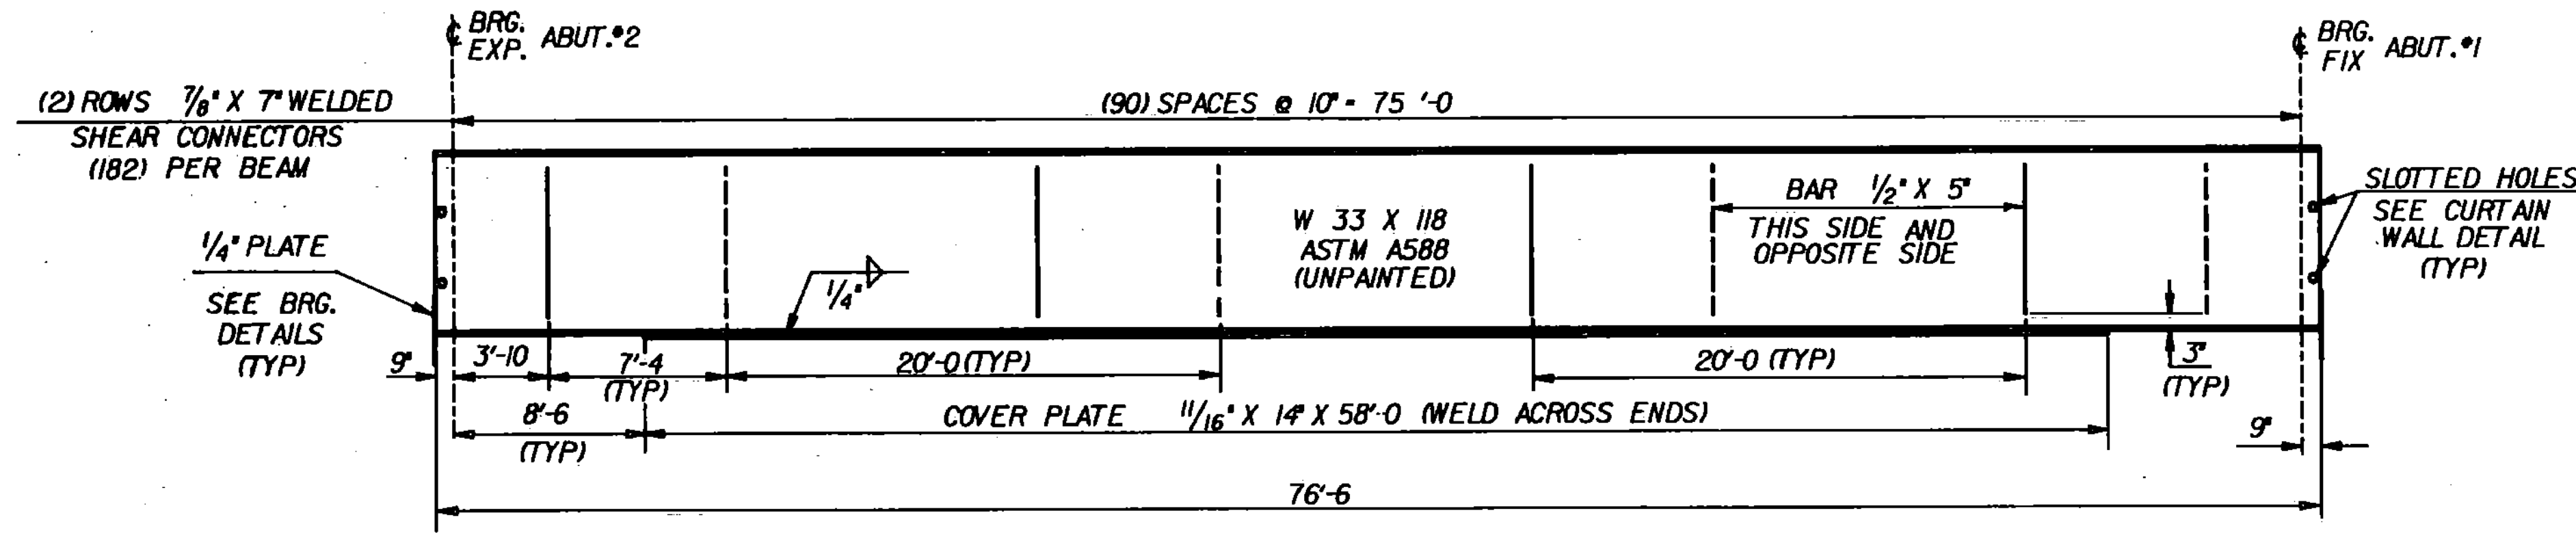

<b>STATE OF VERMONT</b>		<b>AGENCY OF TRANSPORTATION</b>	
Town of	CHESTER	Bridge No.	67
Highway No.	CLASS 3, TH 9	Loc. Sta.	
		Surv. Sta.	12+50
TH 9 OVER WILLIAMS RIVER			
FRAMING PLAN			
Designed By	B. GENDRON	Drawn By	M. GERUTTI
Checked By		Bridge Design Supervisor	
		Date	10-18-86
			R. L. O'Leary Date 11-86
PROJECT	CHESTER	PROJECT NO.	BBZ 1442(10)
L&C. Info.	OSAL3024753CARAEBM.DGN	CHESTER.M.PRE	
Bridge Sheet No.		Sheet	8 of 28