


PLAN ABUTMENT No. 1  
SCALE: 3/8" = 1'-0"

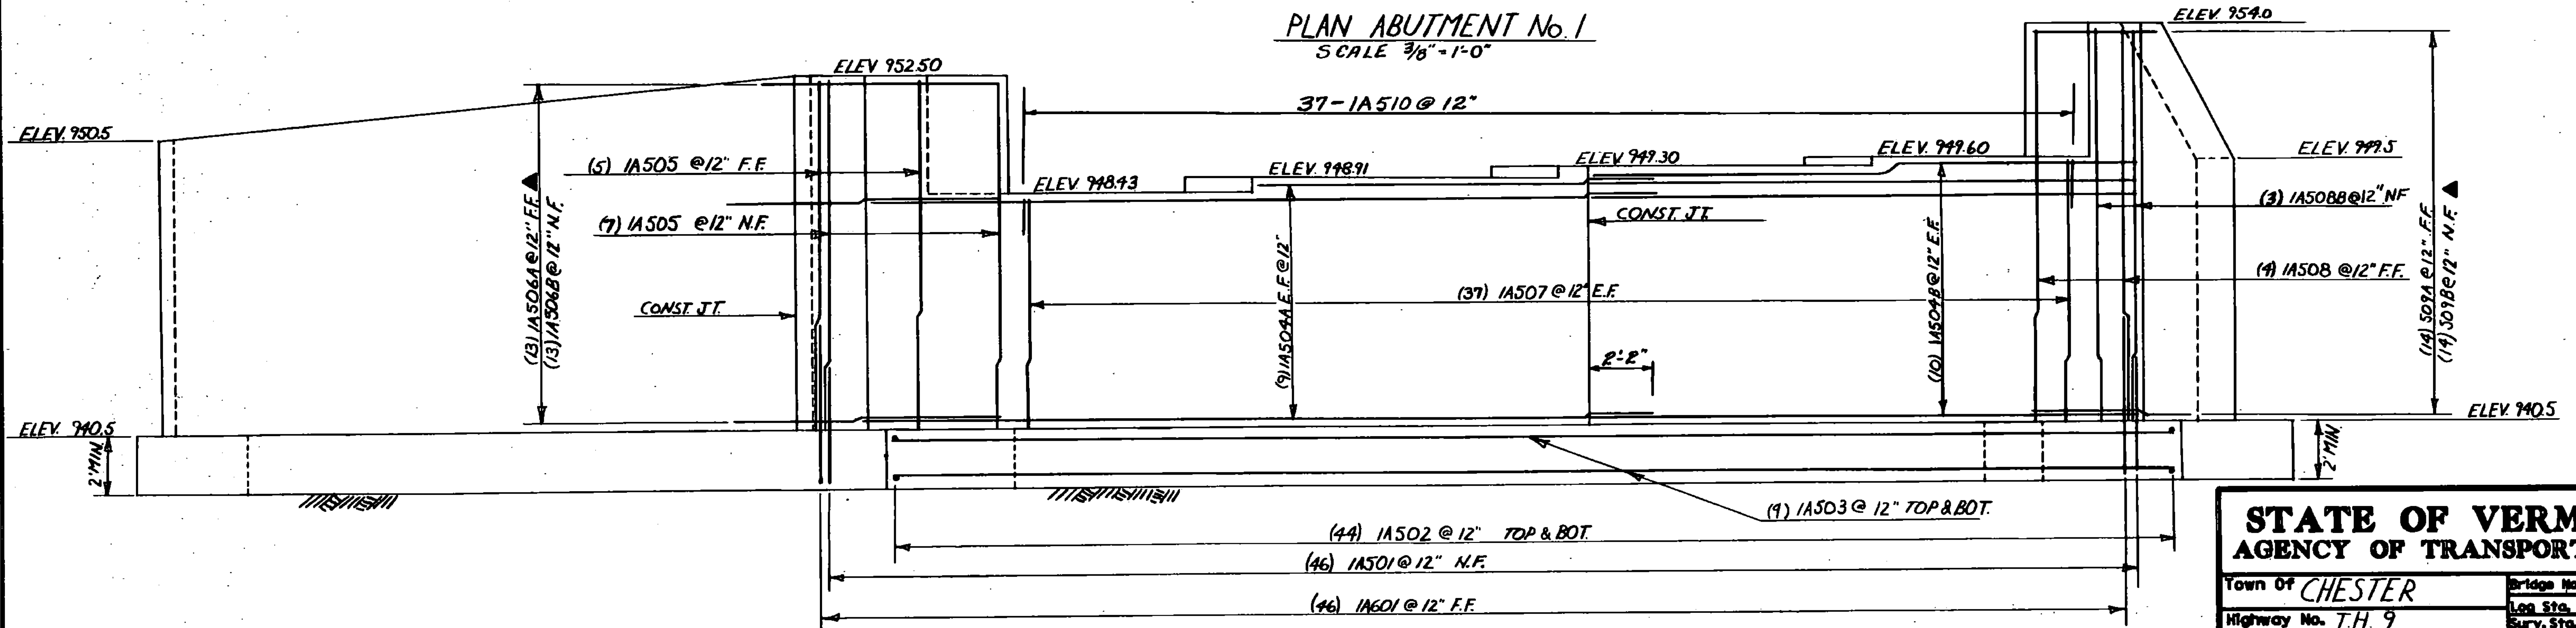

ELEVATION ABUTMENT No. 1  
SCALE: 3/8" = 1'-0"

▲ DENOTES BARS TO BE CUT IN FIELD

<b>STATE OF VERMONT AGENCY OF TRANSPORTATION</b>	
Town of <b>CHESTER</b>	Bridge No. <b>67</b>
Highway No. <b>T.H. 9</b>	Log Sta. Surv. Sta.
<b>TH. 9 OVER WILLIAMS RIVER</b>	
<b>PLAN &amp; ELEVATION ABUTMENT No. 1</b>	
Designed By <b>R.P. GENDRON</b>	Drawn By <b>T. SUMNER</b>
Checked By <b>R.P. GENDRON 10-20-86</b>	Bridge Design Supervisor Date <b>11-86</b>
PROJECT <b>CHESTER</b>	PROJECT NO. <b>BRZ-1442 (10)</b>
I&C Info.	
Bridge Sheet No.	Sheet <b>10</b> of <b>28</b>

DRAWING 44-222-6442

BR-4

10