

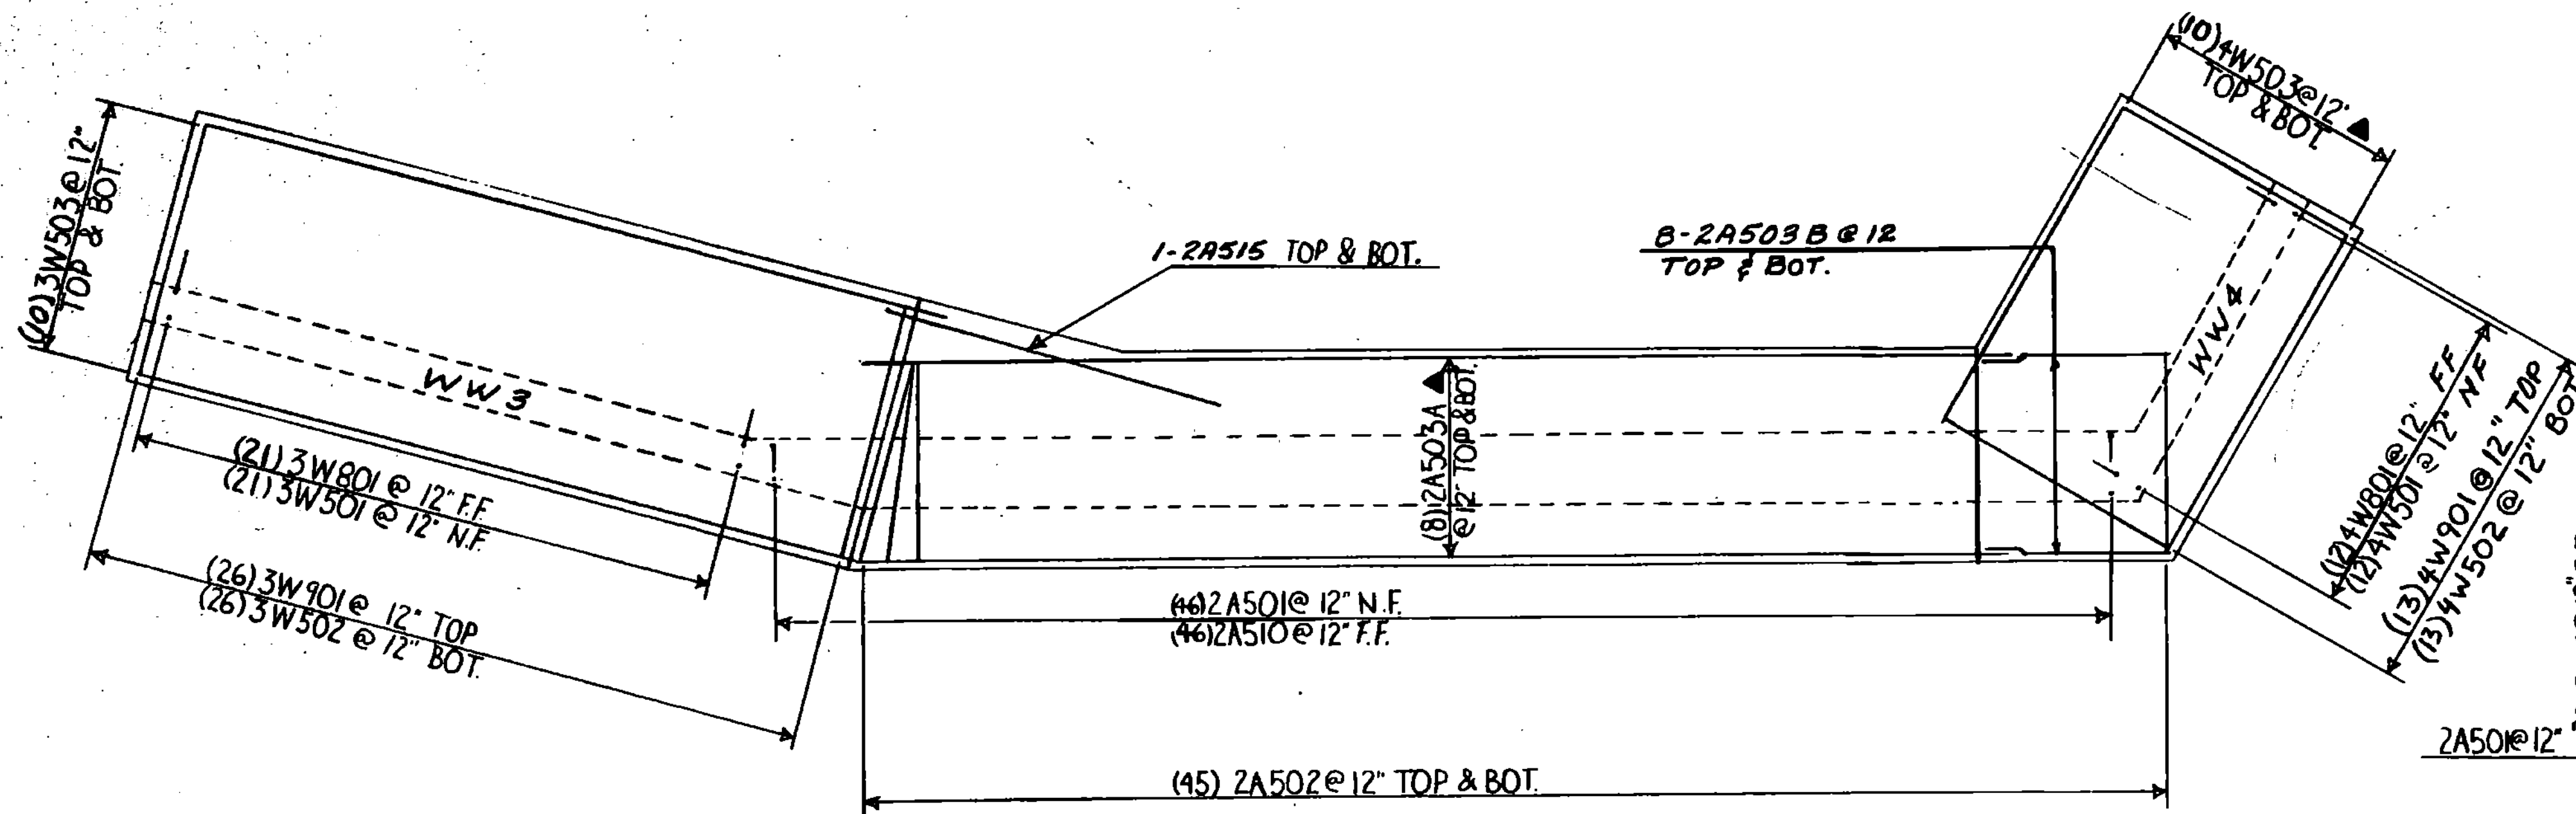



ABUTMENT No. 1  
FOOTING REINFORCEMENT PLAN  
SCALE: 1/4" = 1'-0"

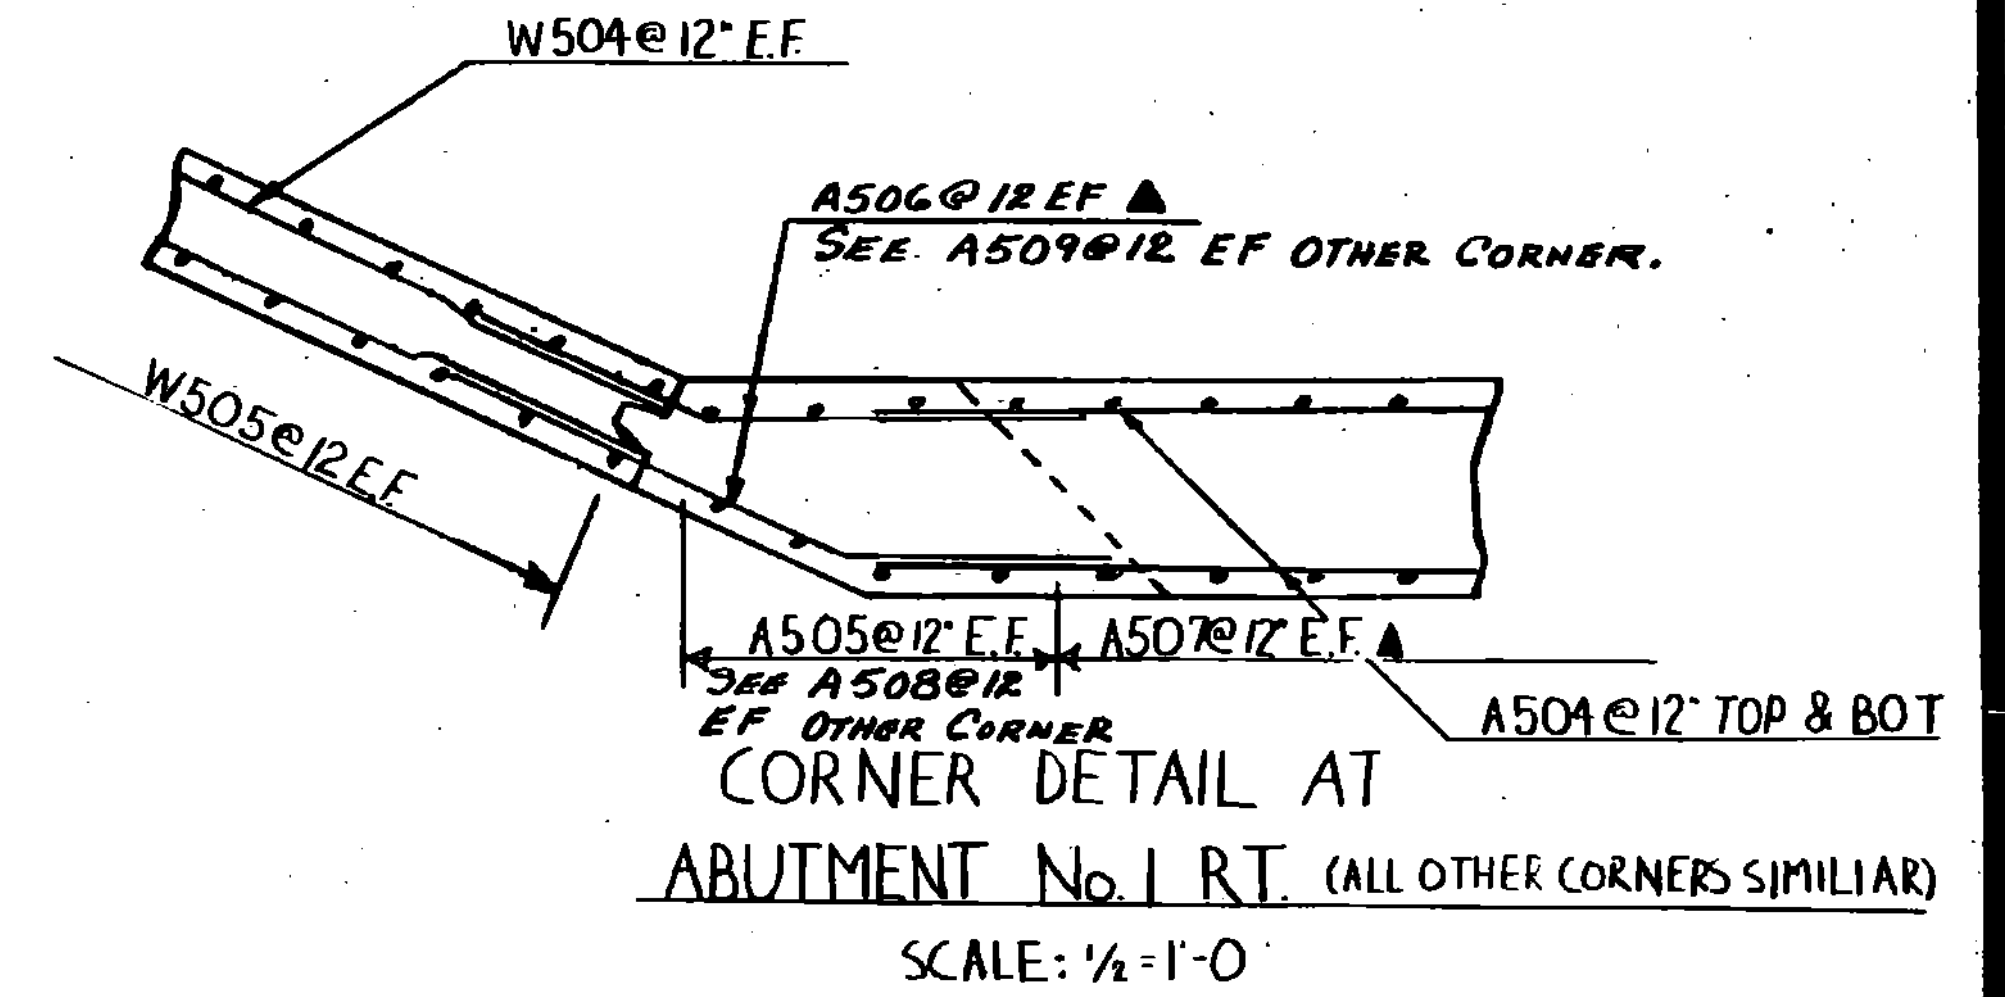

ABUTMENT No. 2  
FOOTING REINFORCEMENT PLAN  
SCALE: 1/4" = 1'-0"

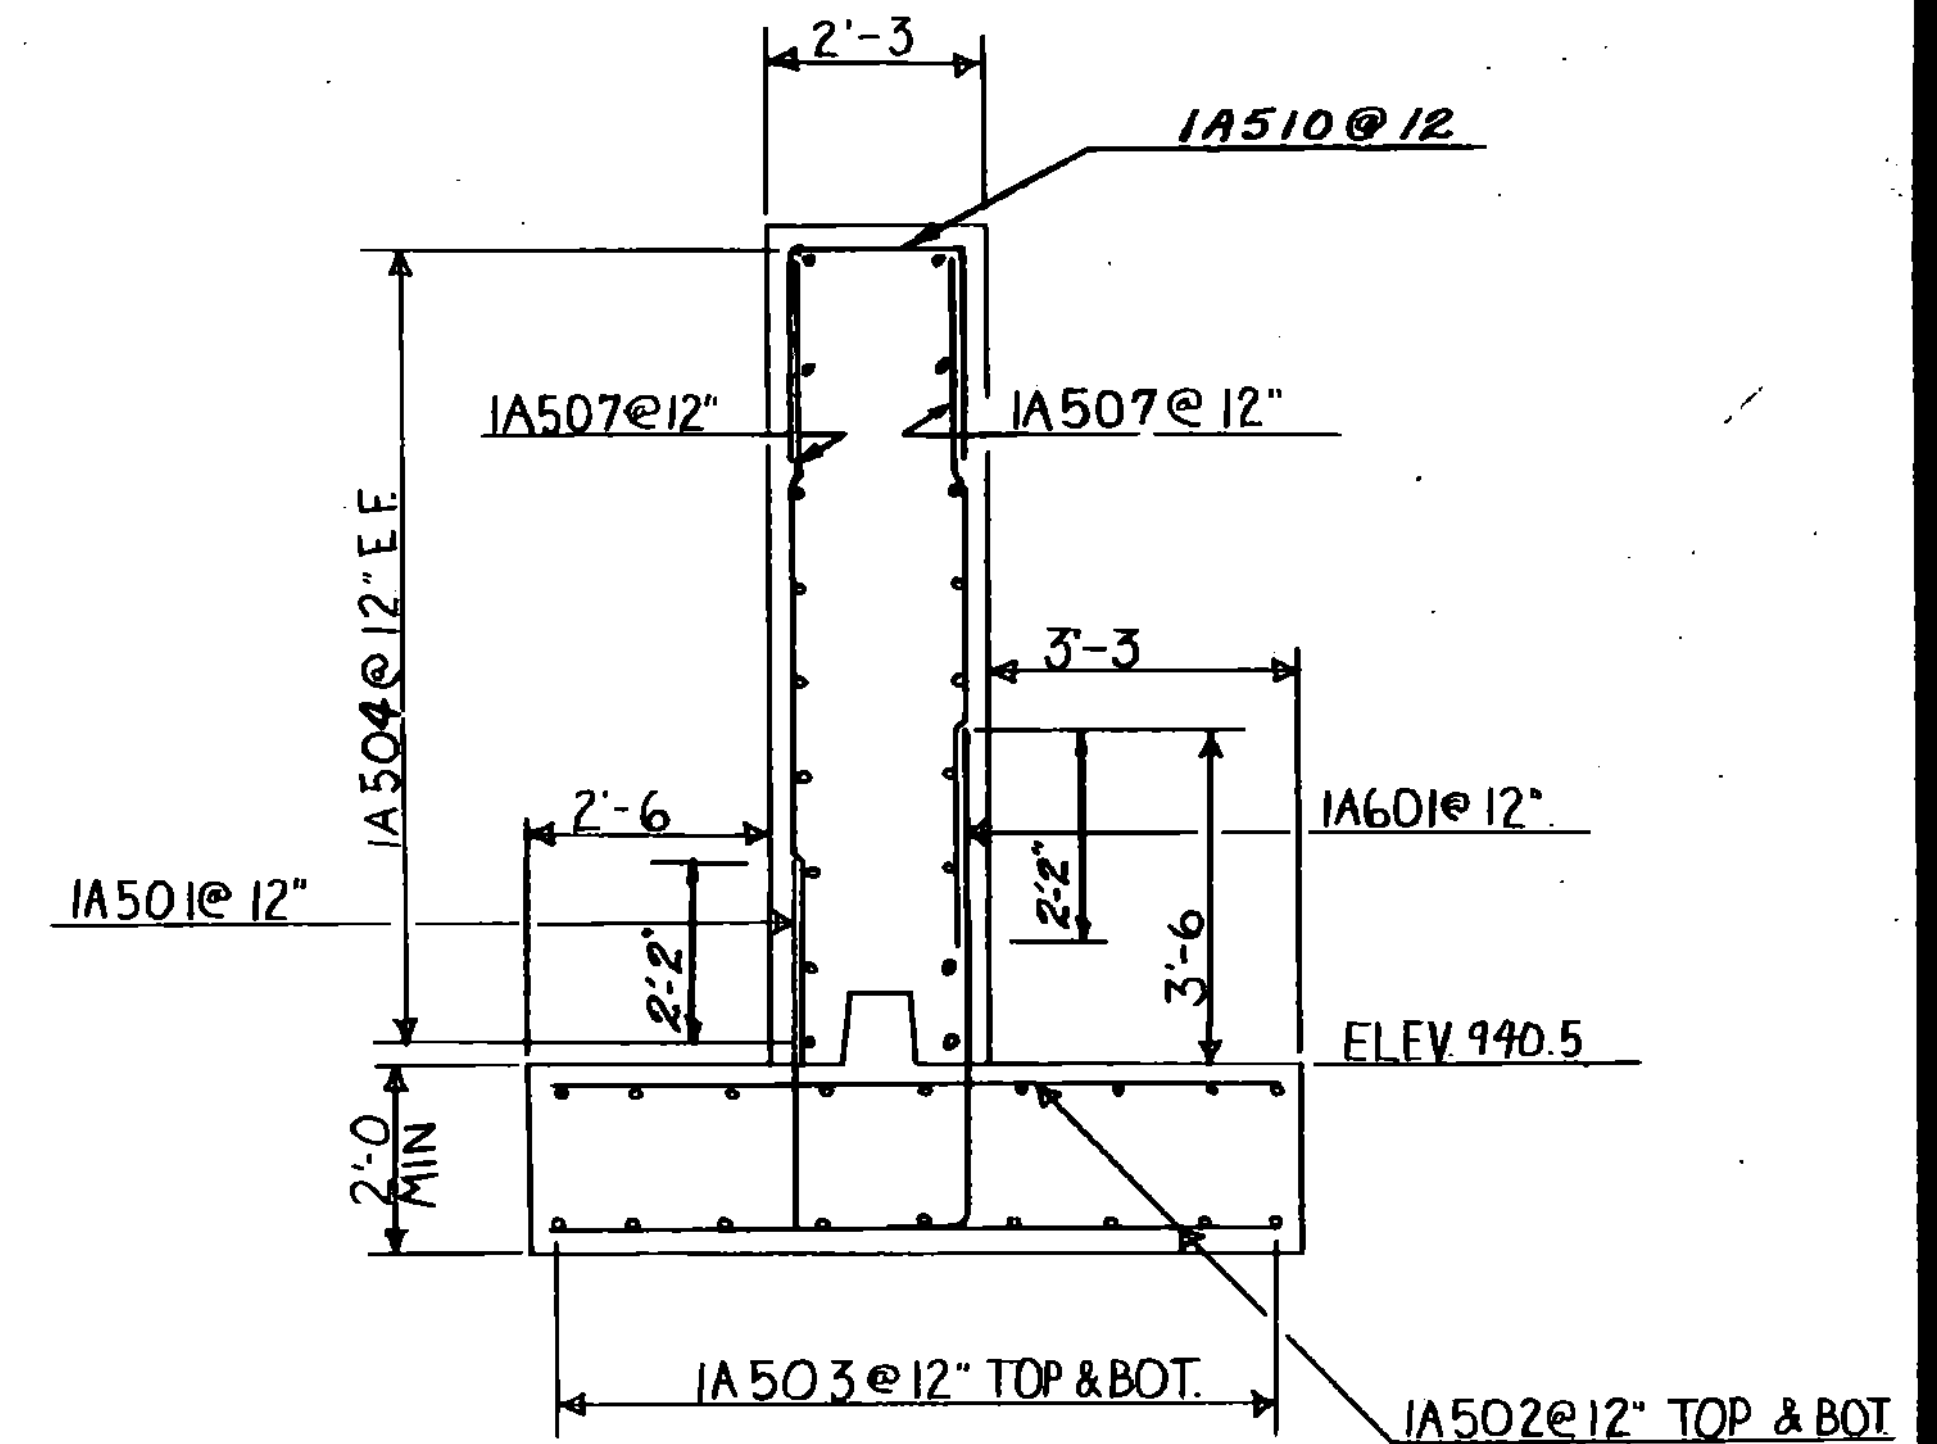

ABUTMENT No. 1  
TYPICAL SECTION  
SCALE: 1/2" = 1'-0"

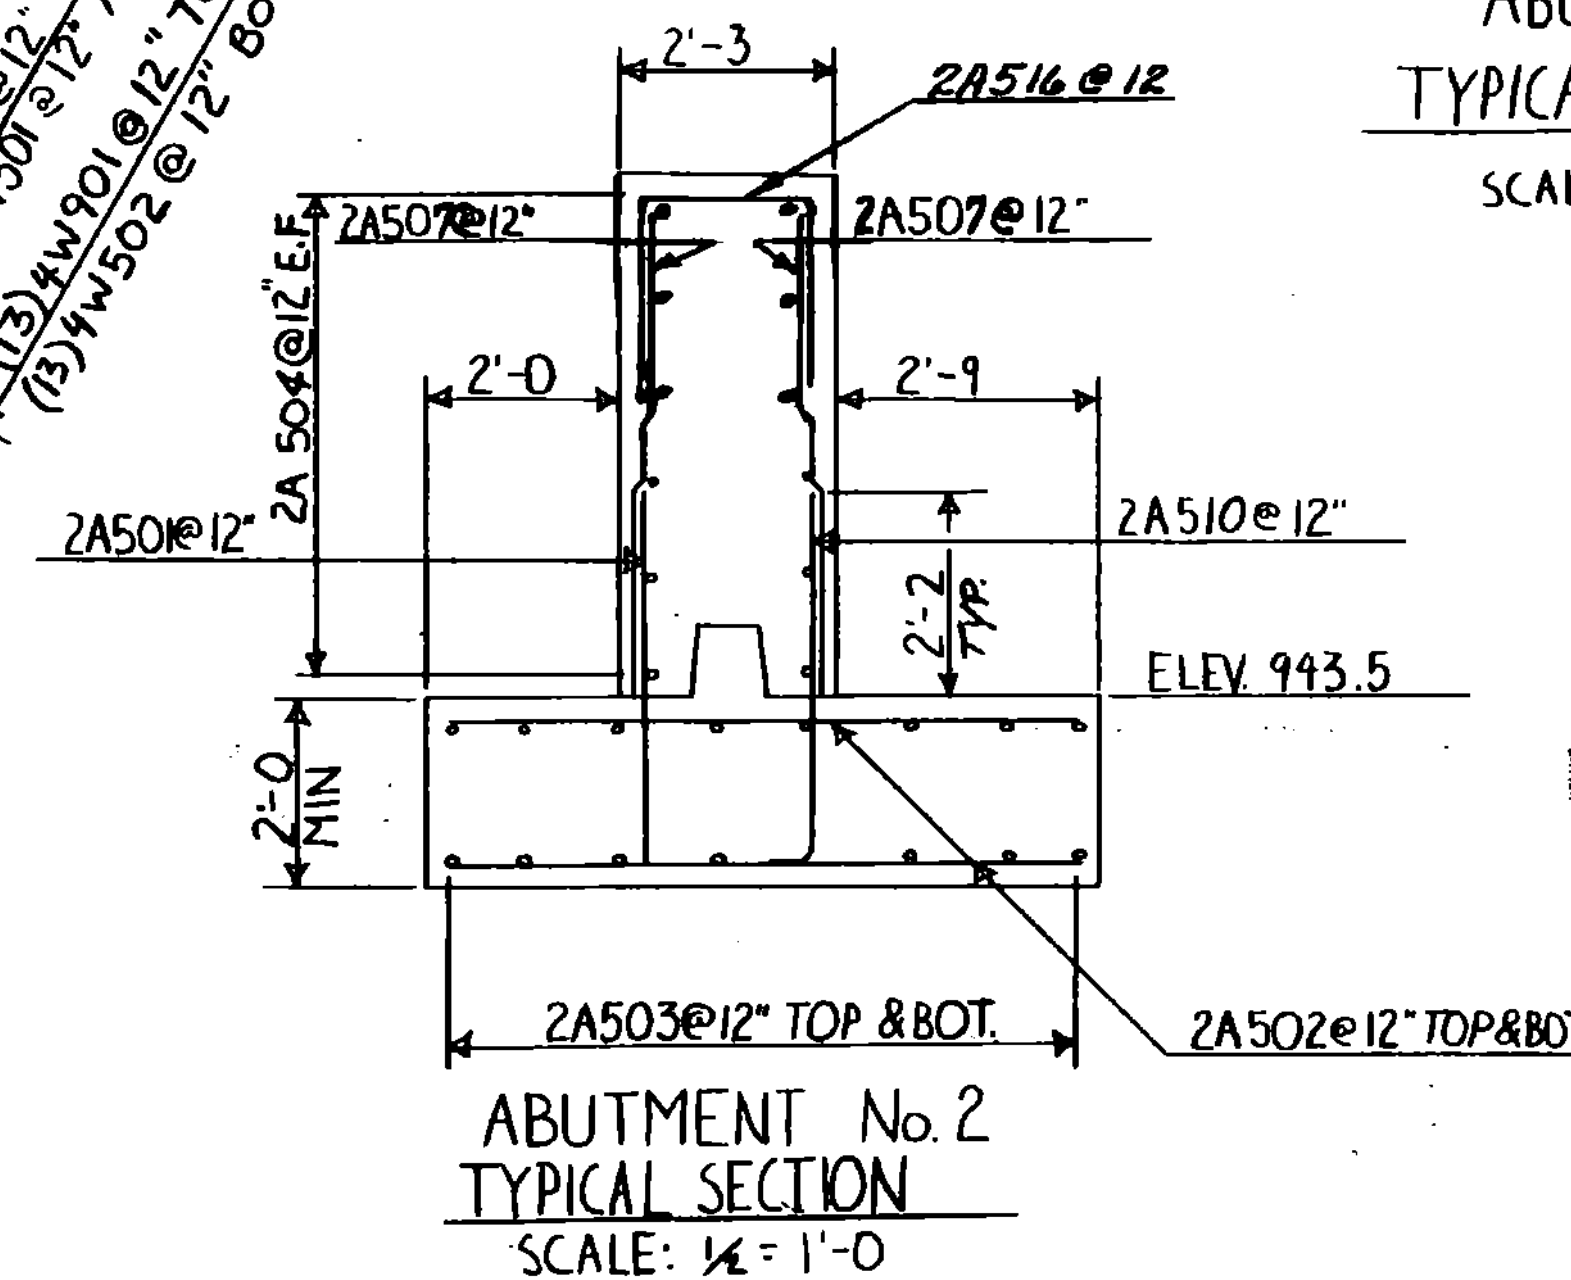

ABUTMENT No. 2  
TYPICAL SECTION  
SCALE: 1/2" = 1'-0"

<b>STATE OF VERMONT AGENCY OF TRANSPORTATION</b>	
Town Of CHESTER	Bridge No. 67
Highway No. T.H. No. 9	Log Sta.
T.H. No. 9 OVER WILLIAMS RIVER	
FOOTING REINFORCING PLAN & SECTION	
Designed By R.P. GENDRON	Drawn By T. SUMNER
Checked By R.P. GENDRON	Bridge Design Supervisor
Date 10-21-88	Date 11-88
PROJECT CHESTER	PROJECT NO. BRZ 1442(10)
I.O.C. Info.	
Bridge Sheet No.	Sheet 12 of 28.