



WINGWALL NO 2 ELEVATION

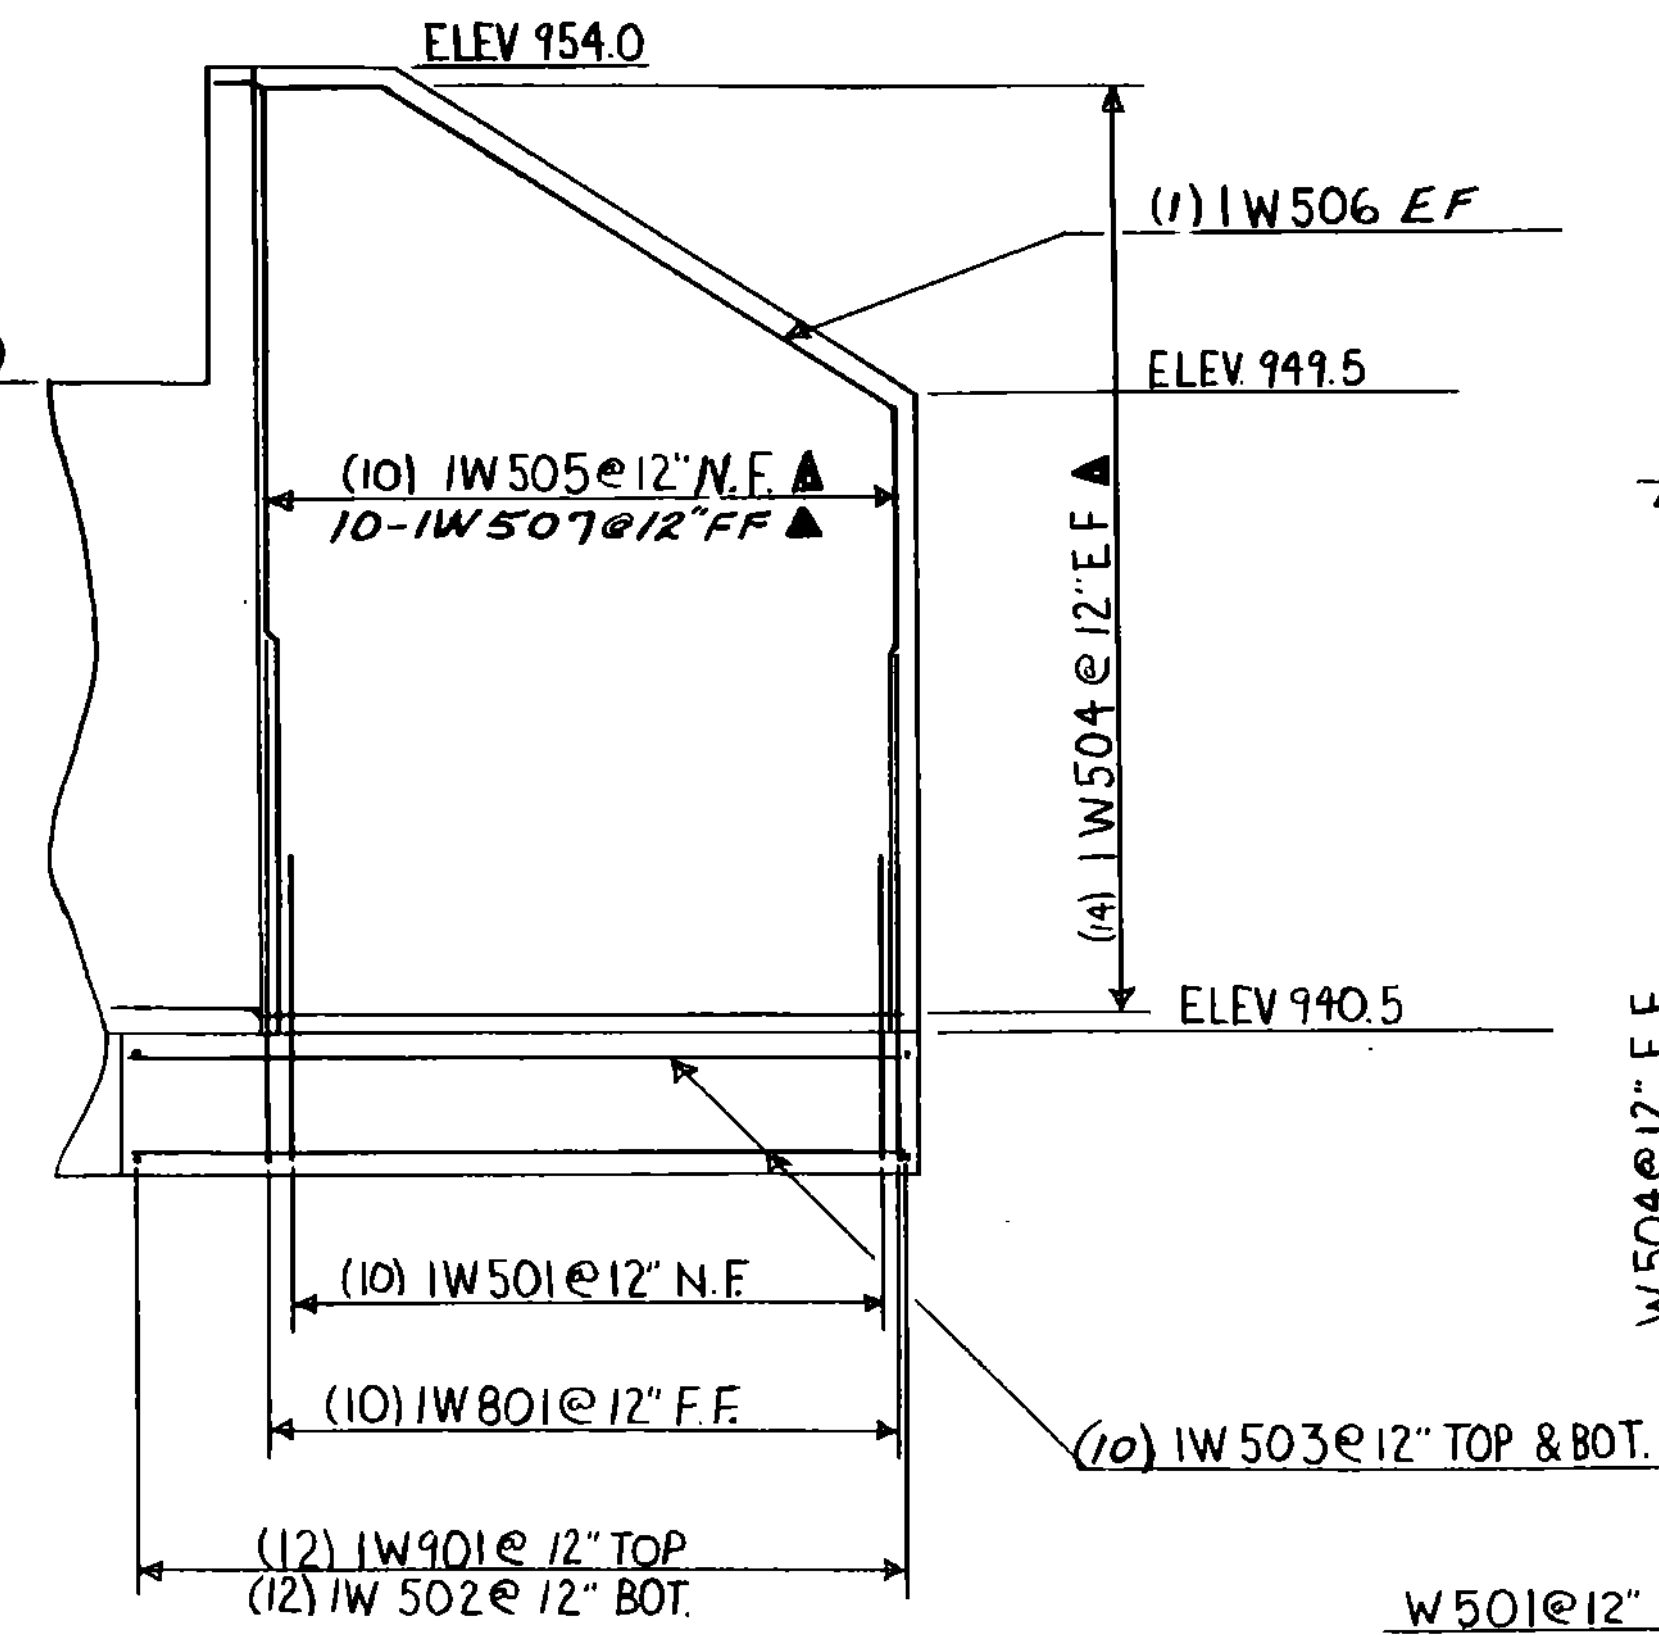


WINGWALL NO.1 ELEVATION

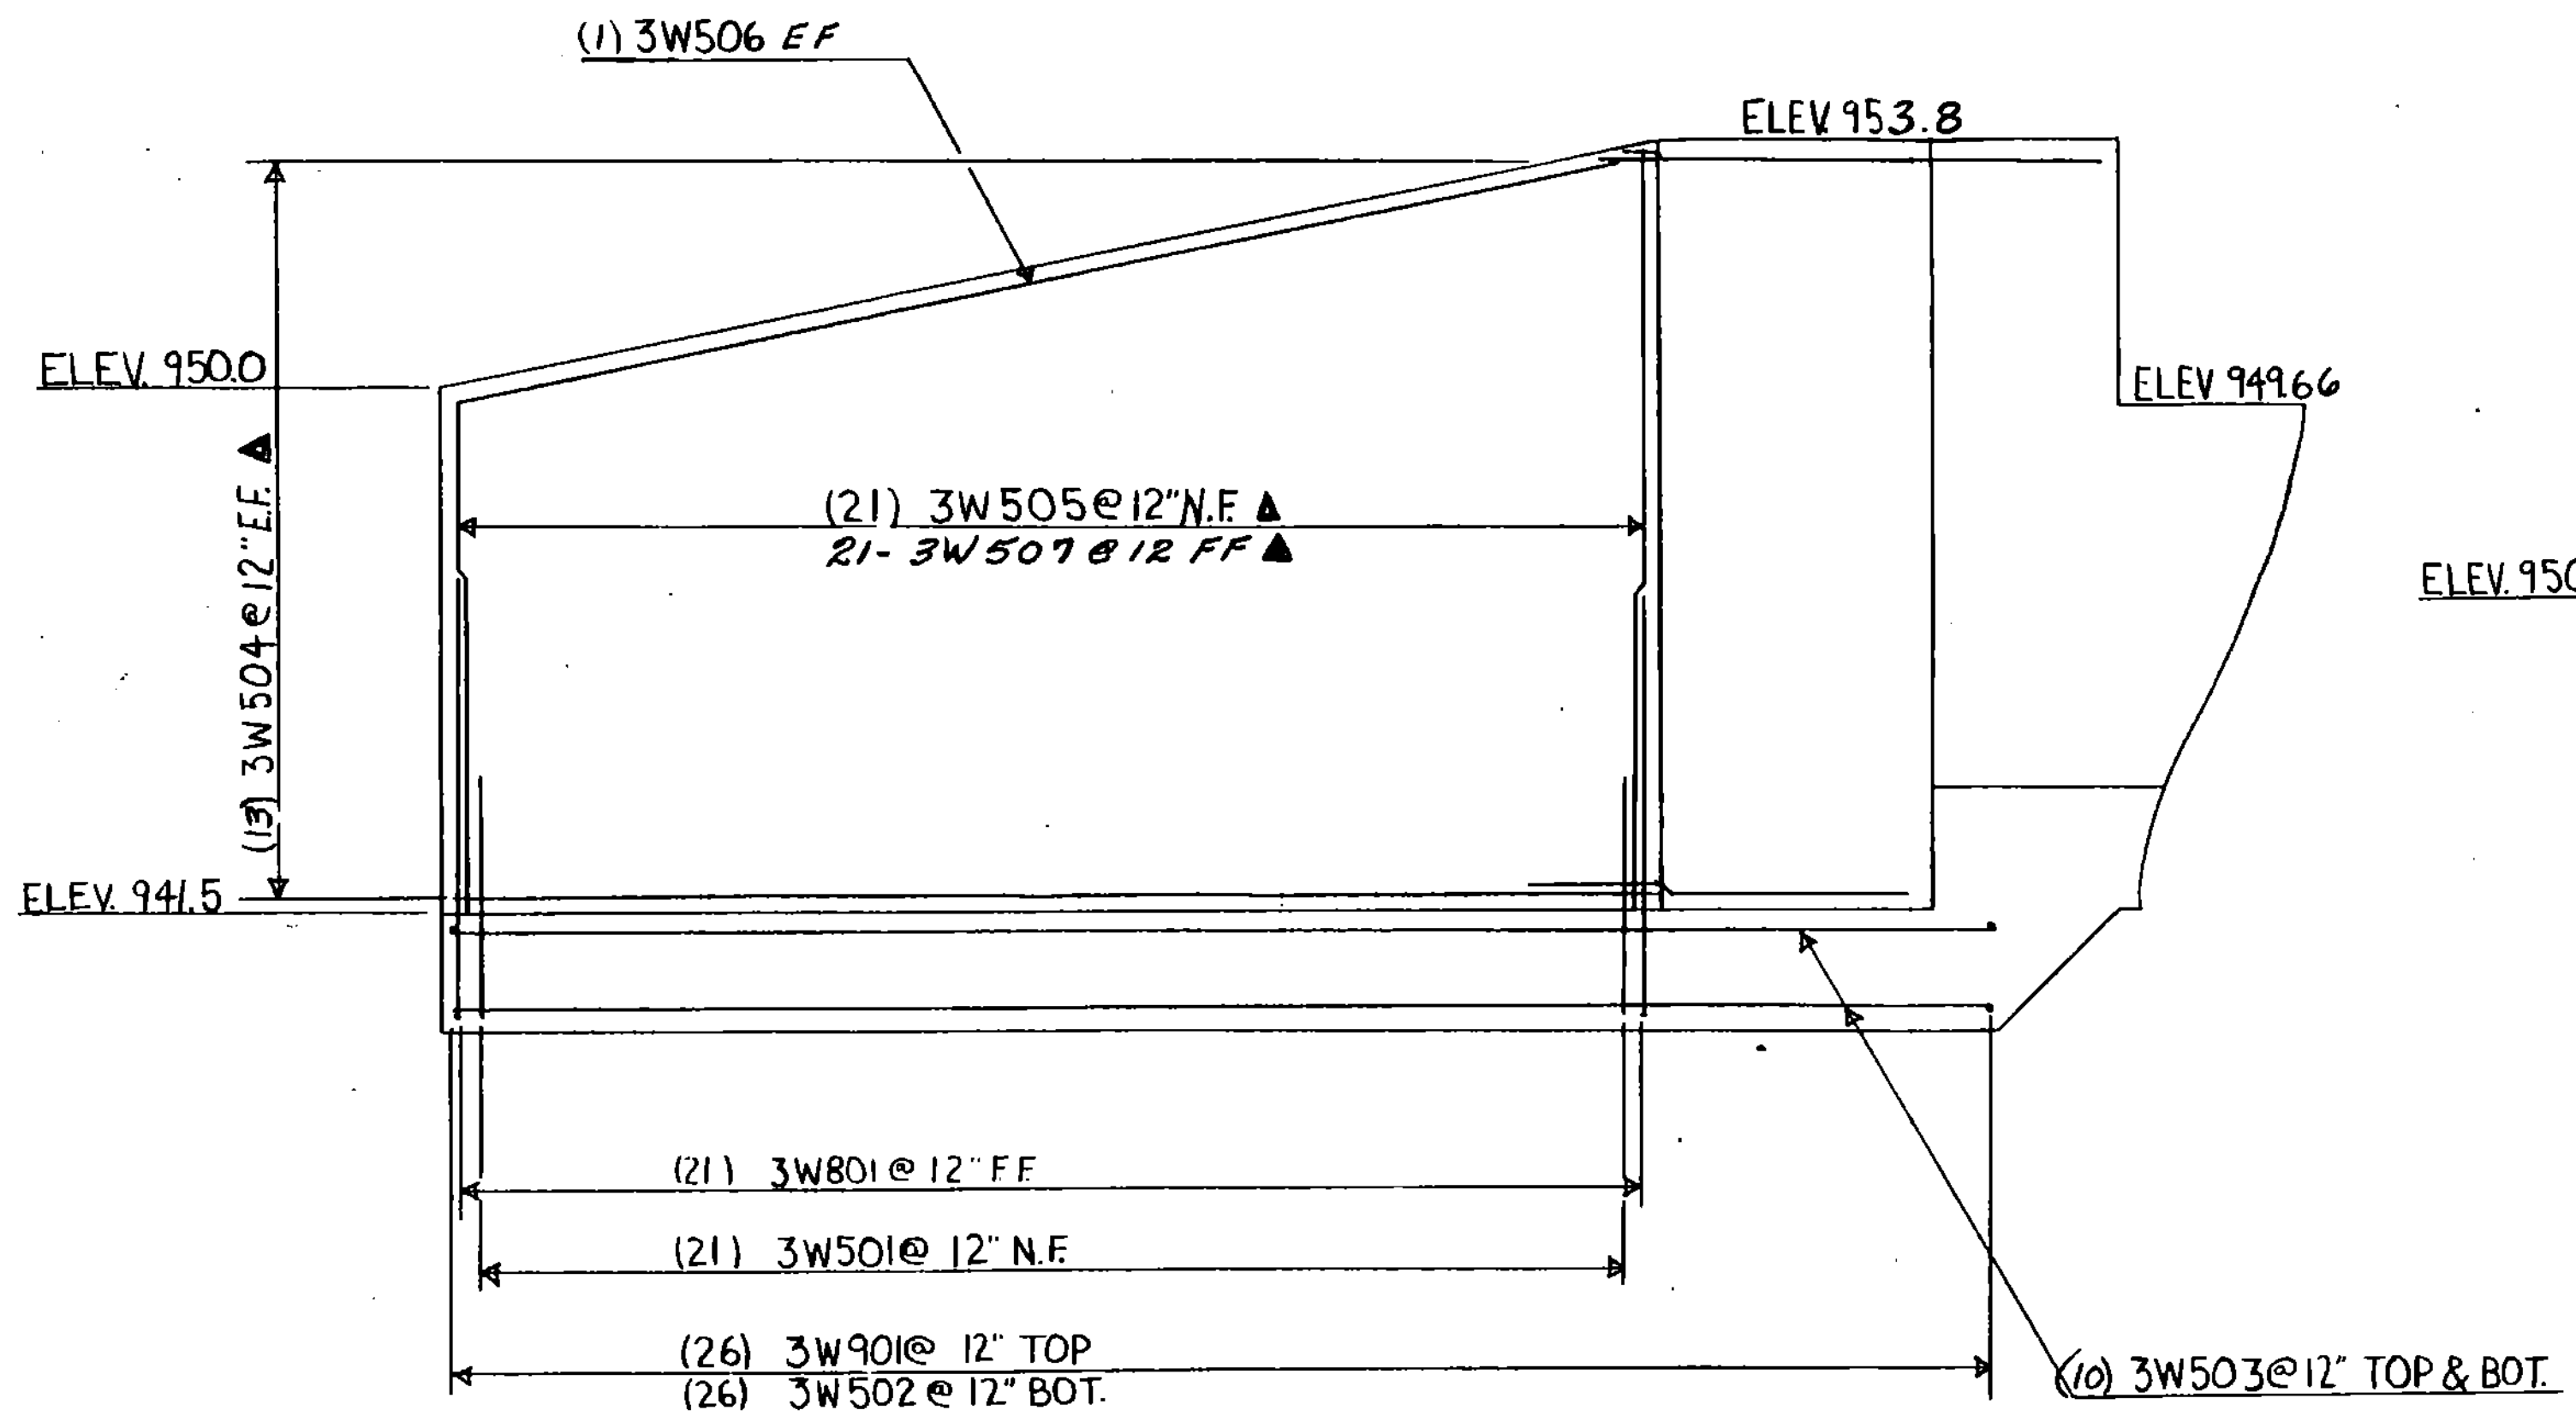


WINGWALL NO 3 ELEVATION

SCALE: 3/8" = 1'-0"

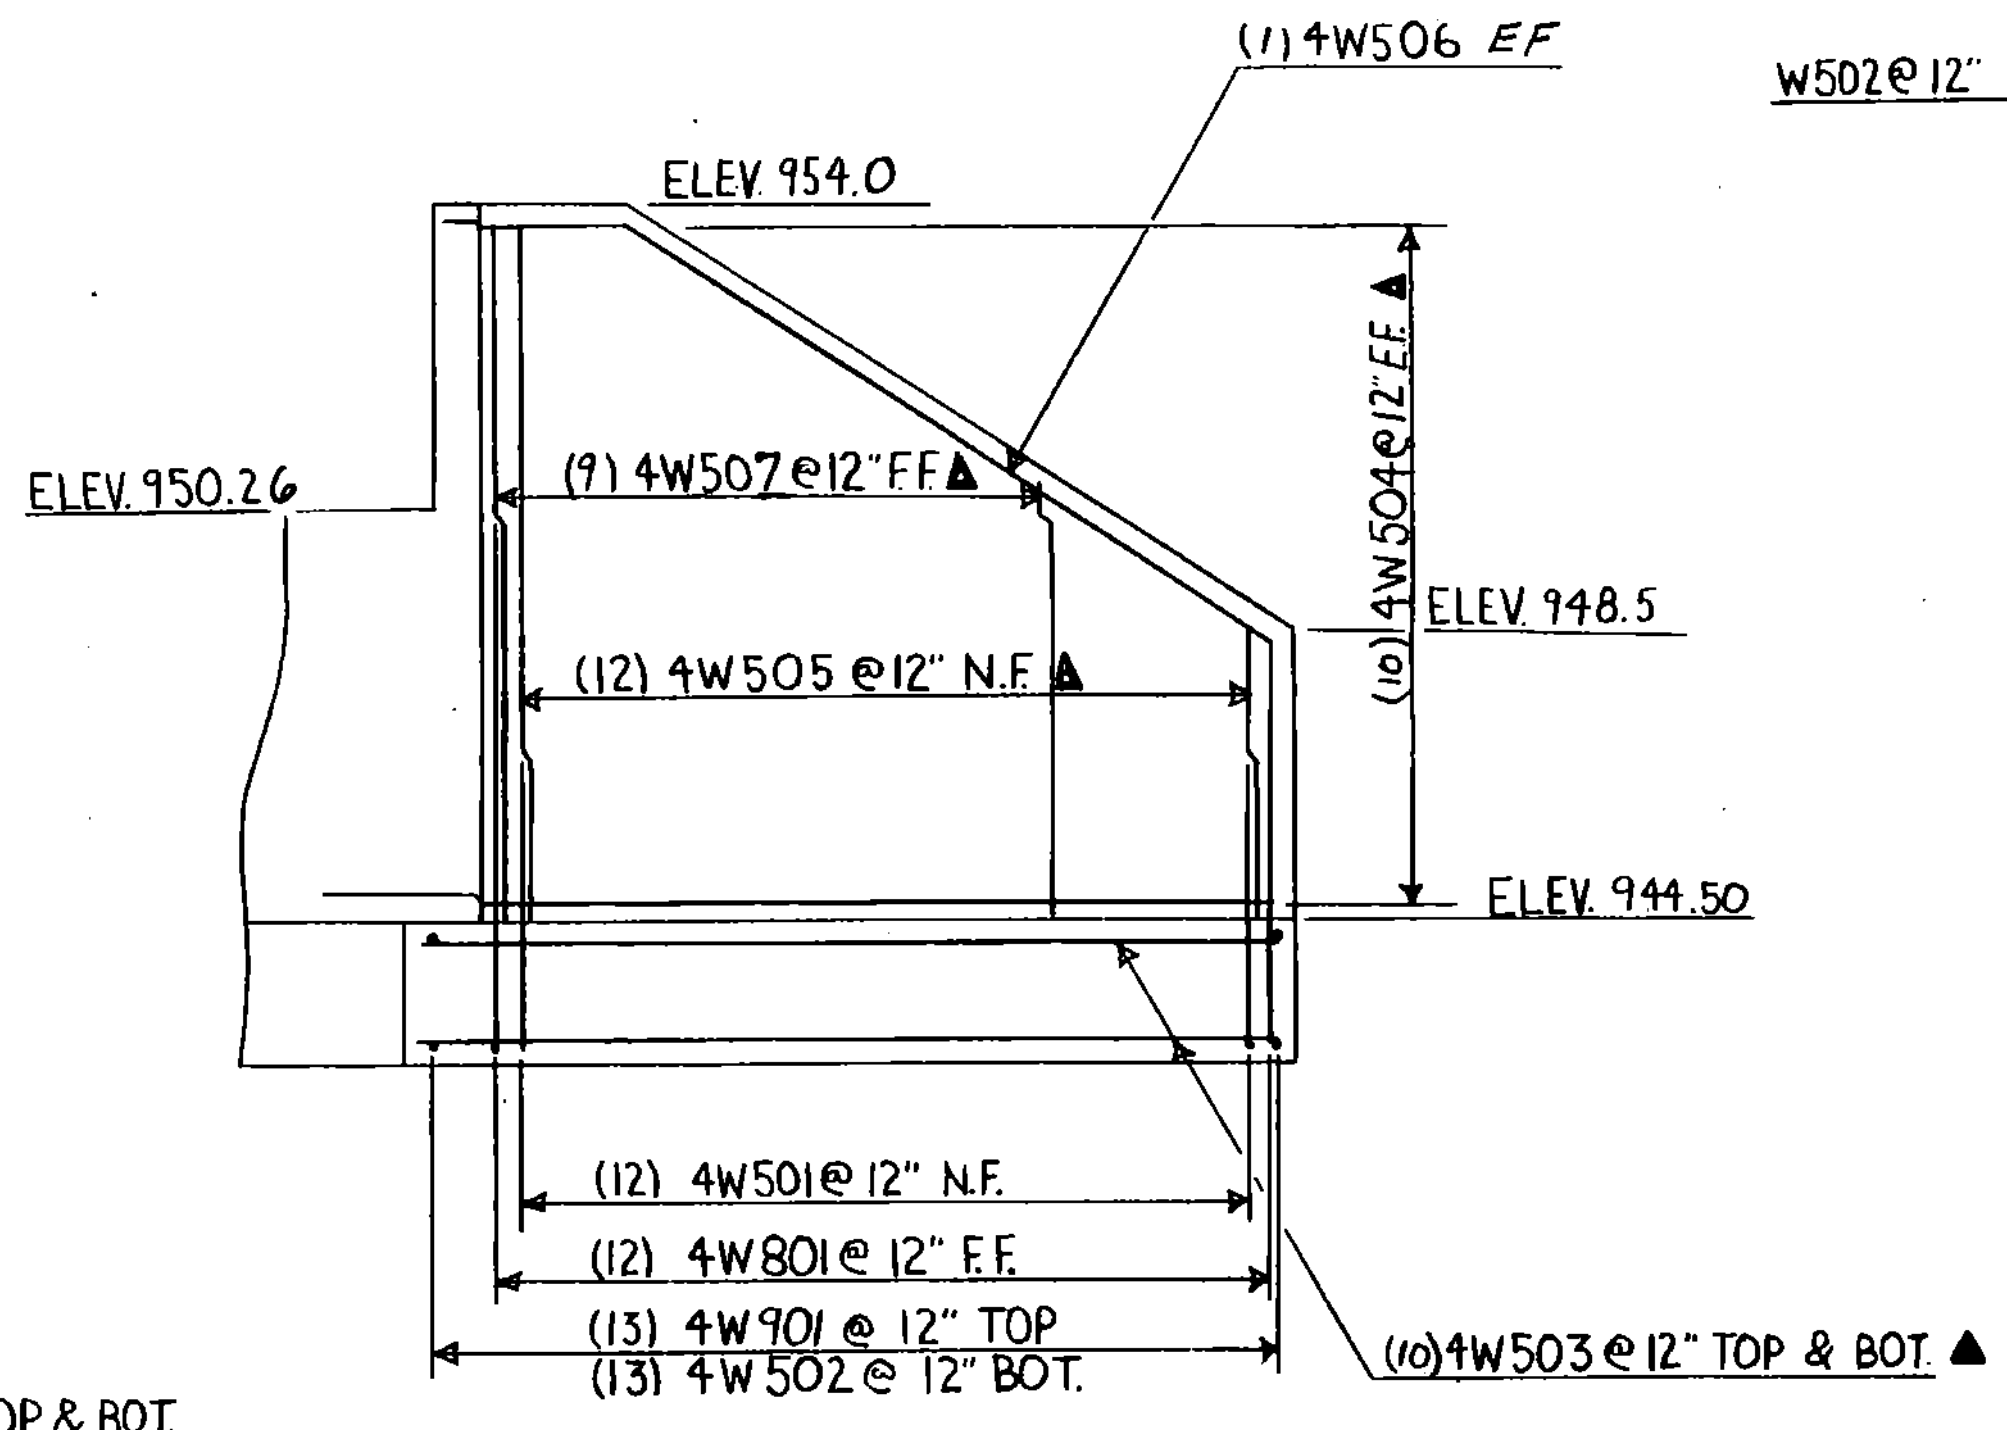

WINGWALL NO4 ELEVATION

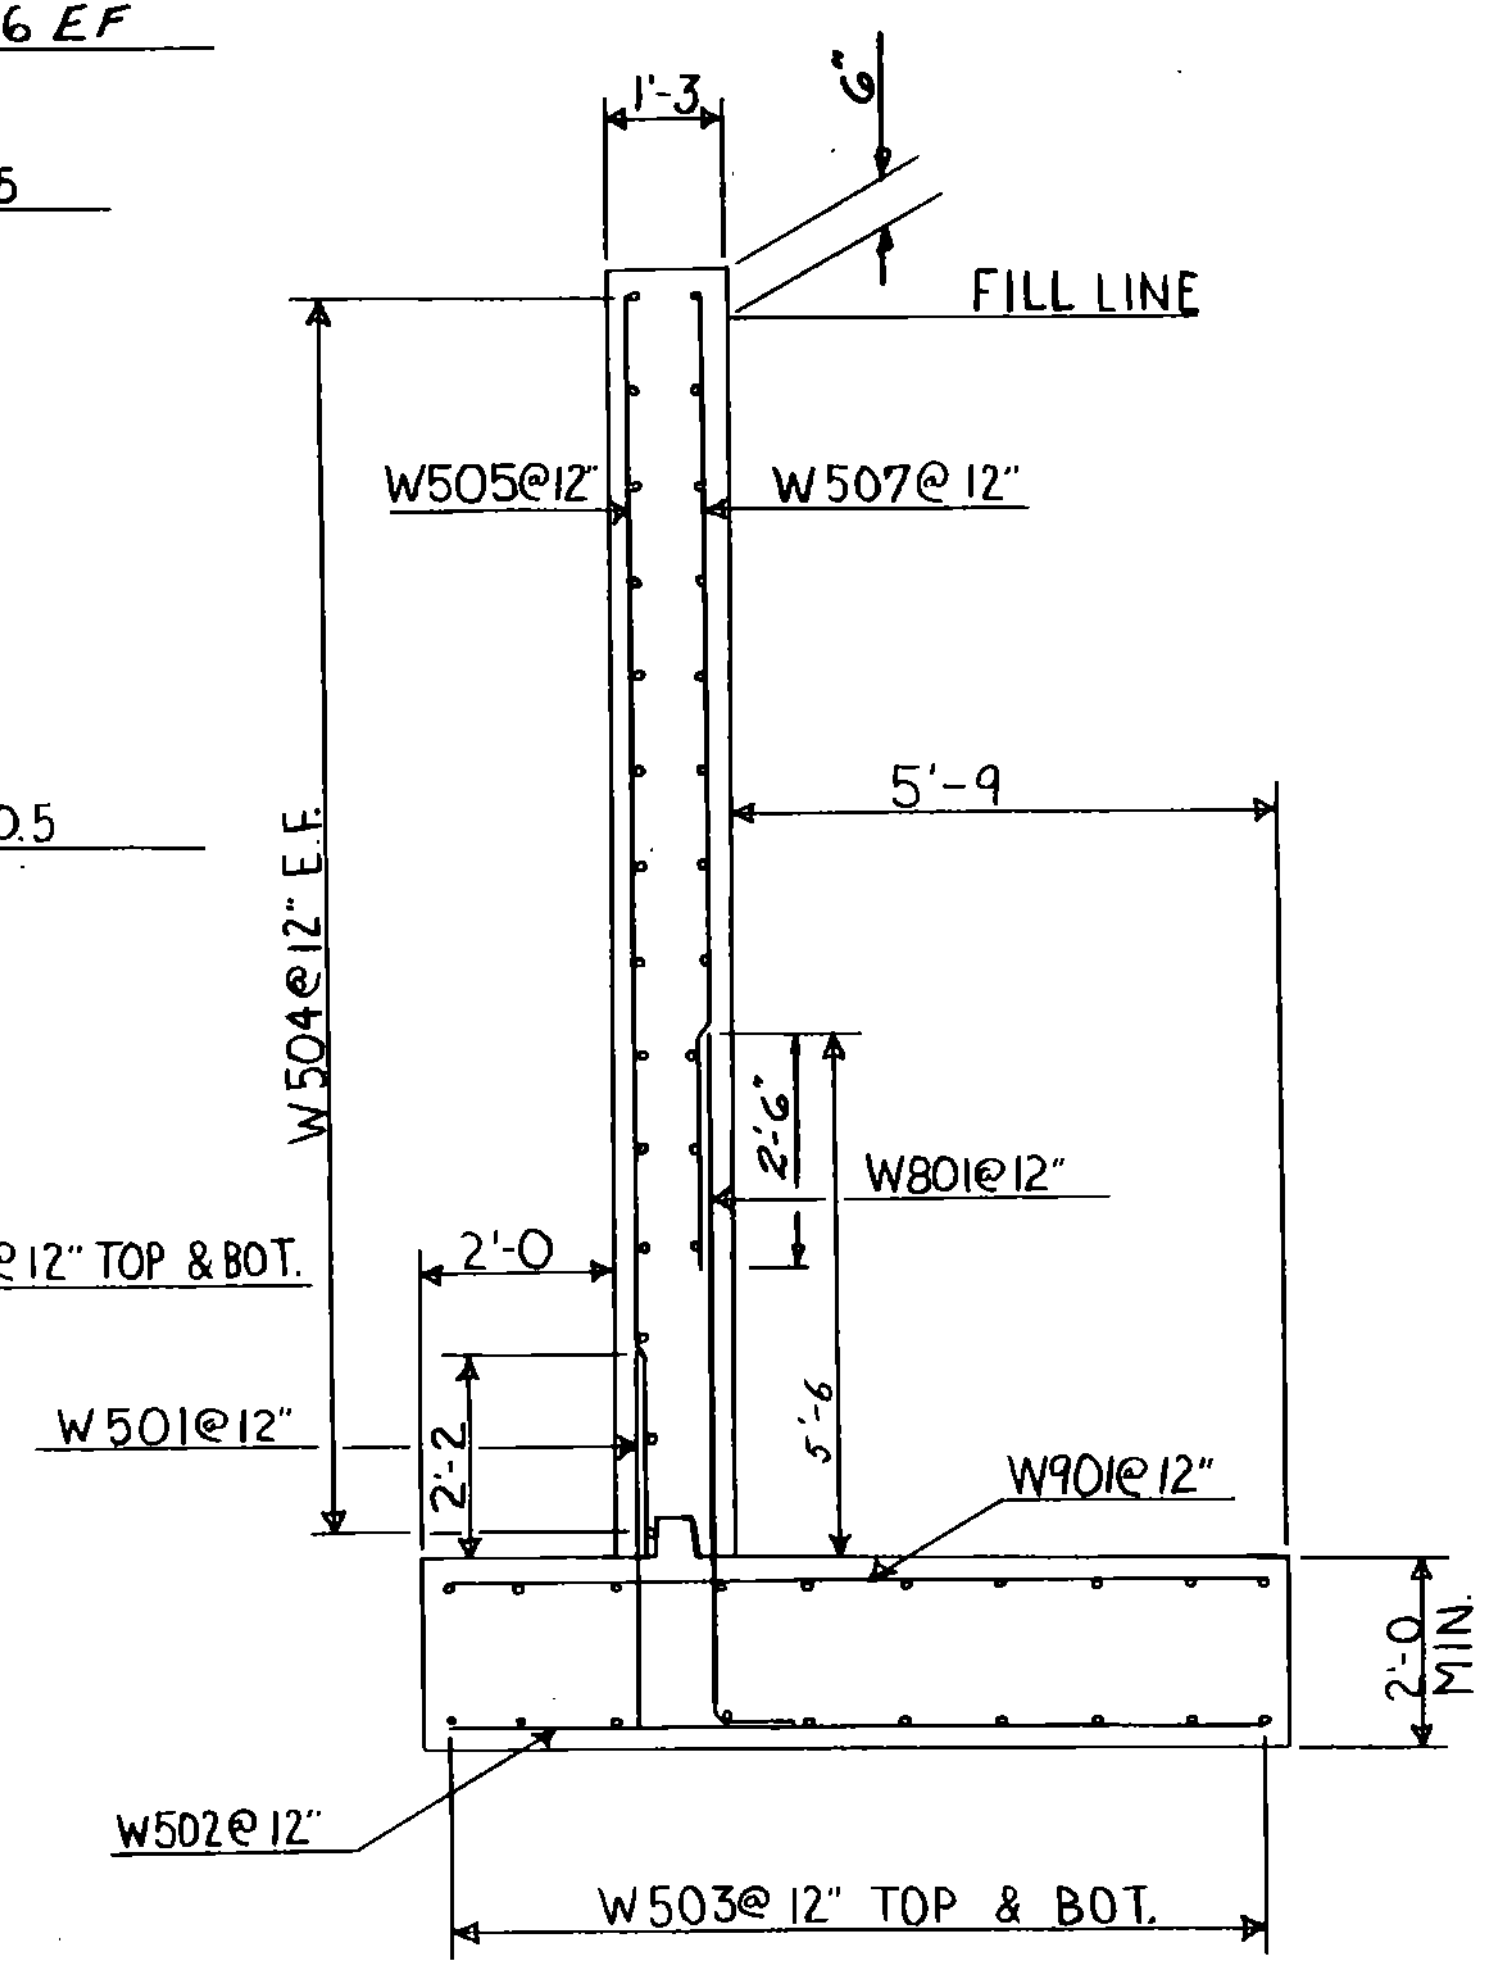

WINGWALL TYPICAL SECTION

SCALE: 1/2" = 1'-0"

▲ DENOTES BARS TO BE CUT IN FIELD.

STATE OF VERMONT	
AGENCY OF TRANSPORTATION	
Town Of CHESTER	Bridge No. 67
Highway No. T.H. NO. 9	Log Sta.
	Surv. Sta.
T.H. No. 9 OVER WILLIAMS RIVER	
WINGWALL DETAILS	
Designed By R.P. GENDRON	Drawn By T. SUMNER
Checked By Date	Bridge Design Supervisor
R.P. GENDRON 10-21-86	R.L. Ootley Date 11-86
PROJECT CHESTER	PROJECT NO.
	BRZ 1442 (10)
L&C. Info.	
Bridge Sheet No.	Sheet 13 of 28

BRIDGE 44-232 6442

BR-4