



950

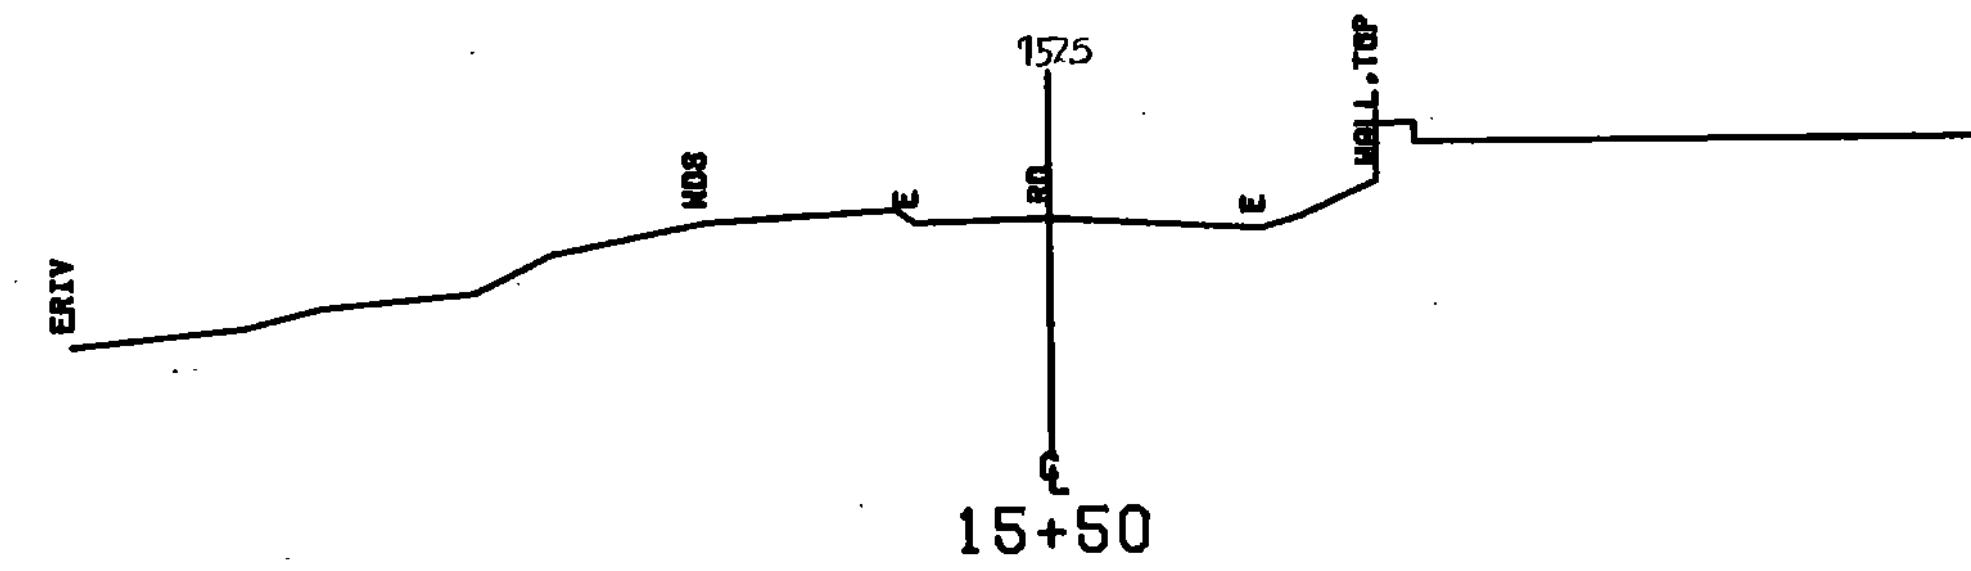

950

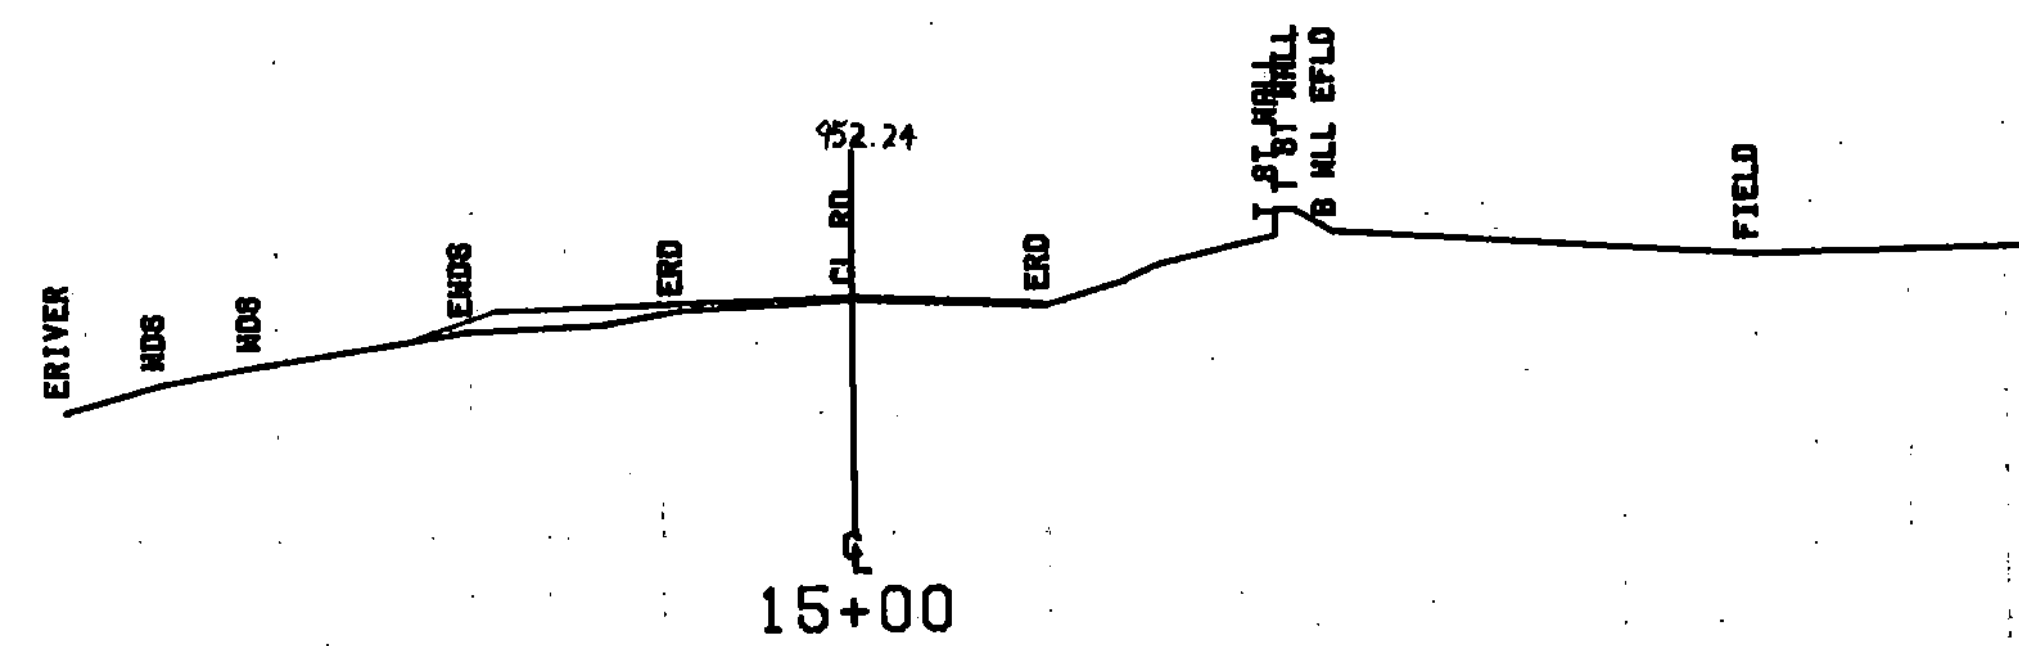

950

15+00 END PROJECT
CONSTRUCT SATISFACTORY APPROACH

TH9

| | | | |
|--------------|---------------------------------|---------|-----------|
| FROM STA. | 18+00 | TO STA. | 18+00 |
| PROJECT NAME | CHESTER MAIN | | |
| NO. | BR21442(10) | | |
| SURVEYED BY | TESSIEA FEB 65 & FANTONI MAY 64 | | |
| SHEET NO. | 22 | OF | 22 SHEETS |

SCALE 1"=10.00'