



950

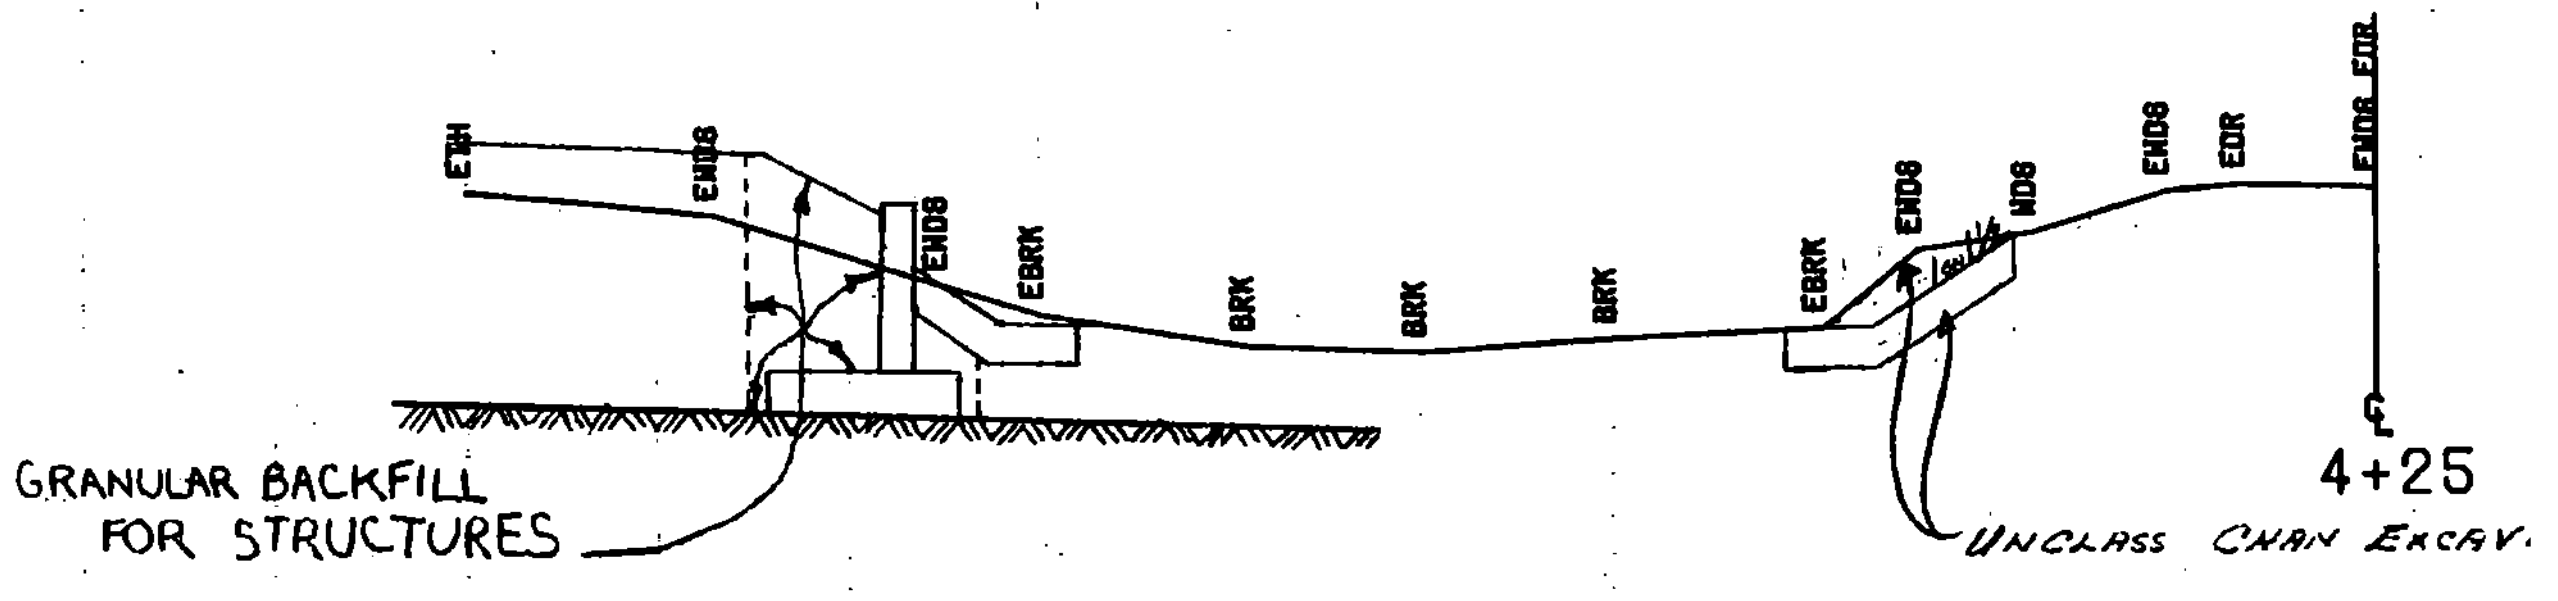


NOTE: LEDGE LINE HAS BEEN DETERMINED BY USING INTERPOLATED AND EXTRA-POLATED VALUES FROM THE BORING DATA.


950

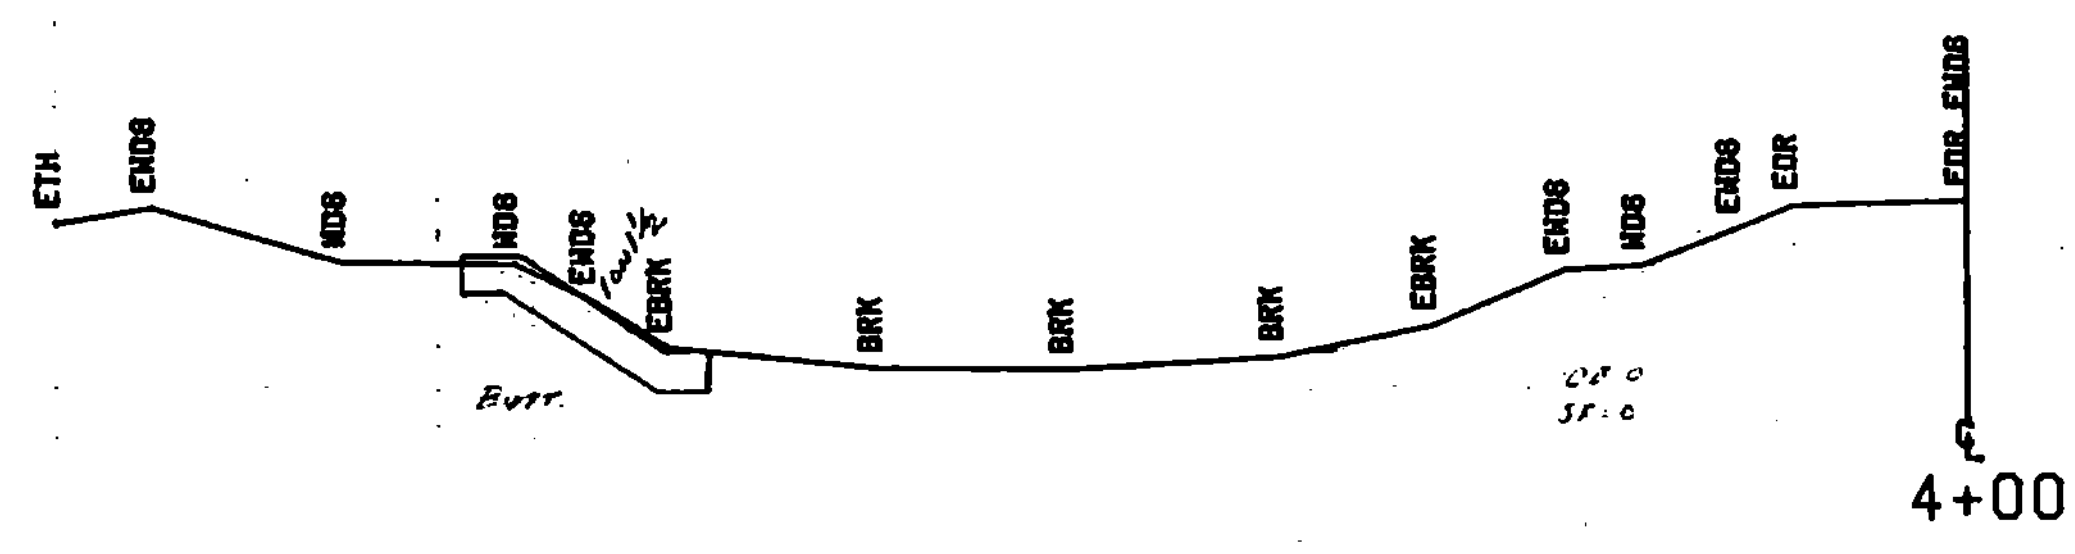

950

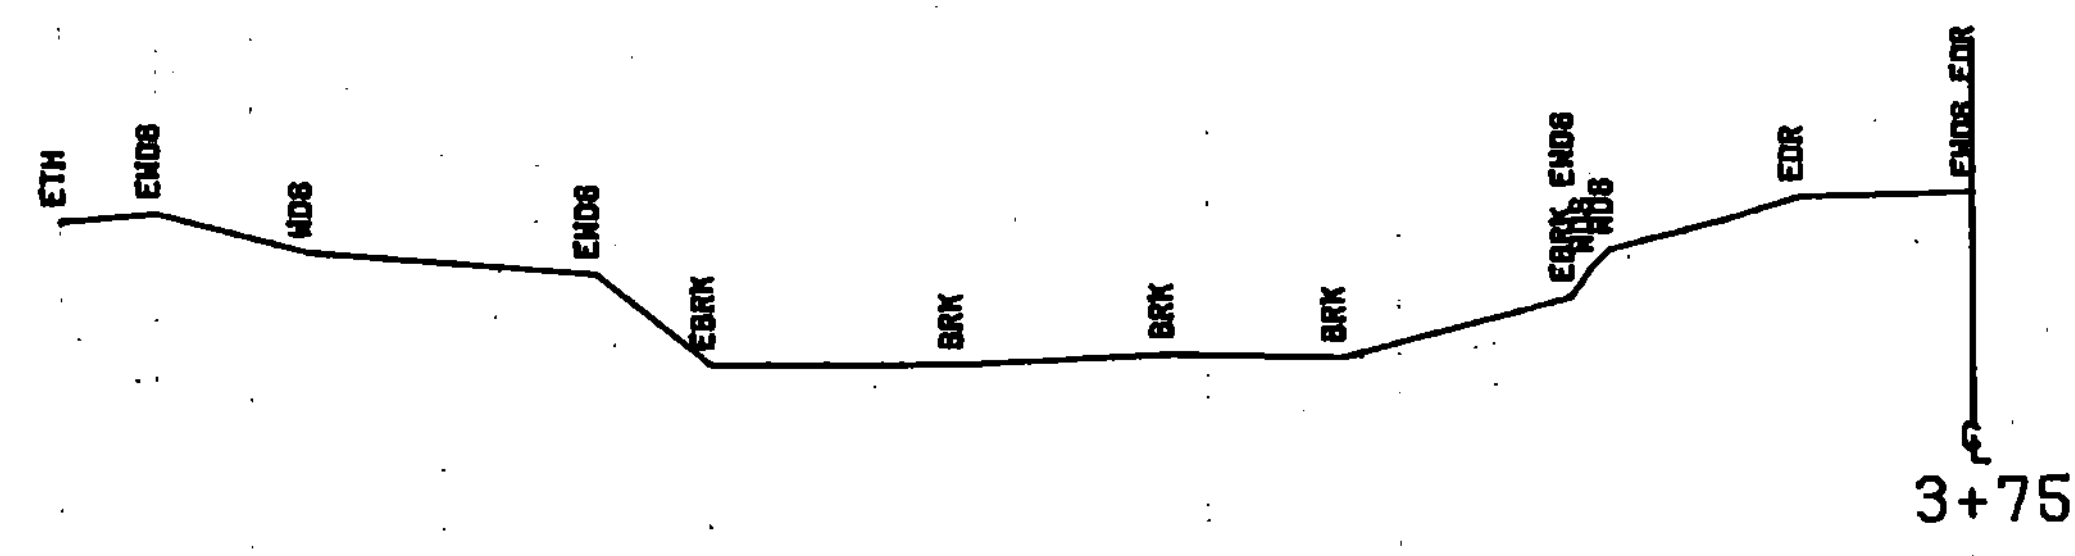

950

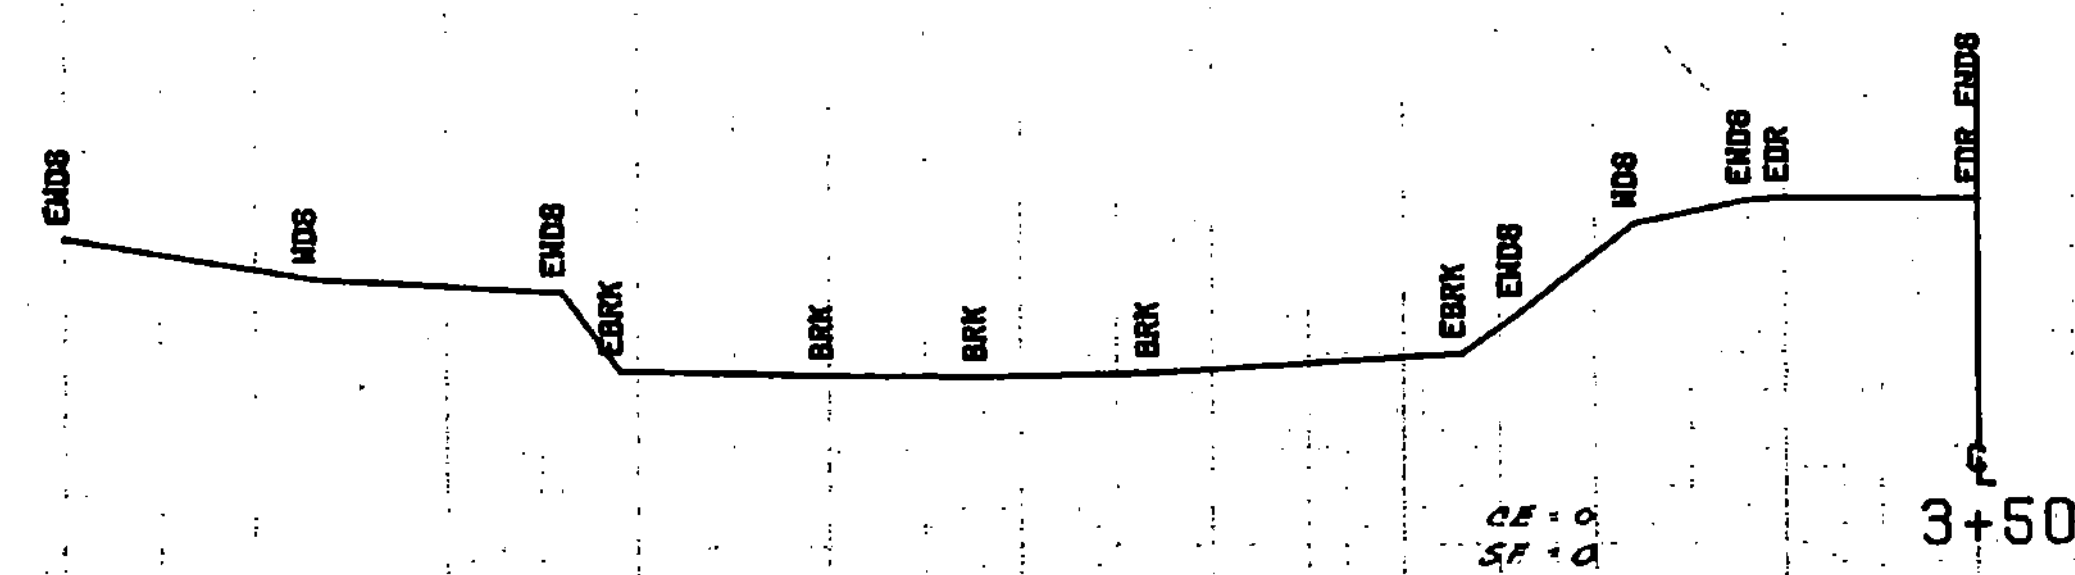

950

FROM STA. 3+50	TO STA. 4+50
PROJECT NAME CHESTER CHAN	NO. BR21442(10)
SURVEYED BY TEBBER	PLOTTED 04/14/89
SHEET 24 OF 28 SHEETS	FEBRUARY '89

SCALE 1" = 10 FEET