



950

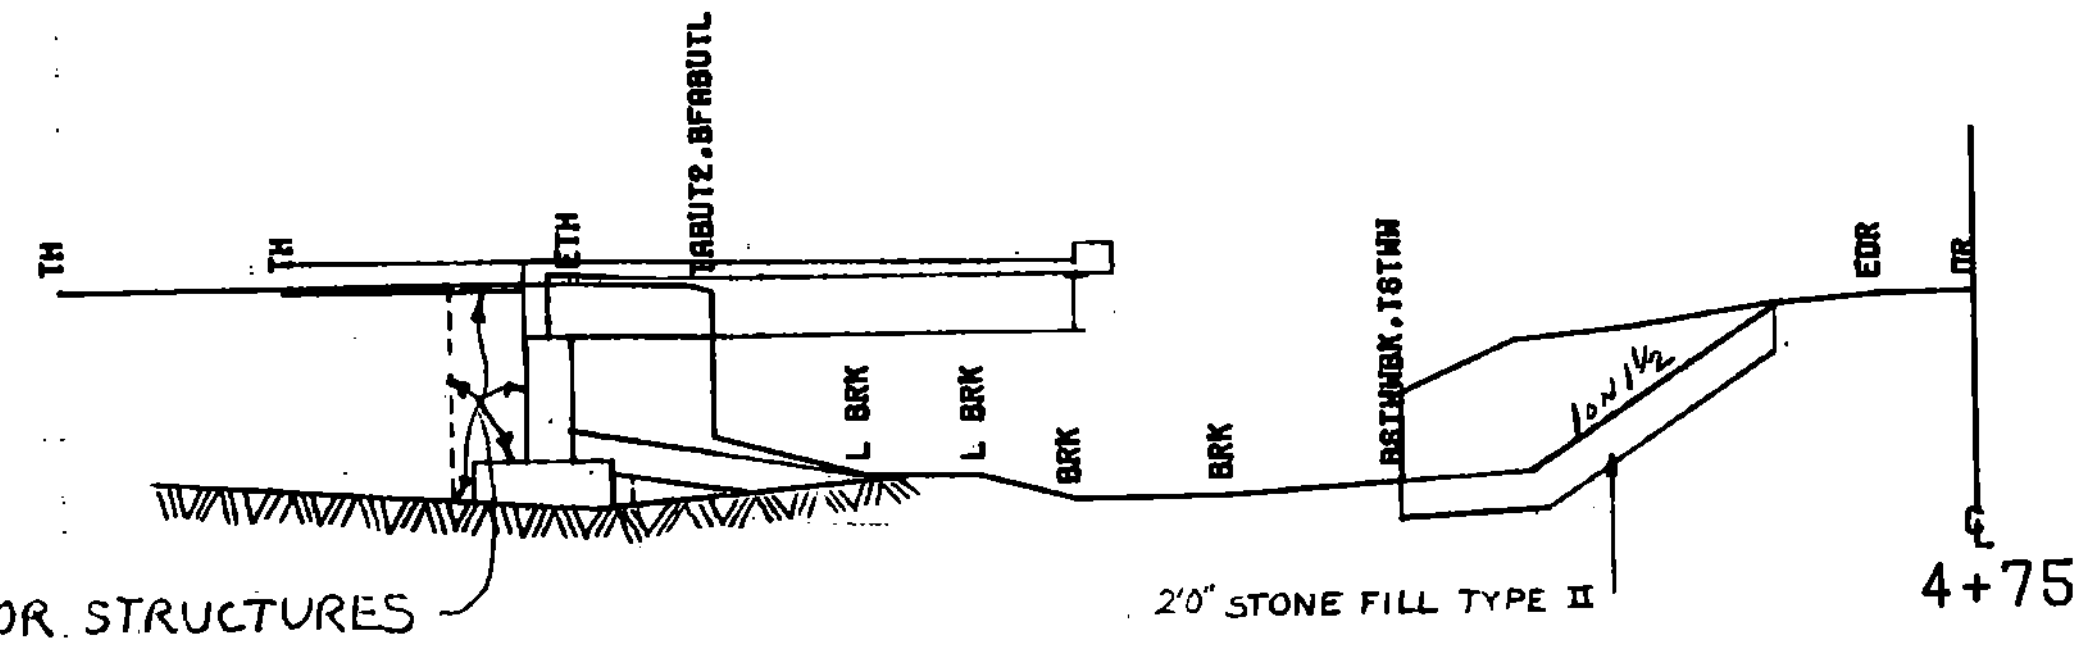


GRANULAR BACKFILL FOR STRUCTURES

950

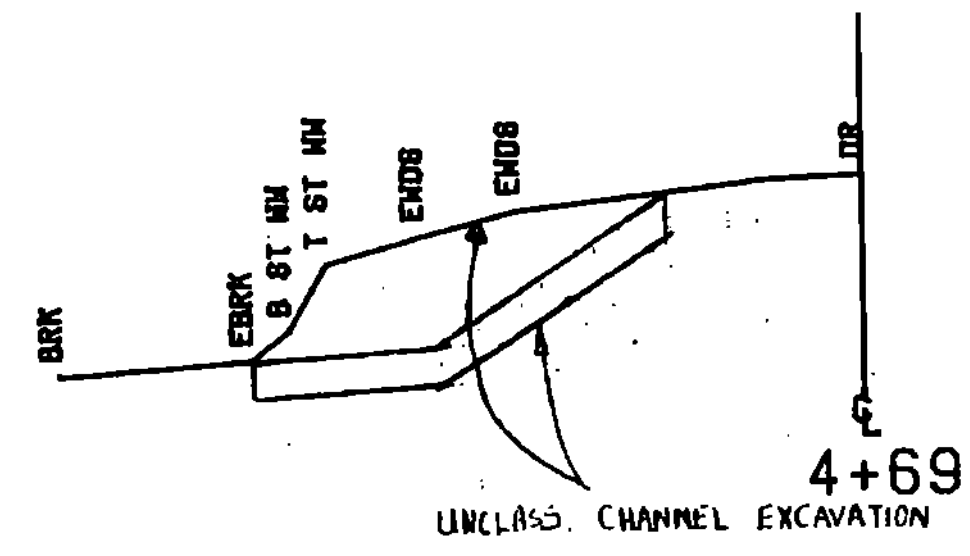

950

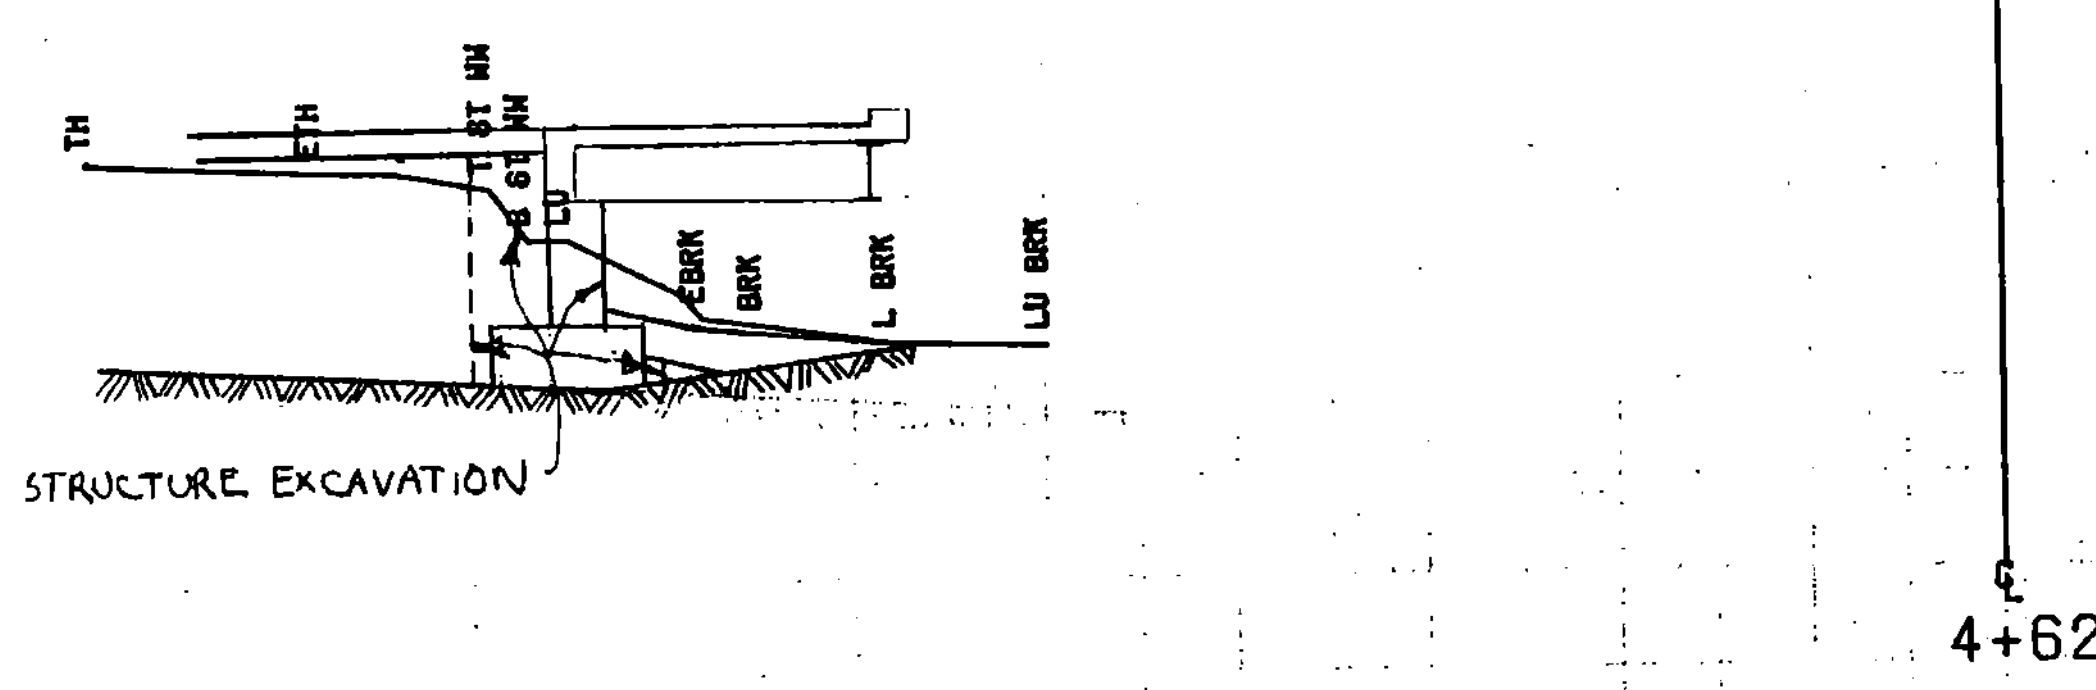

940

FROM STA.	4+62	TO STA.	4+81
PROJECT NAME	CHESTER	CHAN	
NO.	BR21442(10)	PLOTTED	04/14/83
SURVEYED BY	TESBIER	DATE	FEBRUARY '83
SHEET	26	OF	26 SHEETS

SCALE 1" = 10 FEET

26