




940

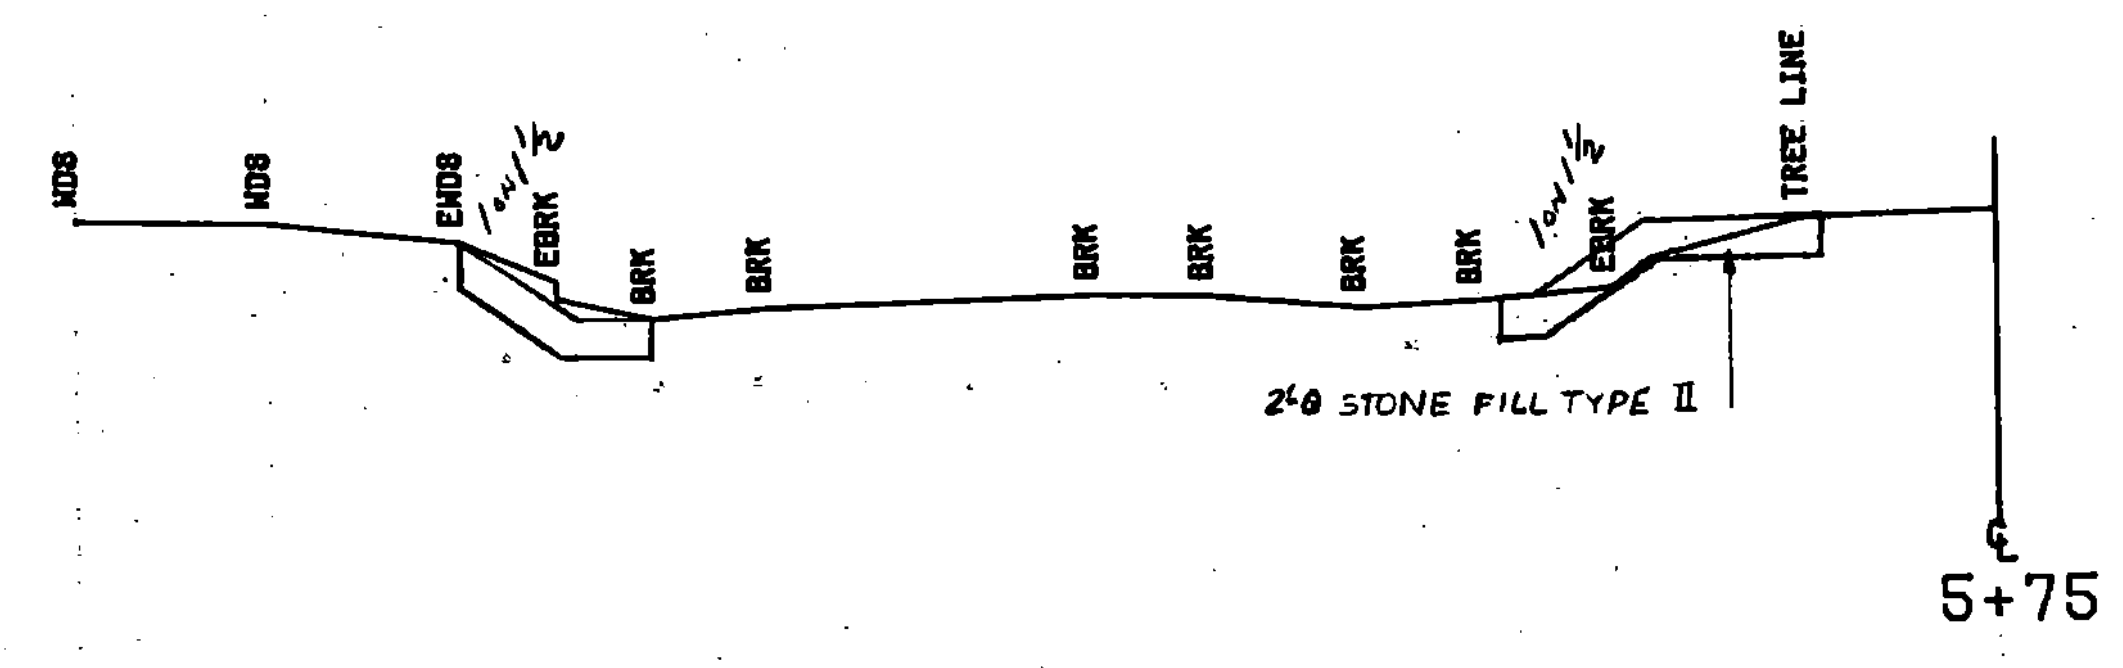

940

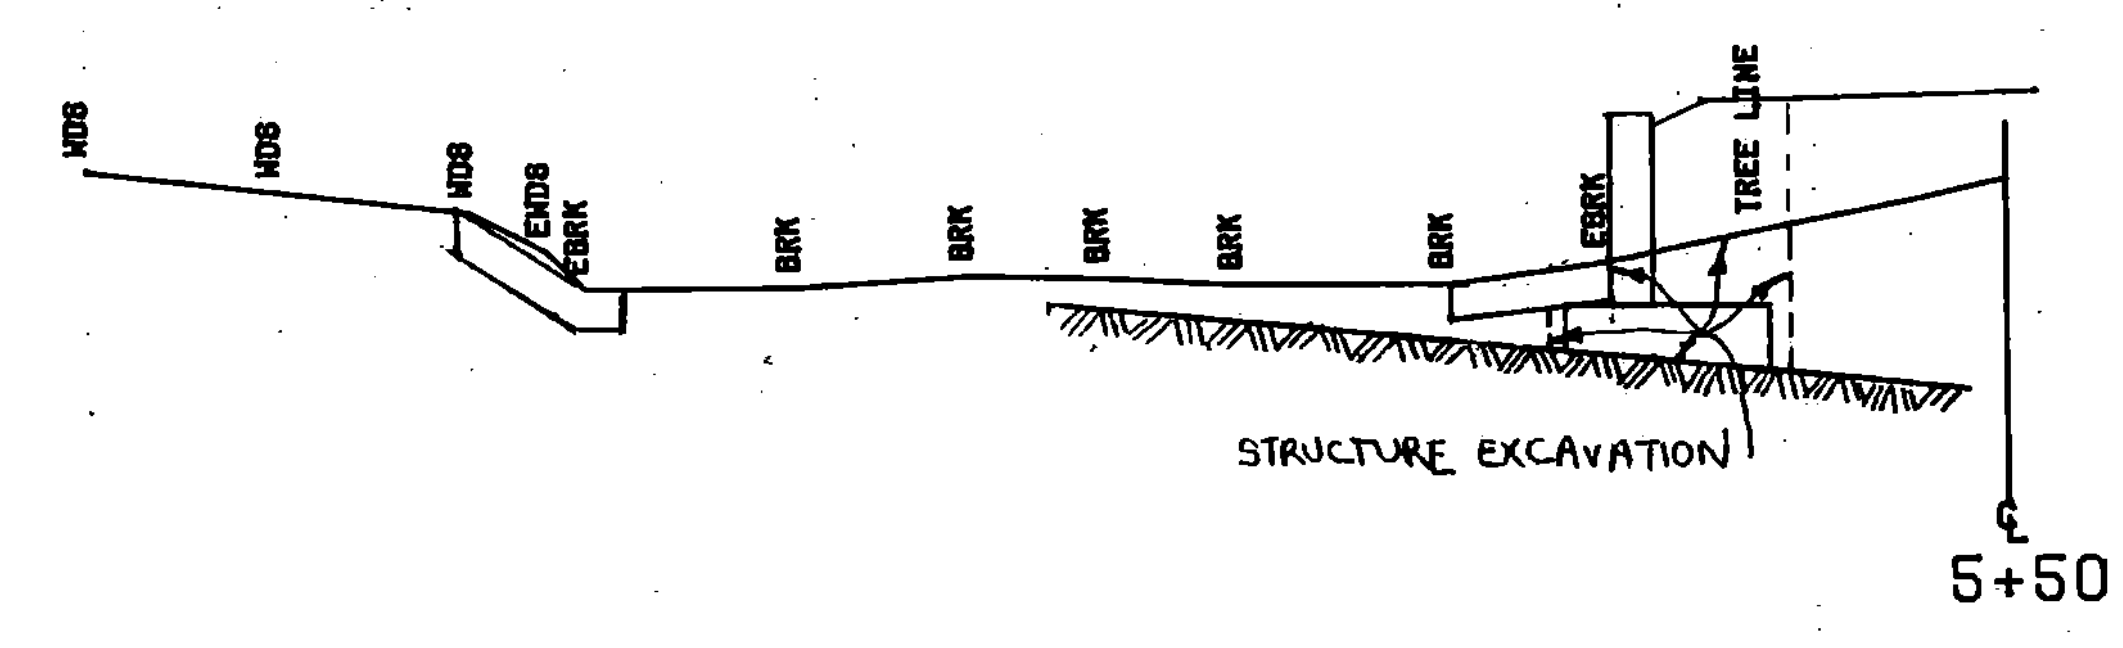

940

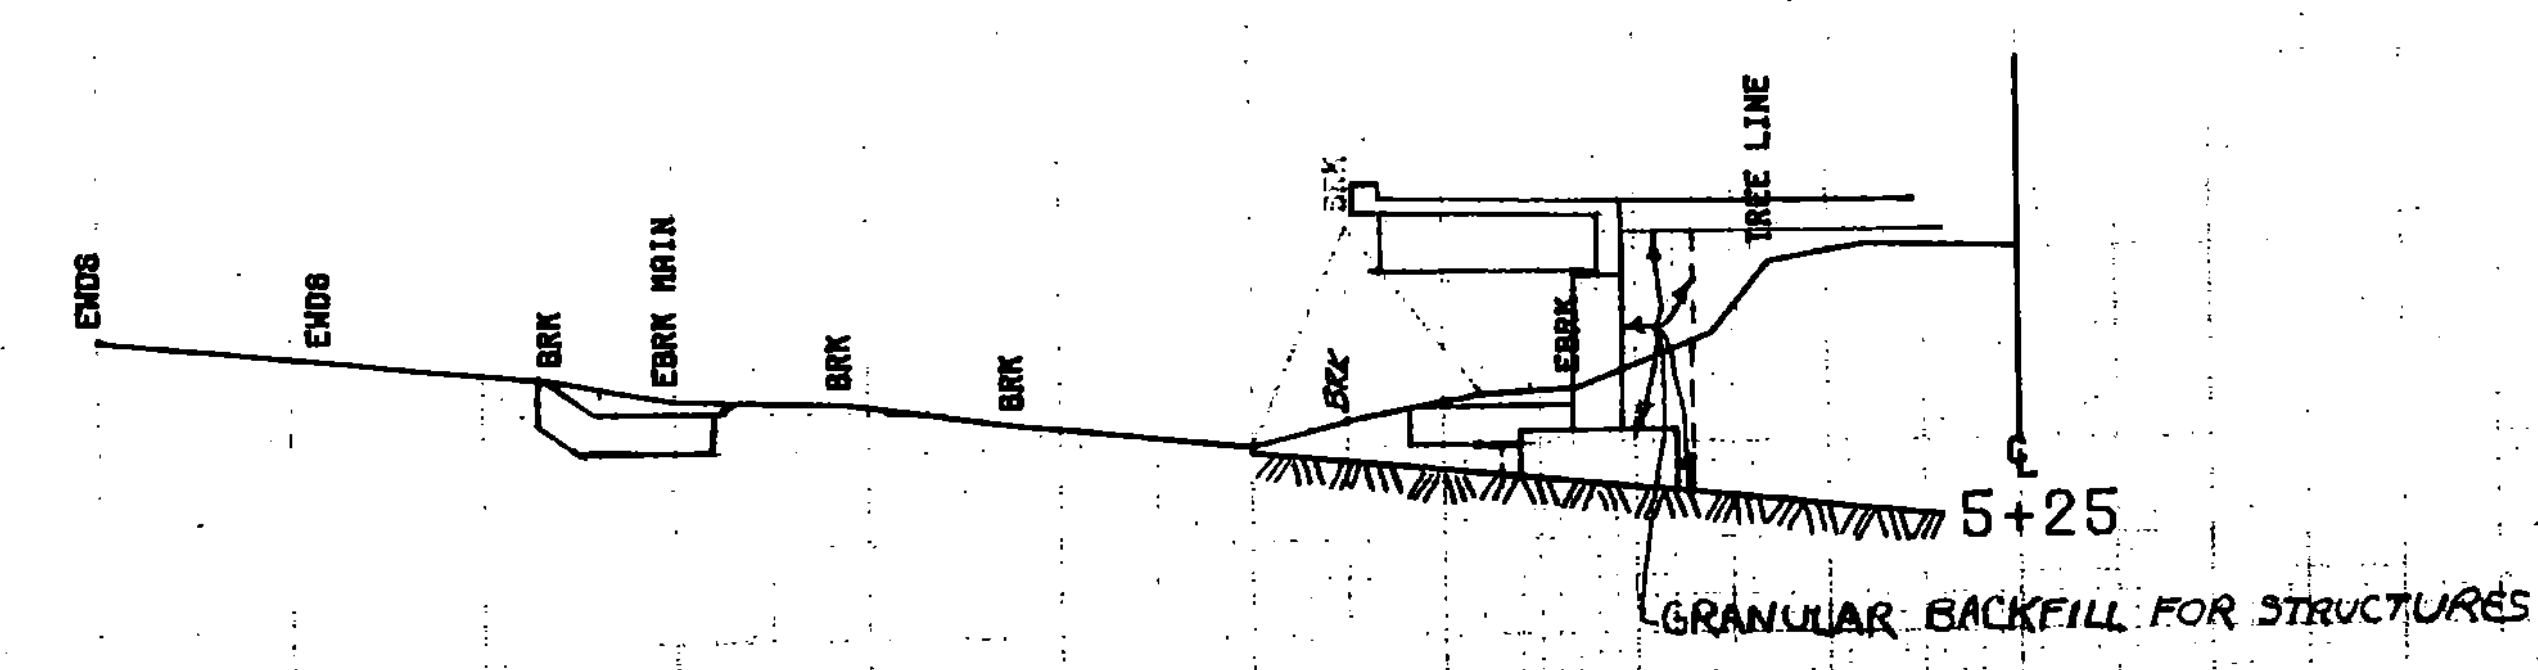

950

FROM STA.	5+25	TO STA.	6+00
PROJECT NAME	CHESTER CHAN	NO.	BRZ1442(10)
SURVEYED BY	TESBIE	PLOTTED	04/14/93
			FEBRUARY '93
		SHEET	29 OF 26 SHEETS

SCALE 10 FEET

28