


PLAN
SCALE: 1" = 10'

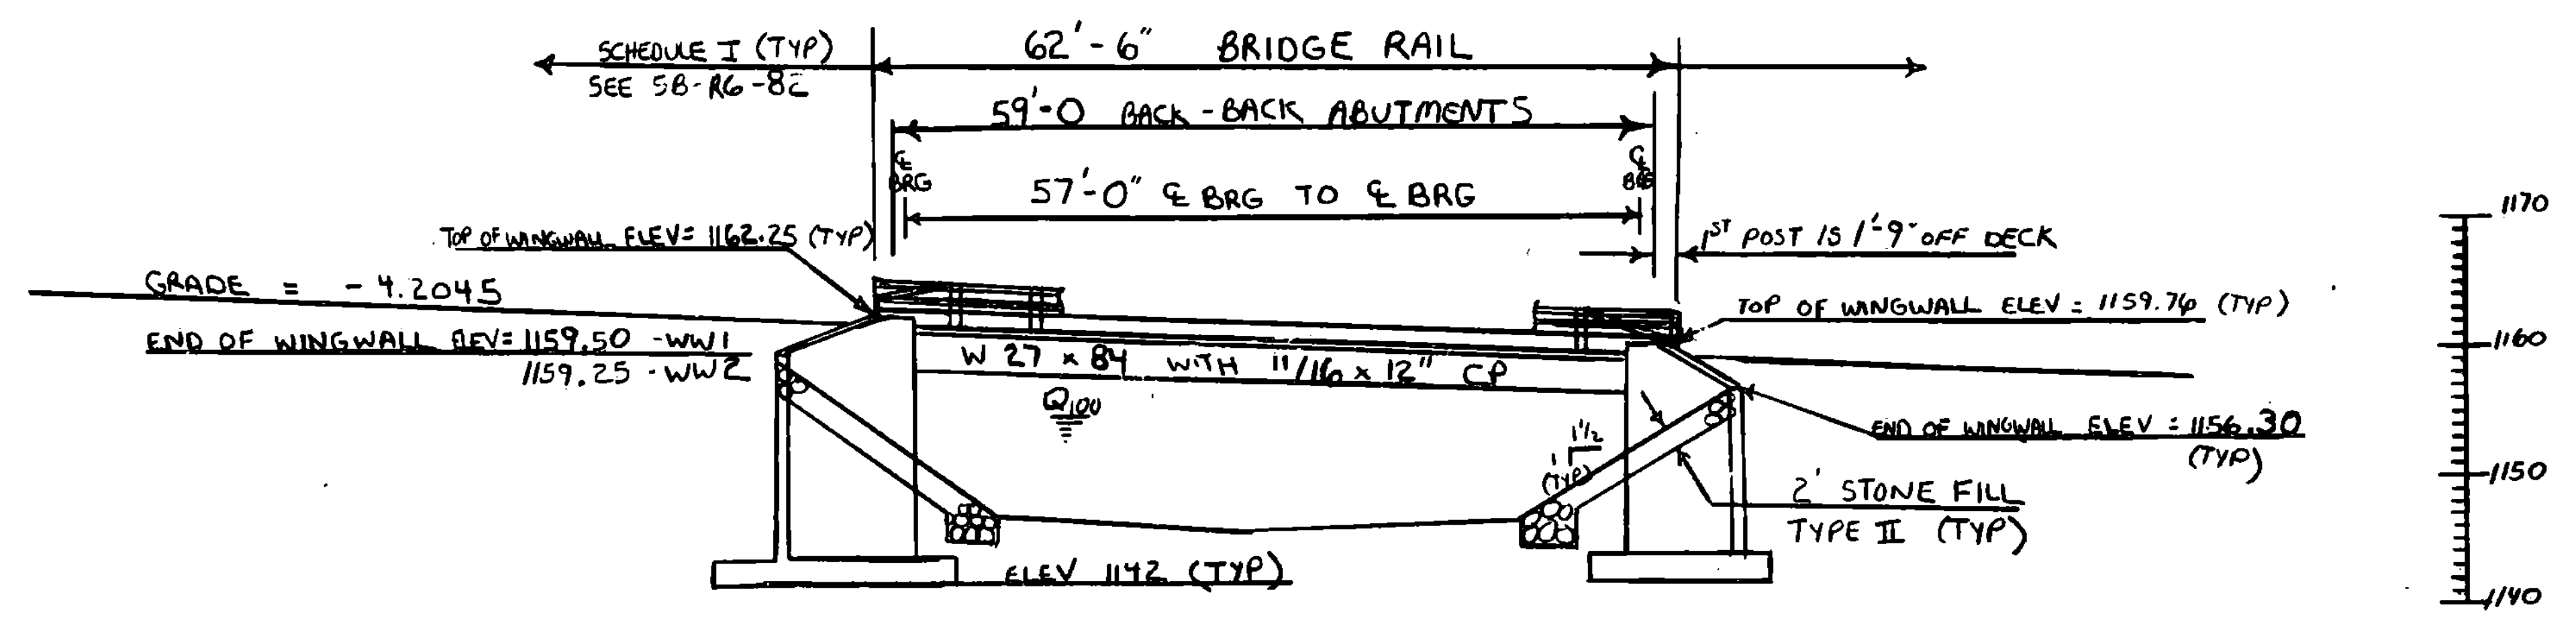

ELEVATION
SCALE:
HORIZ 1" = 10'
VERT 1" = 10'

STATE OF VERMONT AGENCY OF TRANSPORTATION	
Town Of CHARLESTON	Bridge No. 24
Highway No. TH 3	Loc Sta. 52+29 Surv. Sta. 52+29
TH 3 OVER CLYDE RIVER	
DETAIL PLAN AND ELEVATION BR 24	
Designed By A CHURCH	Drawn By A CHURCH
Checked By C WILLIAMS Date 12-88	Bridge Design Supervisor R GENDRON Date 1-89
PROJECT CHARLESTON	PROJECT NO. BR 2 1449 (14)
L.C.C. Info.	
Bridge Sheet No.	Sheet 6 of 33

BRUNING 44-232 64442