



SECTION B-B
SCALE 3/4" = 1'-0"
(TYPICAL ALL CORNERS)


SECTION A-A
SCALE 3/4" = 1'-0"
(TYPICAL ALL CORNERS)

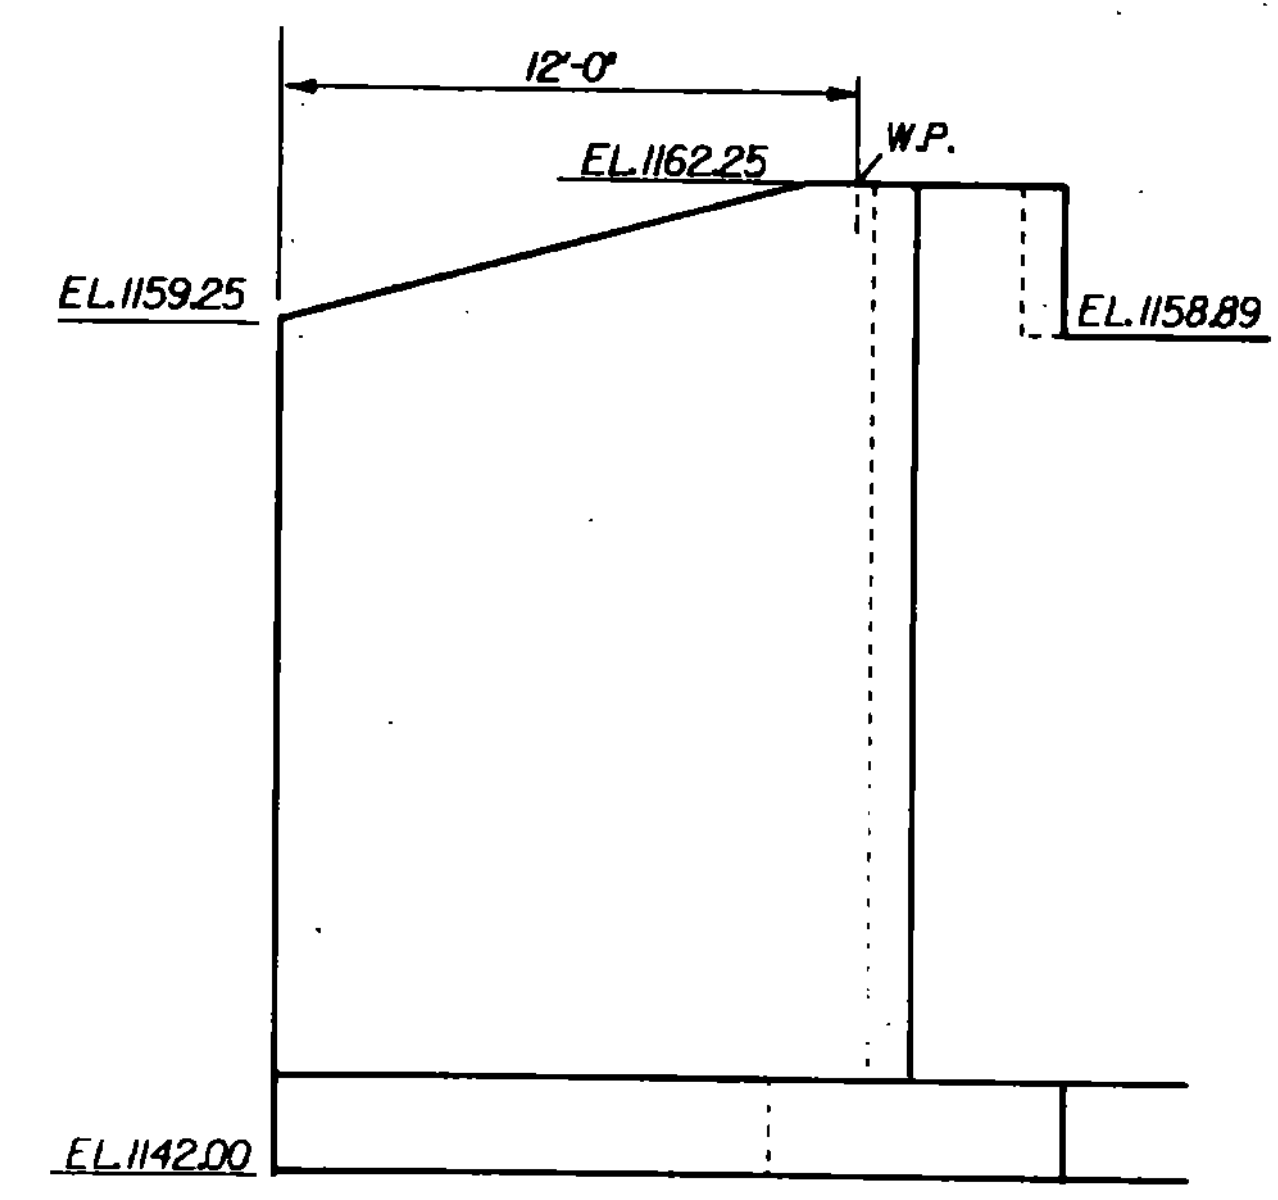


ELEVATION WINGWALL 2
SCALE 1/4" = 1'-0"

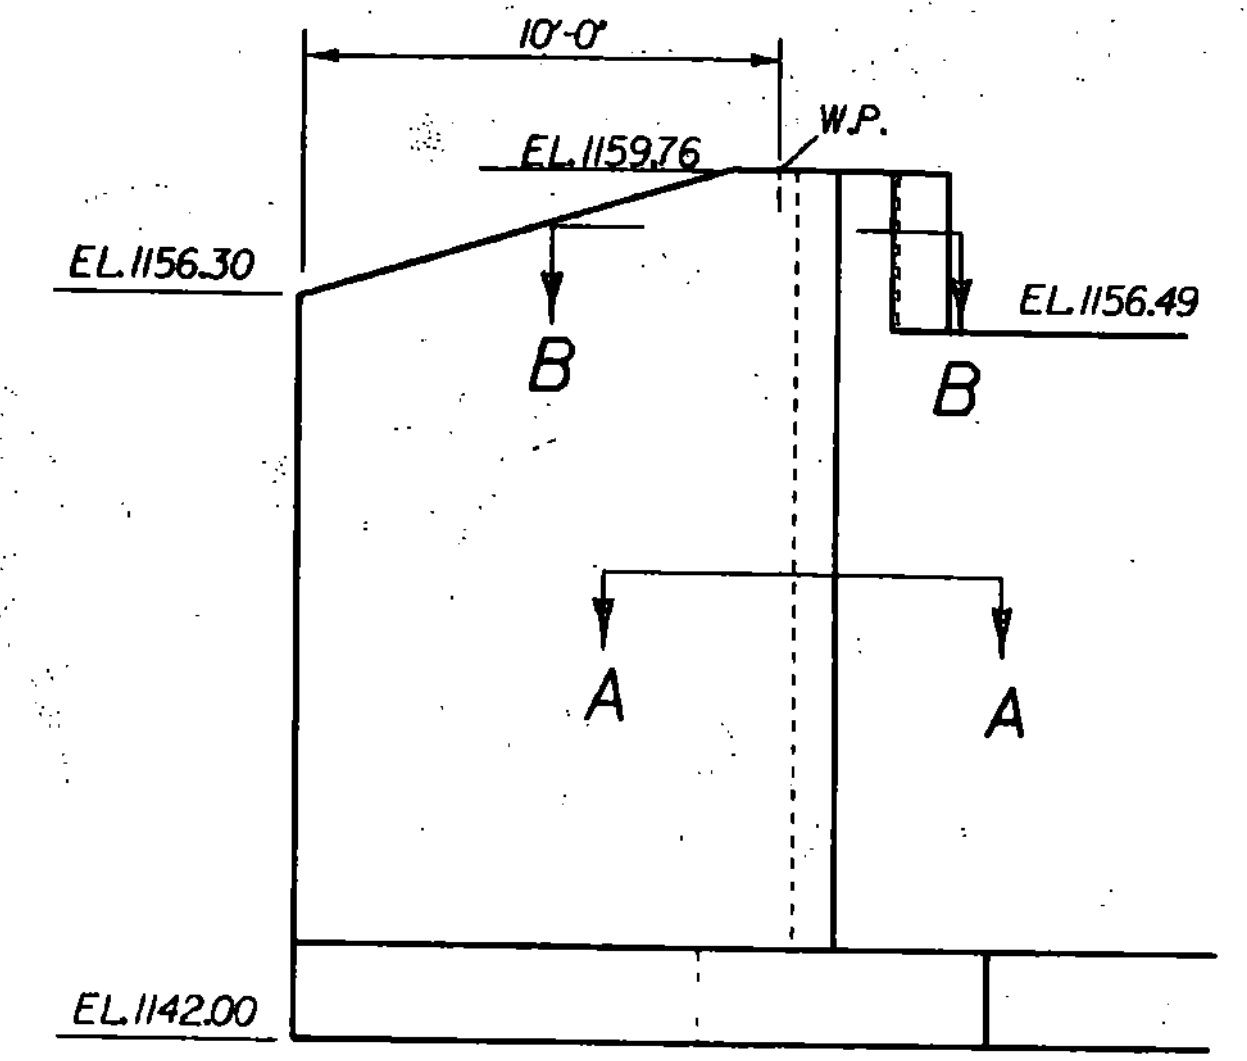


ELEVATION WINGWALL 3
SCALE 1/4" = 1'-0"

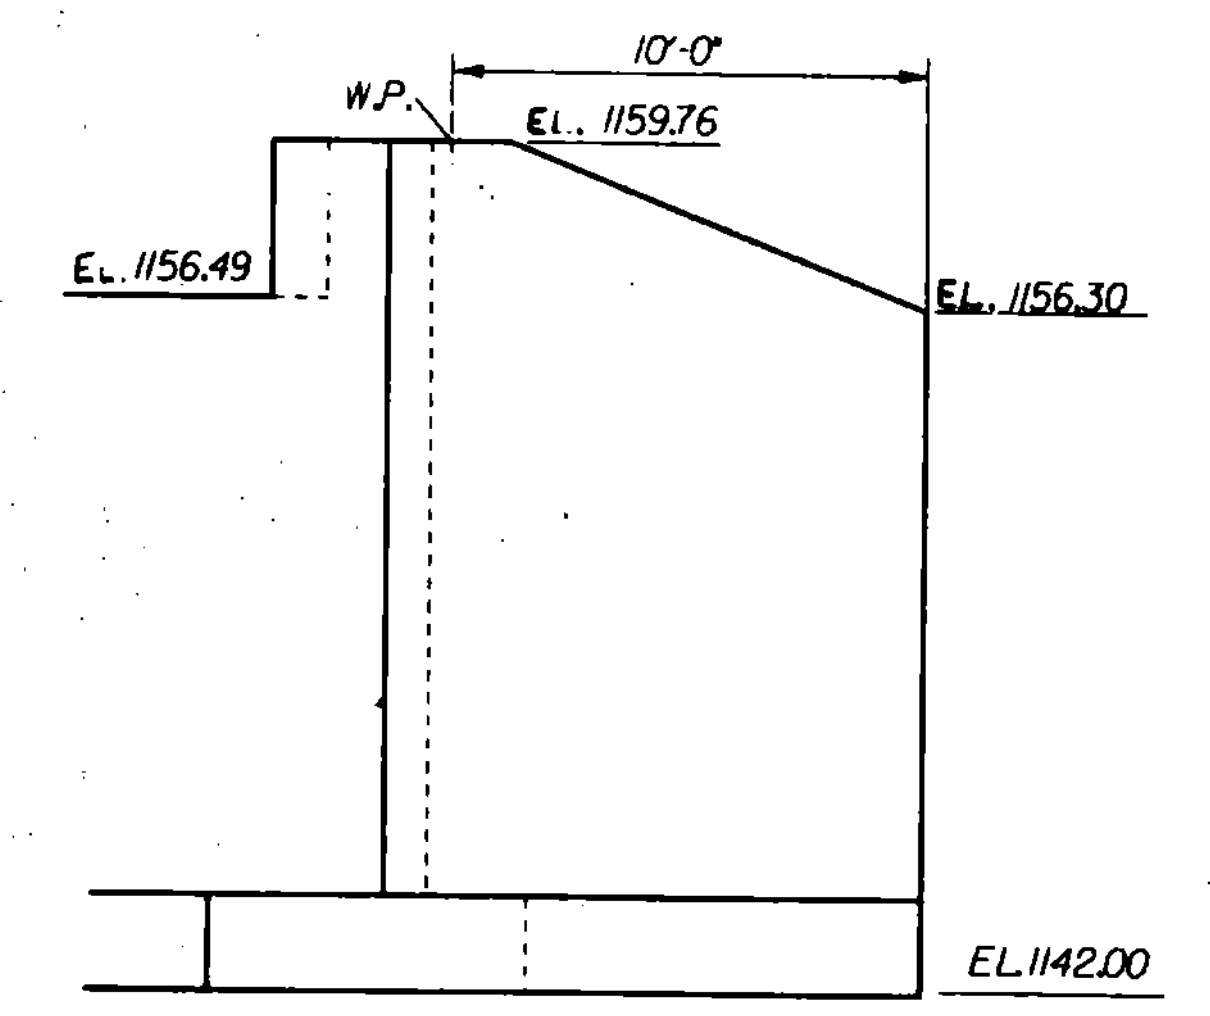

ELEVATION WINGWALL 4
SCALE 1/4" = 1'-0"

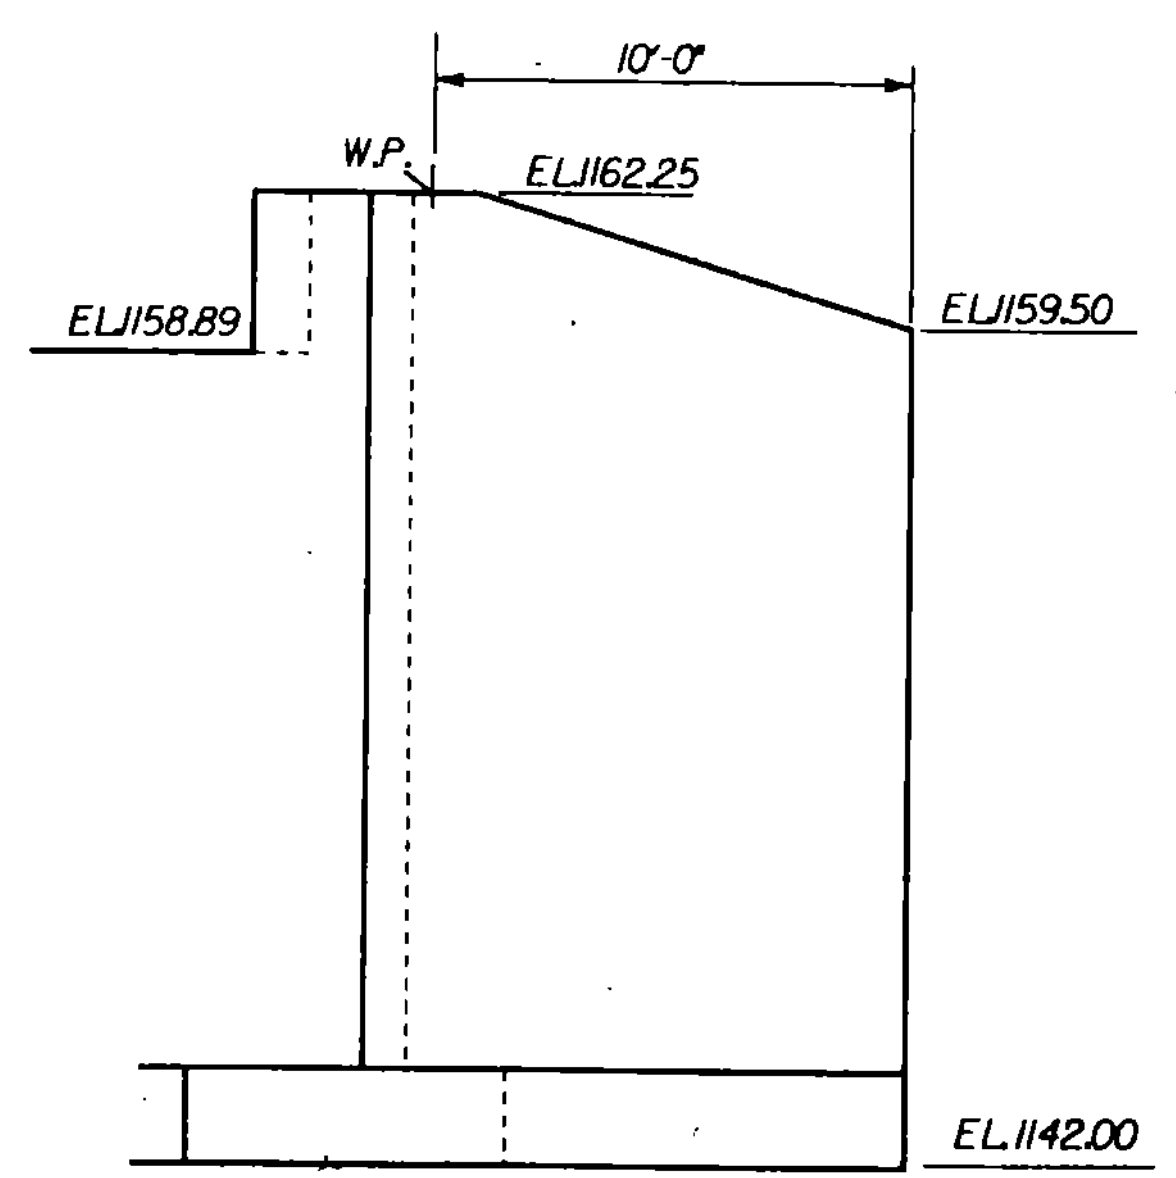

ELEVATION WINGWALL 1
SCALE 1/4" = 1'-0"

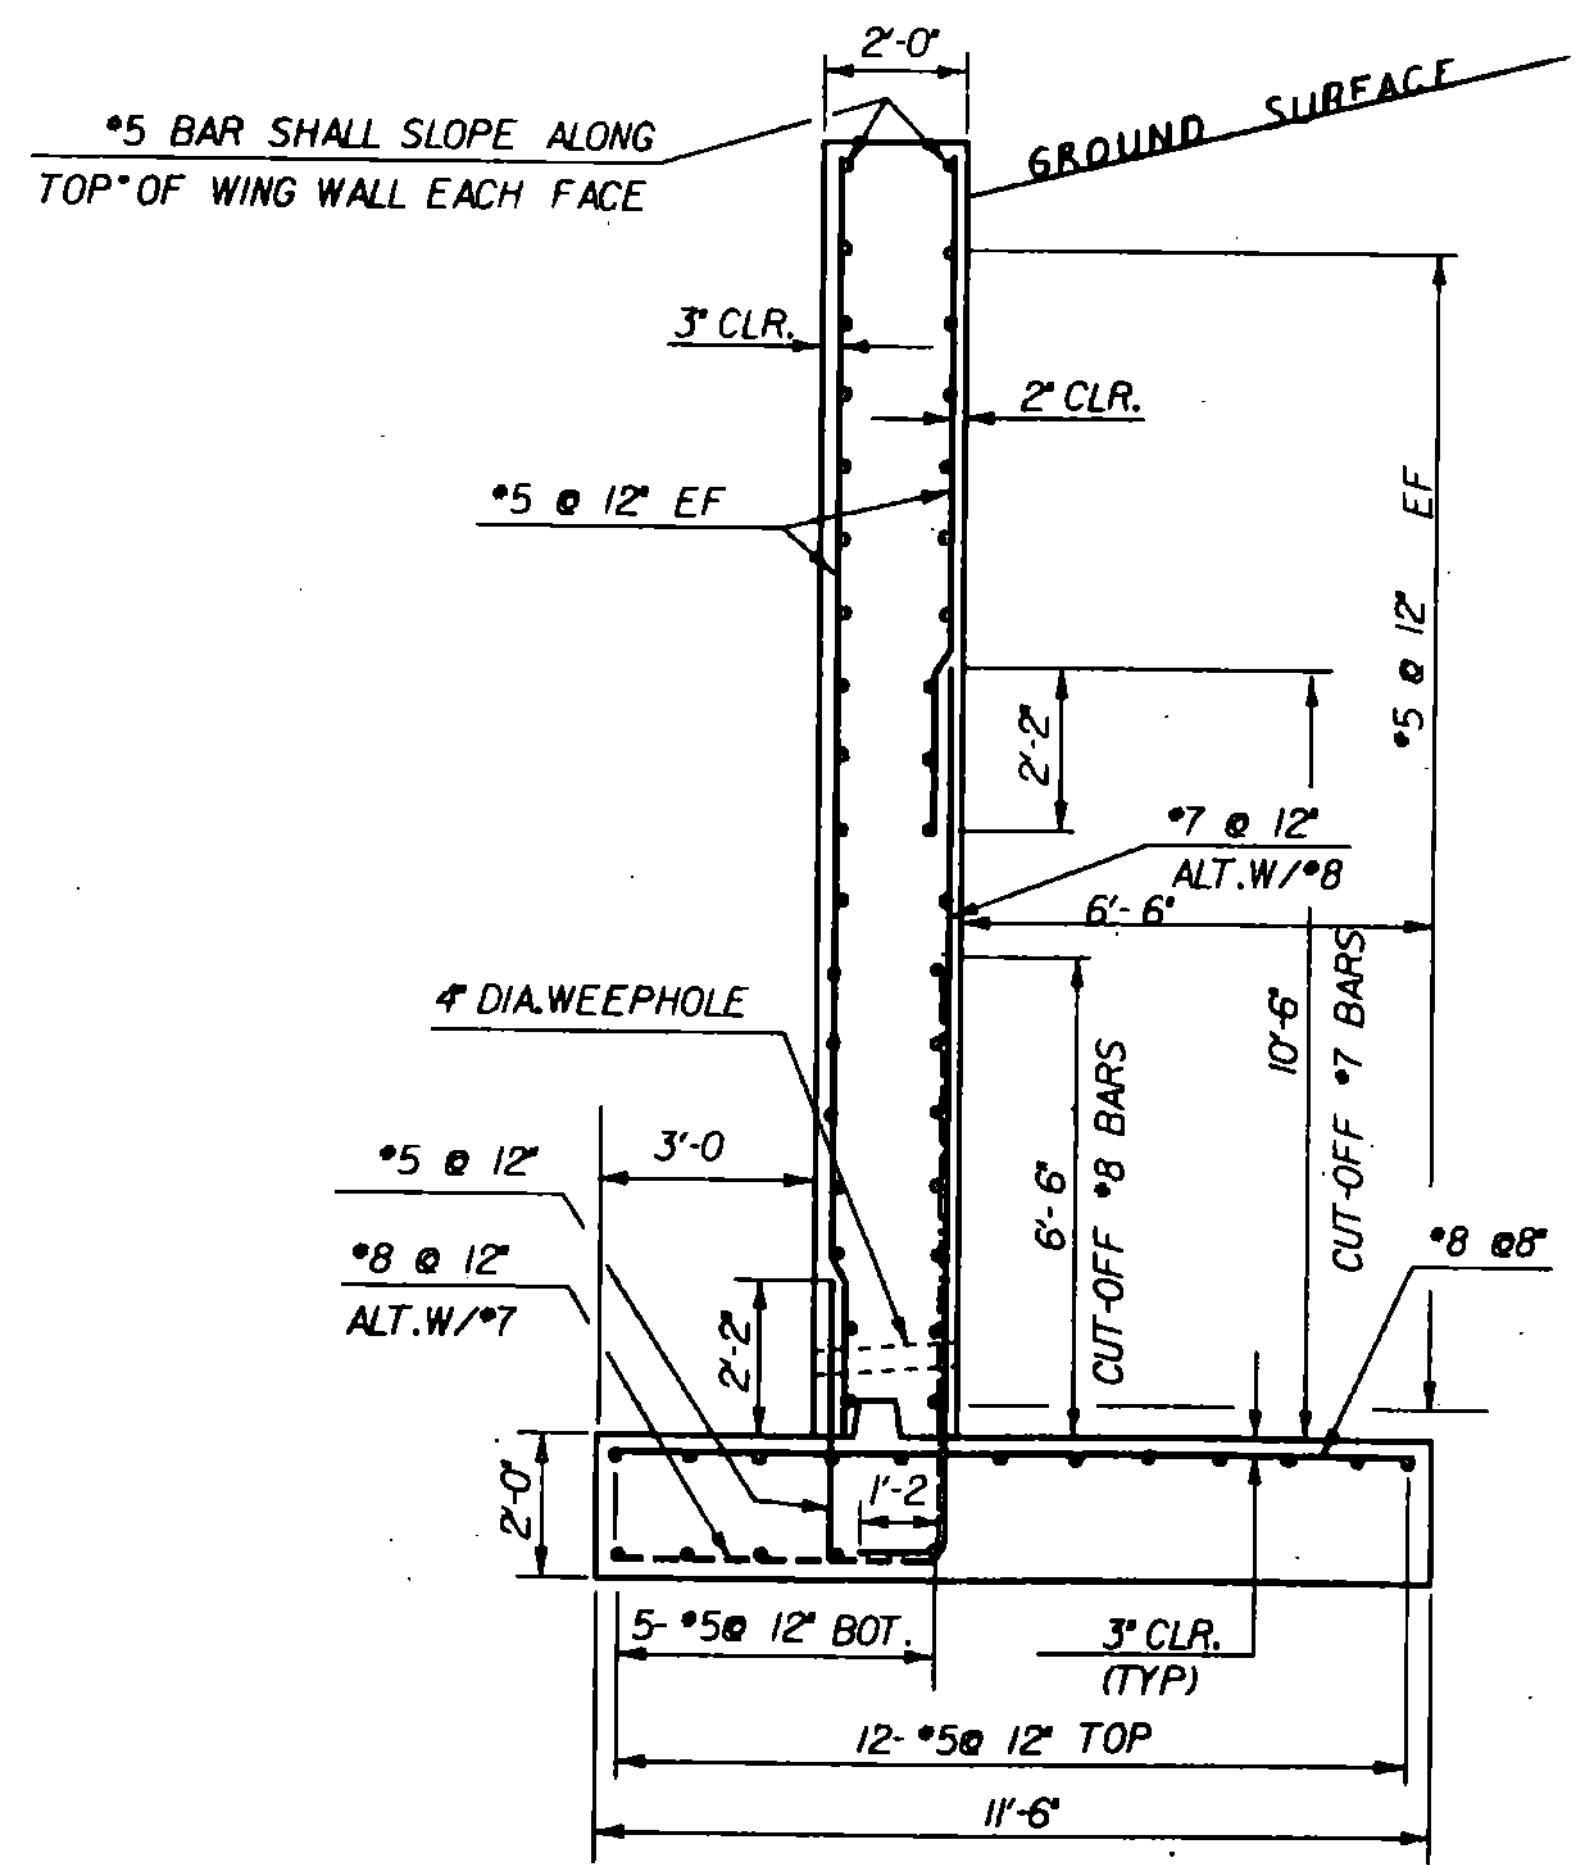

TYPICAL WING WALL SECTION
SCALE 3/8" = 1'-0"

STATE OF VERMONT			
AGENCY OF TRANSPORTATION			
Town Of	CHARLESTON	Bridge No.	B24
Highway No.	TH3	Log Sta.	
		Surv. Sta.	52+28
TH 3 OVER CLYDE RIVER			
WINGWALL DETAILS			
Designed By	ACHURCH	Drawn By	SINCLAIR
Checked By	DATE	Bridge Design Supervisor	
	C.WILLIAMS	R. GENDRON	DATE 1-89
PROJECT	CHARLESTON	PROJECT NO.	BRZ 1449(14)
			CHARLAZ
I.D.C. Info. ZFA1130,56163C560ABT.DGN		Bridge Sheet No.	
		Sheet 13 OF 33	

PLOTTED 6/JUN/89