

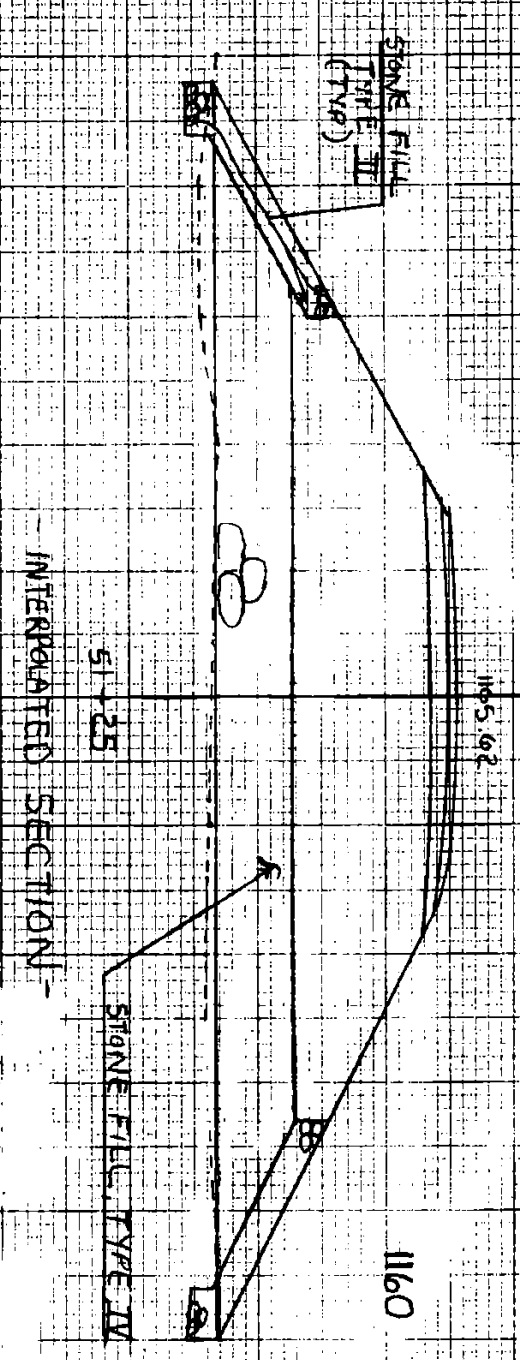



NOTE:
TOP 1" O. D. of
STONE FILL SHALL
BE SAVED.

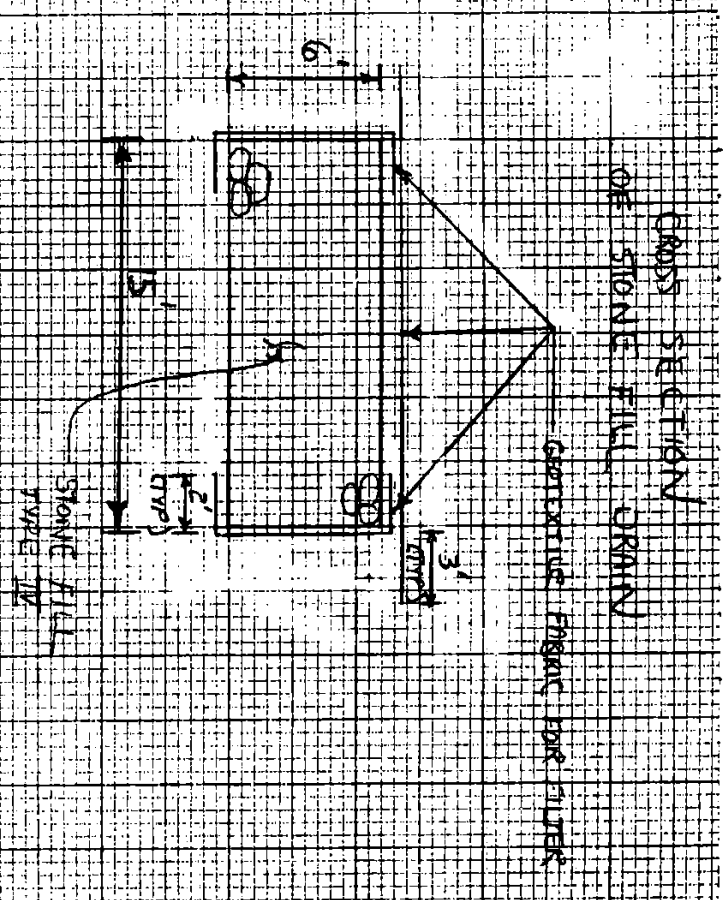


CROSS SECTION
OF STONE FILL DRAIN
Detailed Figure 108-175B

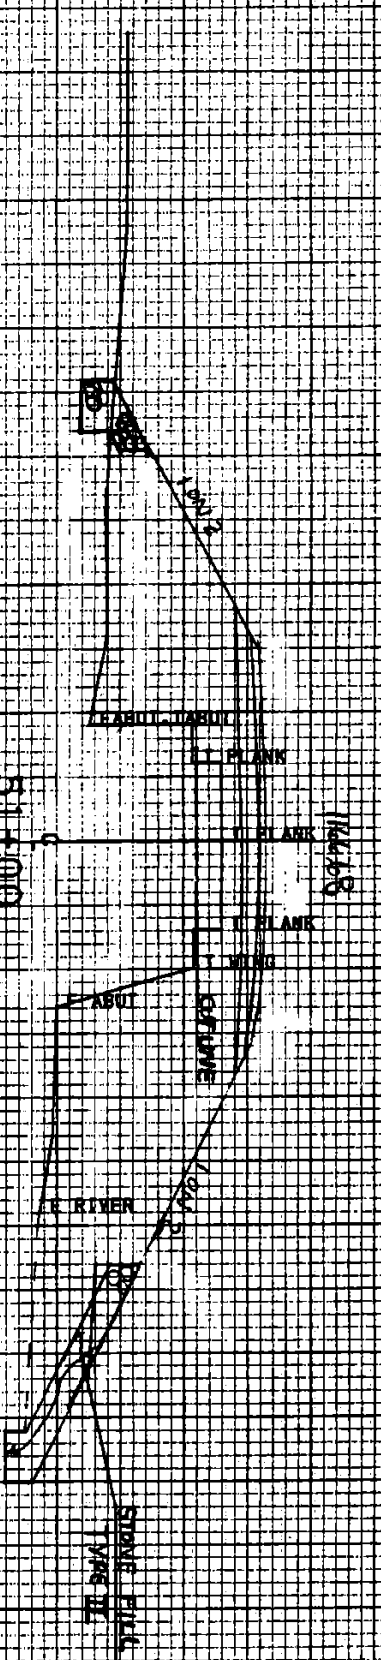


ENDS STONE FILL DRAIN (SEE FIGURE 108-175A)
ENDS COMPLETE DRAIN FOR FIGURE 108-175A

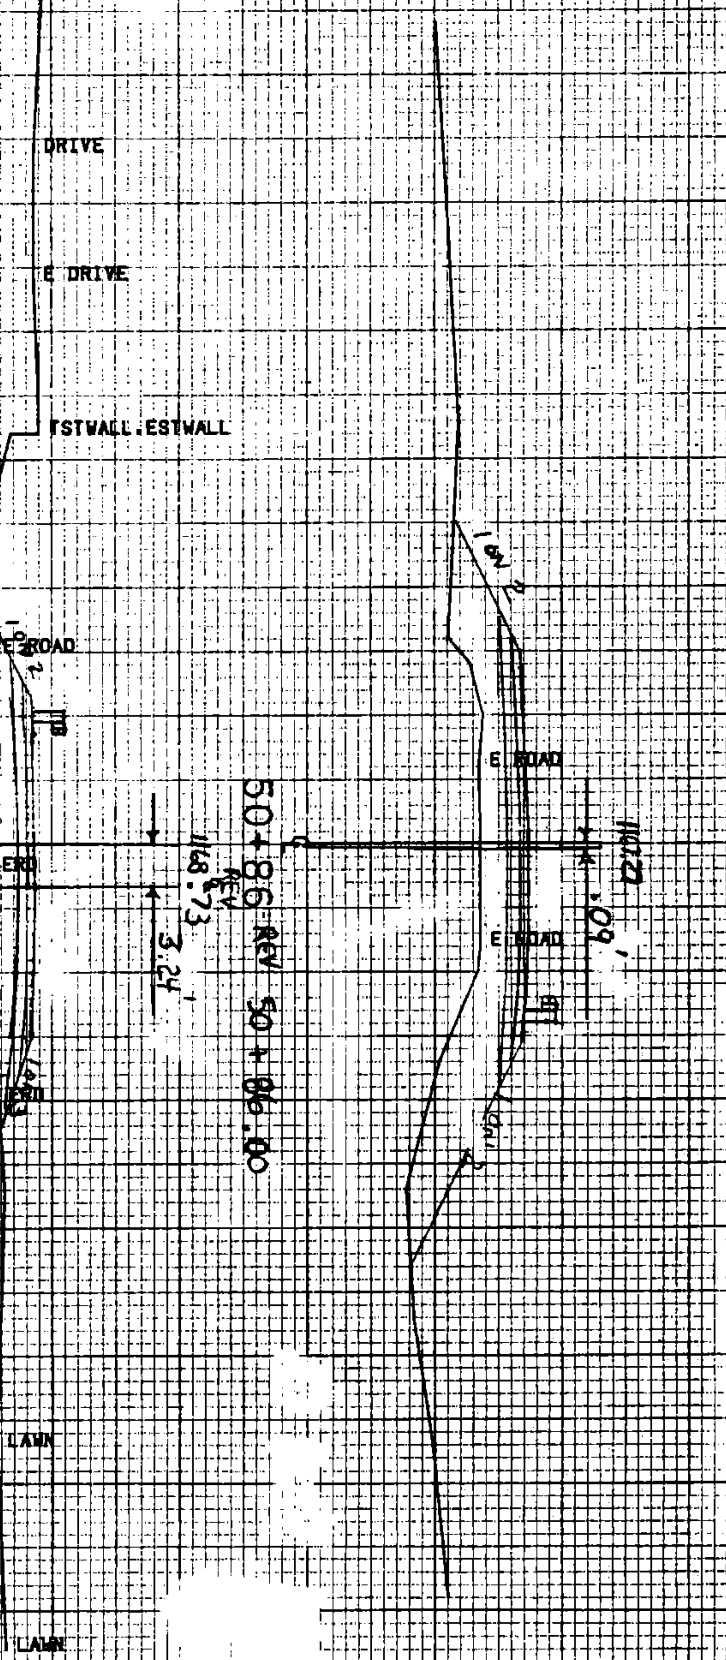


ENDS STONE FILL DRAIN (SEE FIGURE 108-175A)
ENDS COMPLETE DRAIN FOR FIGURE 108-175A

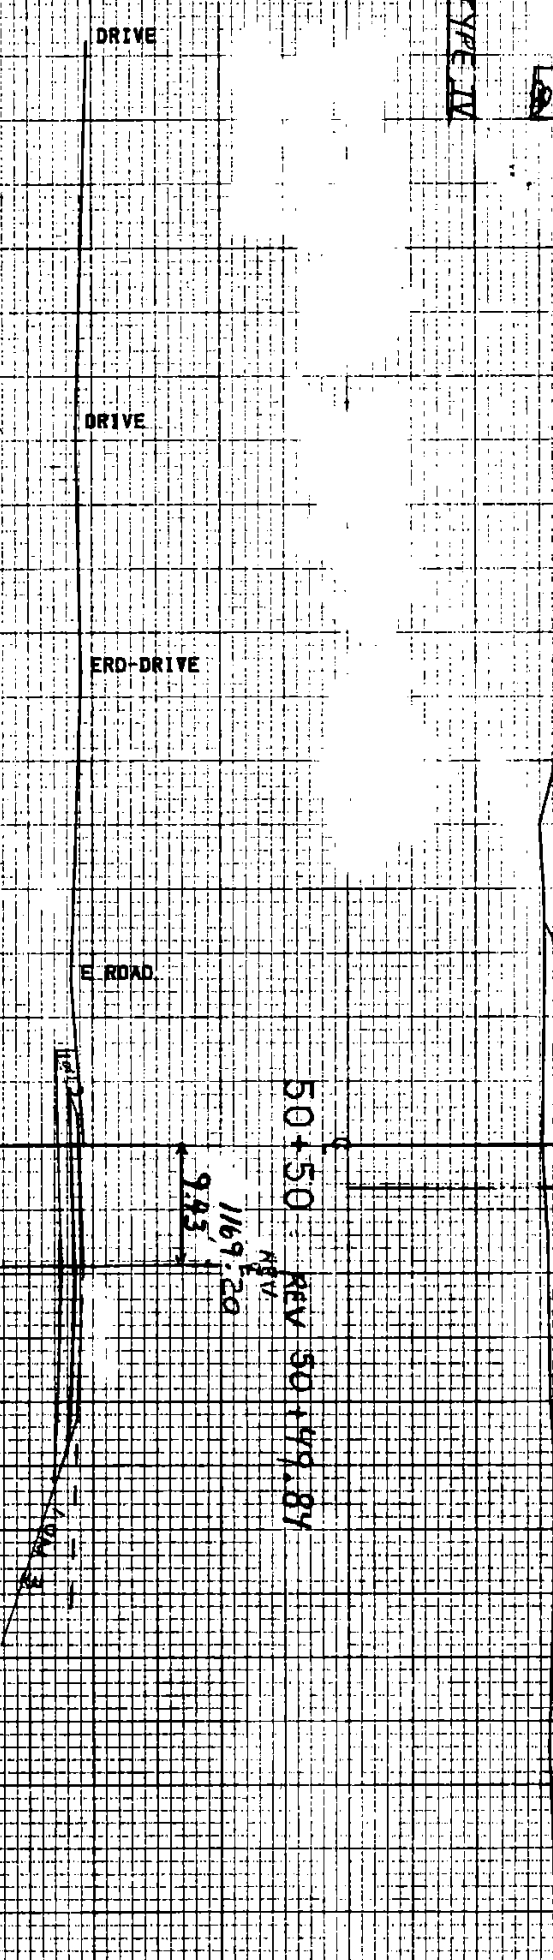

ENDS STONE FILL DRAIN (SEE FIGURE 108-175A)
ENDS COMPLETE DRAIN FOR FIGURE 108-175A

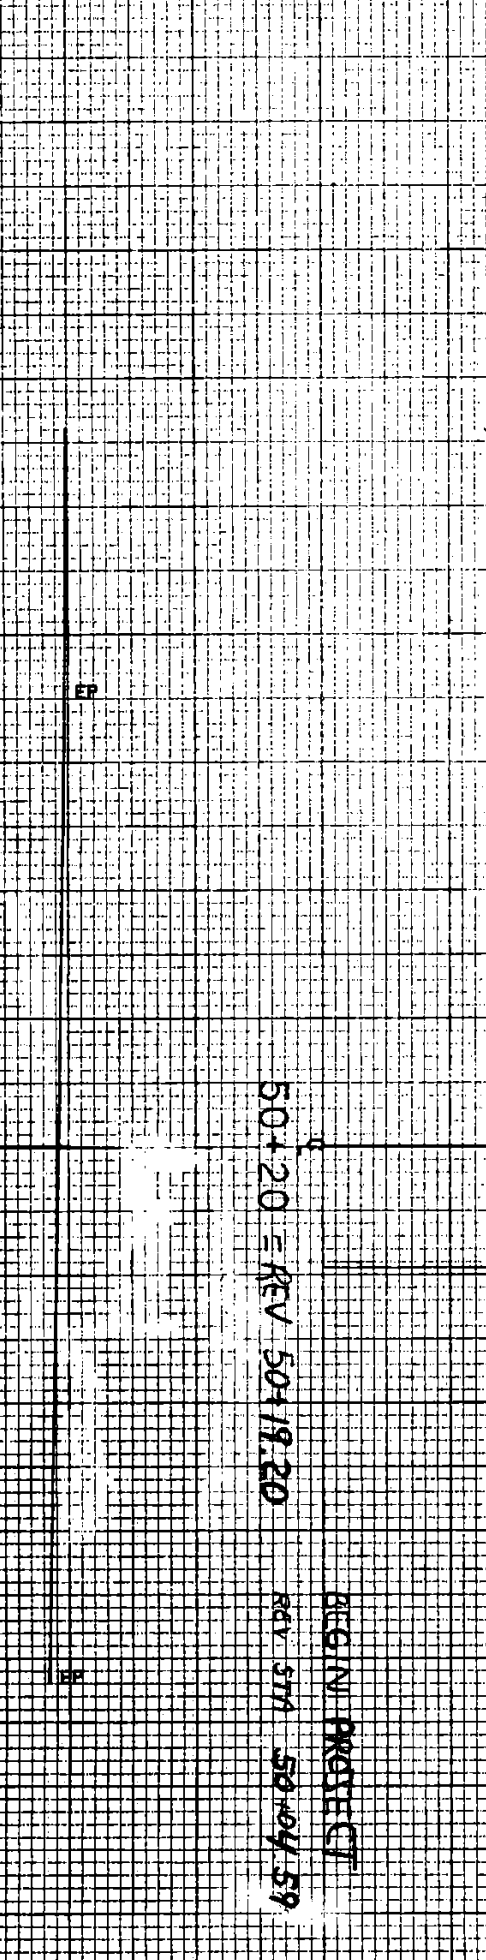

ENDS STONE FILL DRAIN (SEE FIGURE 108-175A)
ENDS COMPLETE DRAIN FOR FIGURE 108-175A

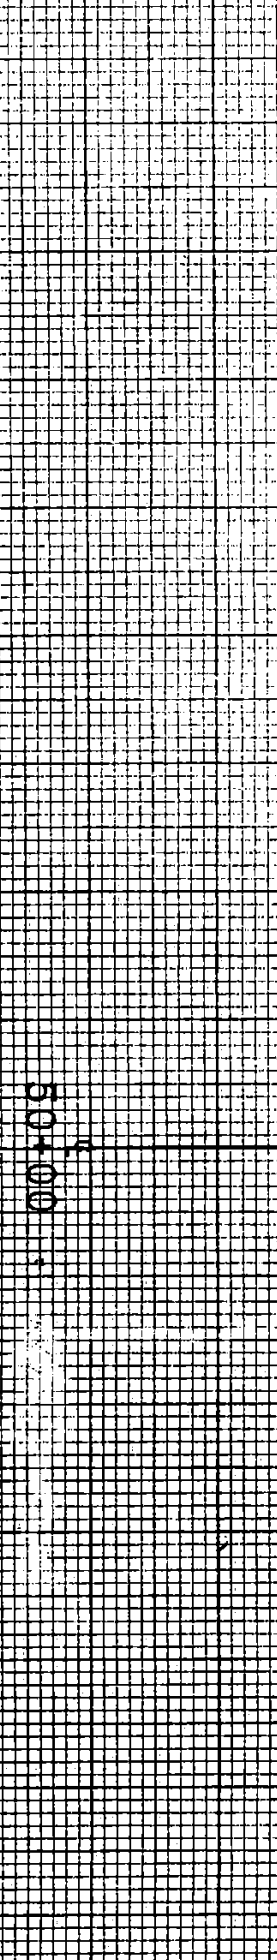

ENDS STONE FILL DRAIN (SEE FIGURE 108-175A)
ENDS COMPLETE DRAIN FOR FIGURE 108-175A

PROJECT NO. 108-175A
SHEET NO. 108-175A-1
DATE 10/1/59
BY J. S. [unclear]
CHECKED BY [unclear]
APPROVED BY [unclear]