


6+00

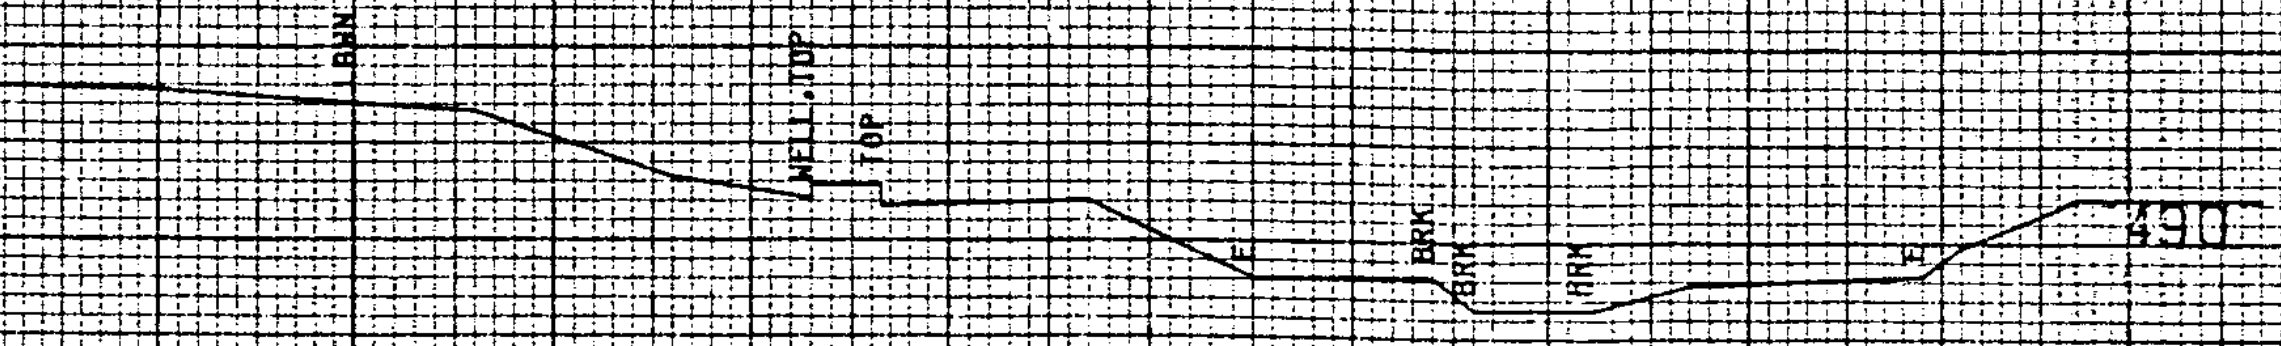

FROM STA. 6+00 TO STA. 6+00  
PROJECT NAME MORRISTOWN CHAN  
NO. FH3531 PLOTTED 07/20/84  
SURVEYED BY FANTONI JULY 1984  
SHEET 029 SHEETS

SCALE 10 FEET