



TYPICAL SECTIONS - T.H. 46

2" Bituminous Concrete Pavement, Item 406.25 (1 Lift, Type II)





18" Subbase of Dense Graded Crushed Stone

6" Sand Borrow

Shoulders: 3" Aggregate Shoulders

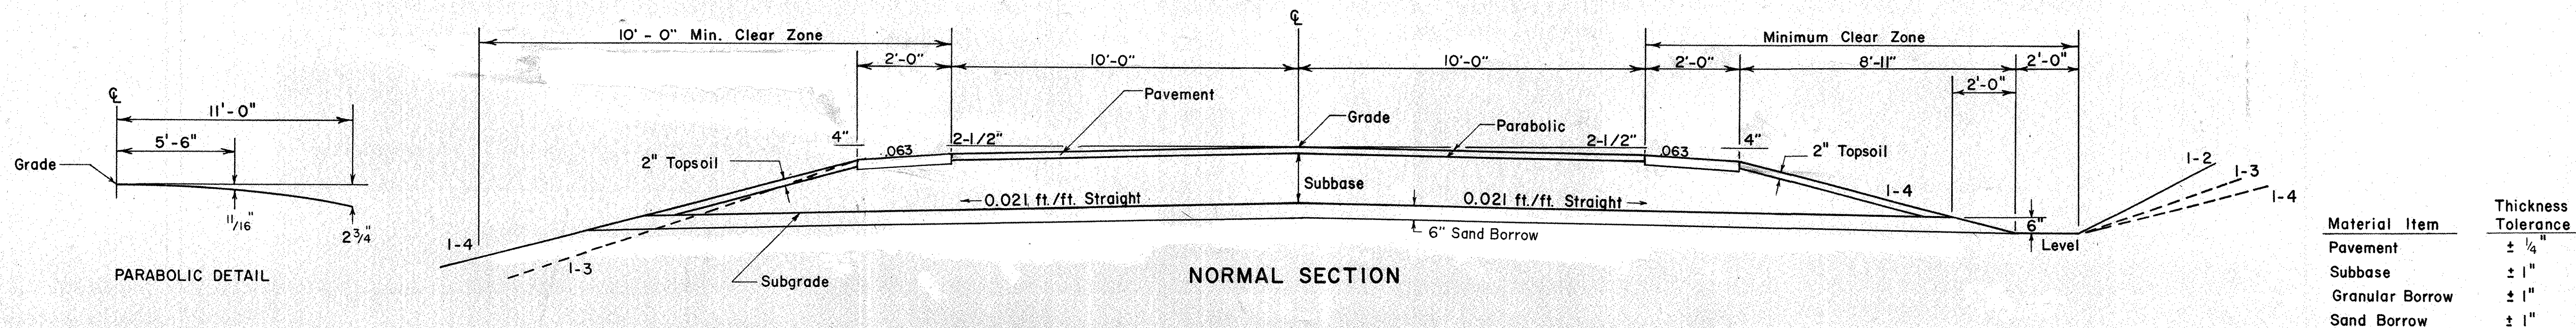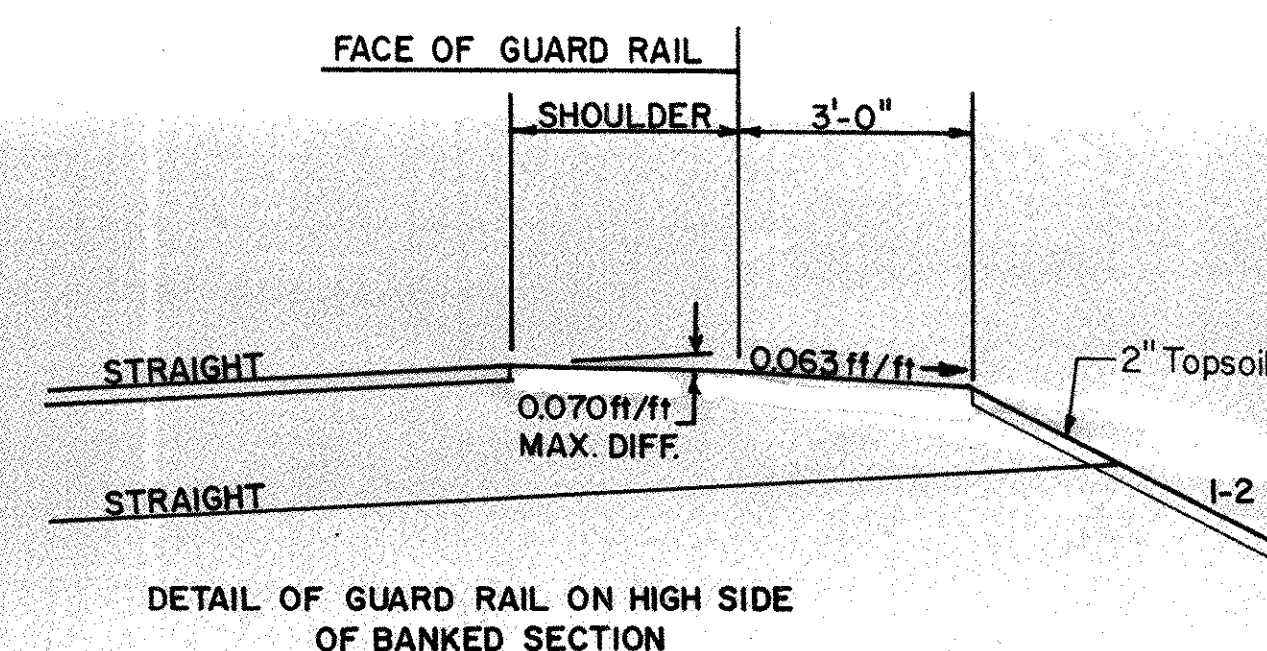

Material Item	Thickness Tolerance
Pavement	± 1/4"
Subbase	± 1"
Granular Borrow	± 1"
Sand Borrow	± 1"

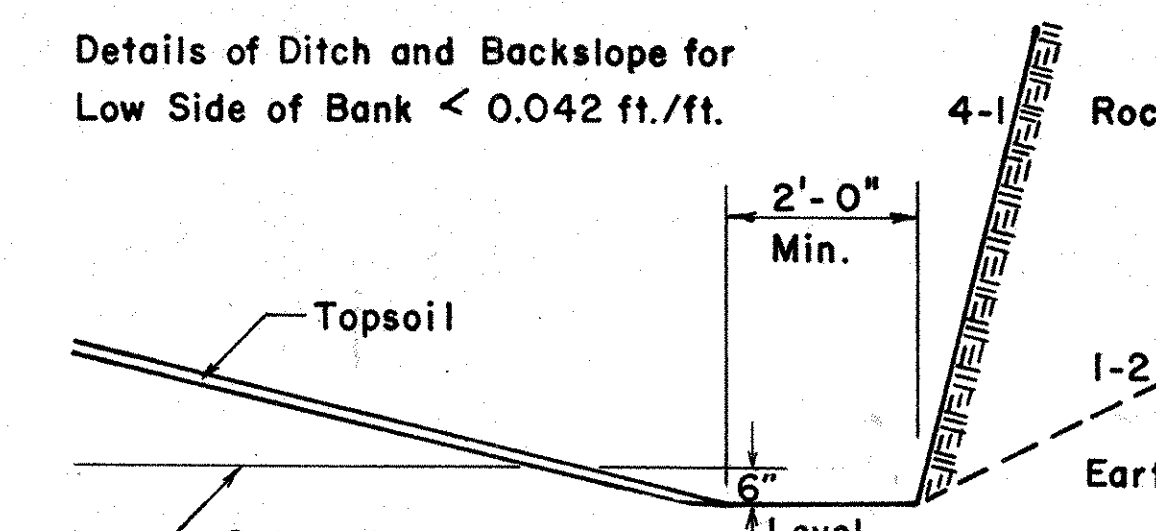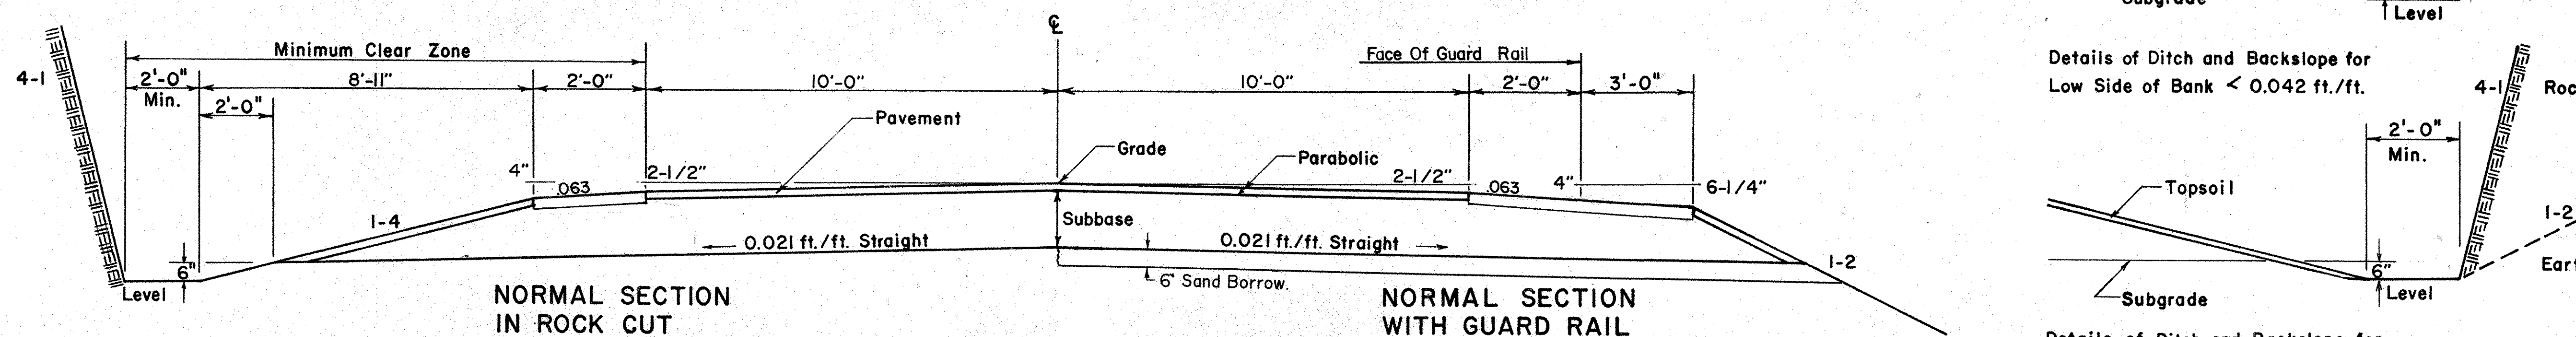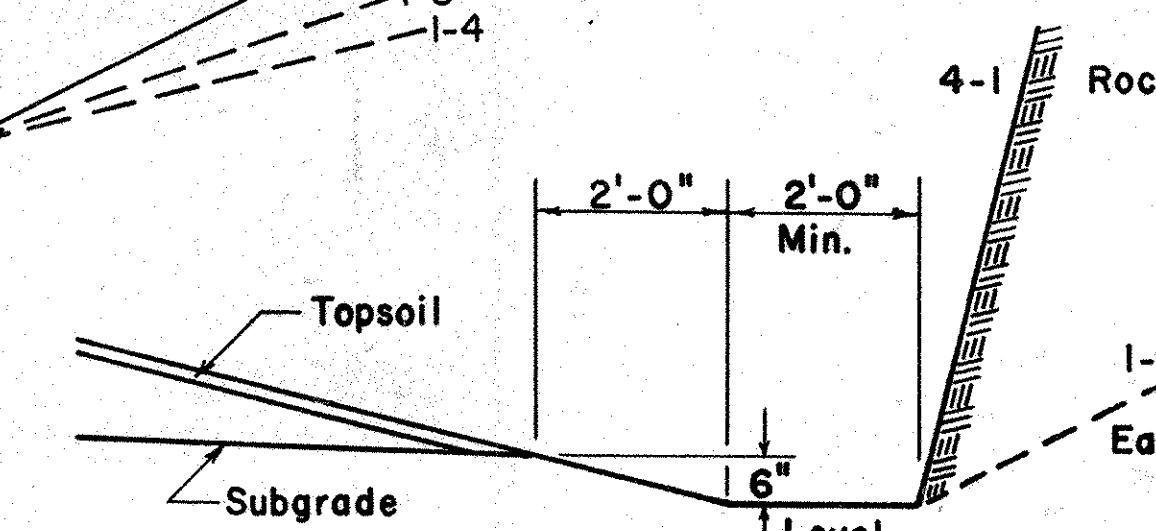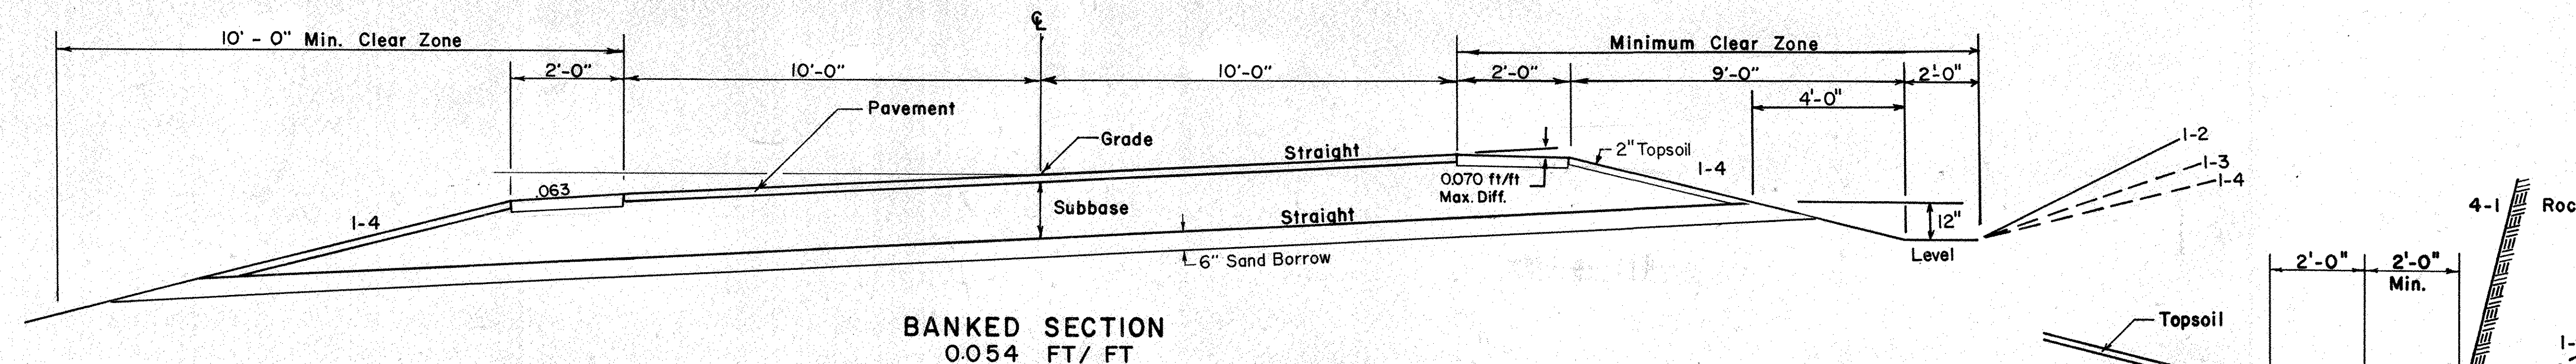

For slopes in Solid Rock Excavation and Drilling and Blasting of Solid Rock Subgrade, see Standard Sheet A-61.

BUILT AS DESIGNED

SEEDING FORMULA, ITEM 651.15 RURAL AREAS

% WT	LBS/A	NAME	PUR. %	GERM. %
3.33	2	CROWN VETCH	97	75
50.00	30	CREeping RED FESCUE	98	85
8.33	5	TIMOTHY	99	85
16.67	10	PERENNIAL RYE GRASS (VAR. PENNFINE)	95	85
8.34	5	ALFALFA (VAR. SARANAC)	99	85
8.33	5	BIRDSFOOT TREFLOIL (VAR. EMPIRE)	98	85
2.500	3	HIGHLAND BENT GRASS	92	85
00.00	60			

THE SEED MIXTURE SHALL NOT HAVE A WEED CONTENT EXCEEDING 0.40% BY WEIGHT AND SHALL BE FREE FROM ALL NOXIOUS WEED SEED.

GENERAL NOTES

- SEED - TO BE APPLIED PER SEEDING FORMULA AS DIRECTED BY THE ENGINEER.
- FERTILIZER - FORMULA 10-20-10 TO BE USED WITH SEED, APPLIED AT THE RATE OF 500 LBS/ACRE.
- AGRICULTURAL LIMESTONE - TO BE APPLIED AT THE RATE OF 2 TONS/ACRE OR AS DIRECTED BY THE ENGINEER.
- HAY MULCH - TO BE PLACED ON EARTH SLOPES AT THE RATE OF 2 TONS/ACRE OR AS DIRECTED BY THE ENGINEER.
- TOPSOIL - TO BE USED WITH SEED AS INDICATED ON THE PLANS OR AS DIRECTED BY THE ENGINEER.
- MARKER POSTS (WOOD OR STEEL, AS SPECIFIED) - TO BE PLACED AS DIRECTED BY THE ENGINEER.
- SLOPE ROUNDING - ALL CUT SLOPES TO BE ROUNDED IN ACCORDANCE WITH STANDARD SHEET B-5.
- PAY LIMITS OF SAND BORROW WHEN USED IN CONJUNCTION WITH UNDERDRAIN - SEE STANDARD SHEET D-2.

TYPICAL SECTIONS FOR EAST MONTPELIER

PROJECT RS

NO. 0246 (1)

SHEET 3 OF 128 SHEETS