



TYPICAL SECTIONS-TH 54

6" AGGREGATE SURFACE COURSE (±1")
 6" SUBBASE OF DENSE GRADED CRUSHED STONE.
 6" SAND BORROW

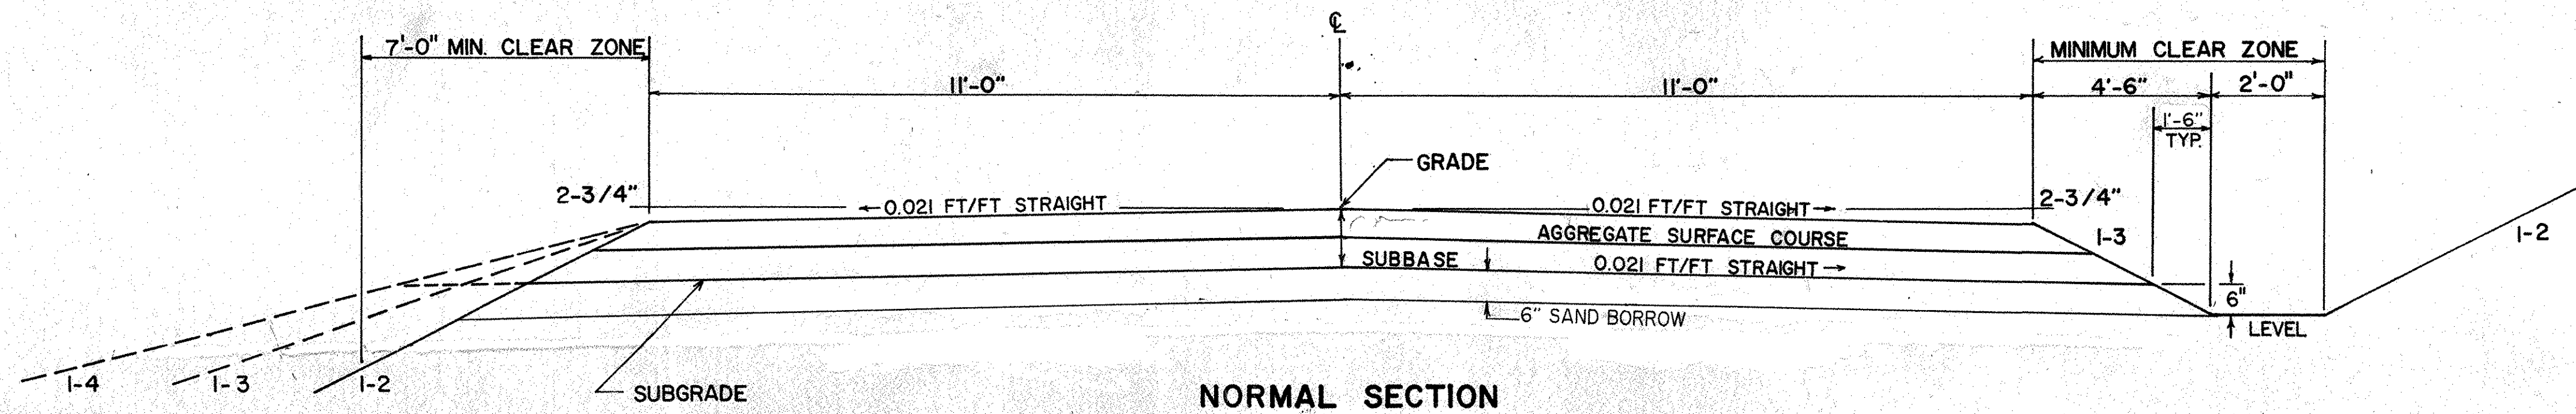


MATERIAL ITEM	PERMISSIBLE THICKNESS TOLERANCE
SUBBASE	± 1"
GRANULAR BORROW	± 1"
SAND BORROW	± 1"

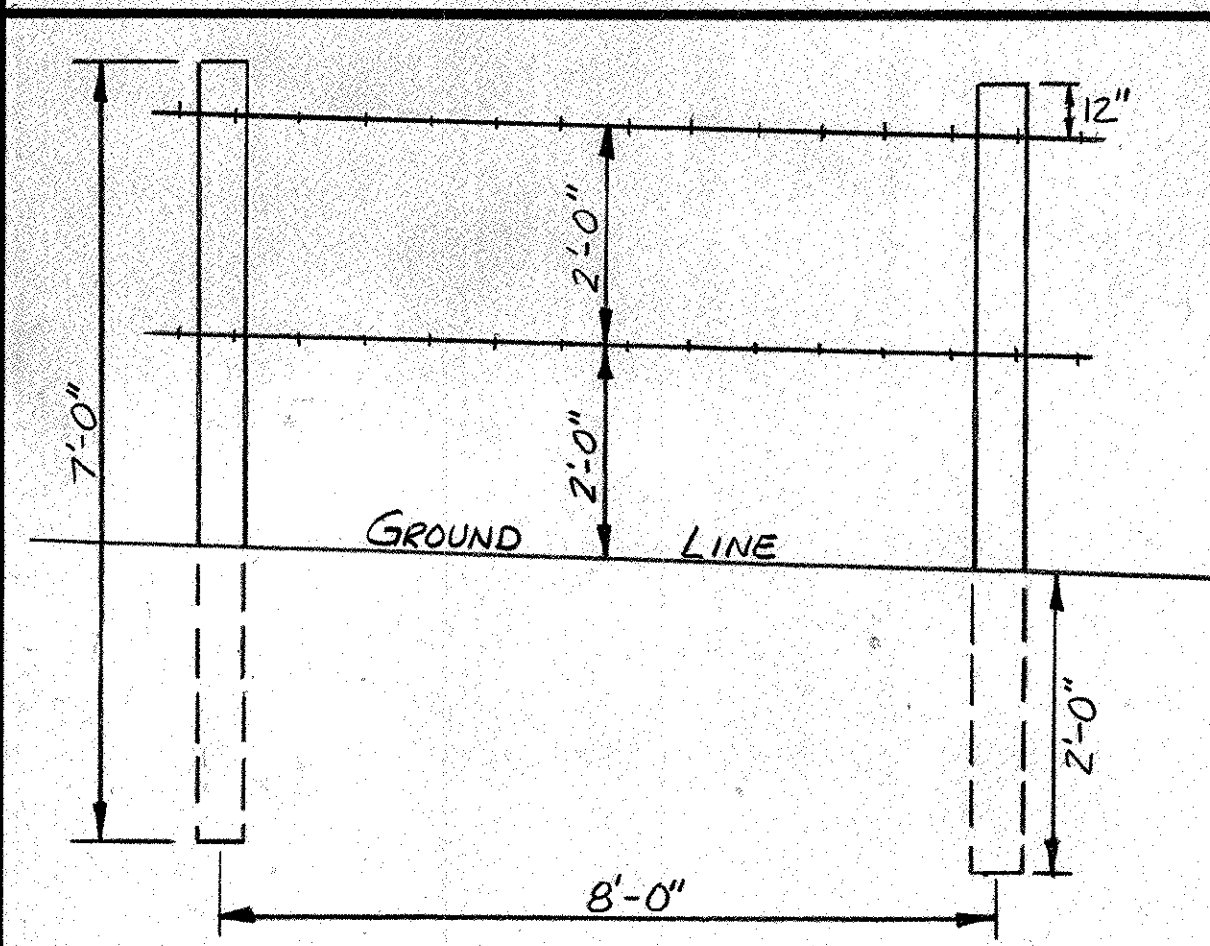


TYPICAL OF BARBED WIRE FENCE


- NOTES:
- ALL POSTS SHALL BE SEASONED CEDAR, STRAIGHT, SOUND AND NO LESS THAN 4-1/2 INCHES IN DIAMETER AT THE SMALL END OR GREATER THAN 5-1/2 INCHES IN DIAMETER AT THE GROUND LINE.
 - BARBED WIRE SHALL CONFORM TO REQUIREMENTS FOR ZINC-COATED (GALVANIZED) STEEL BARBED WIRE, ASTM A 121, 2 STRAND STANDARD SIZE NO. 12 -1/2, COATING CLASS NO. 3
 - STAPLES SHALL BE AT LEAST 1-1/4 INCHES LONG OF NO. 9 GALVANIZED WIRE.

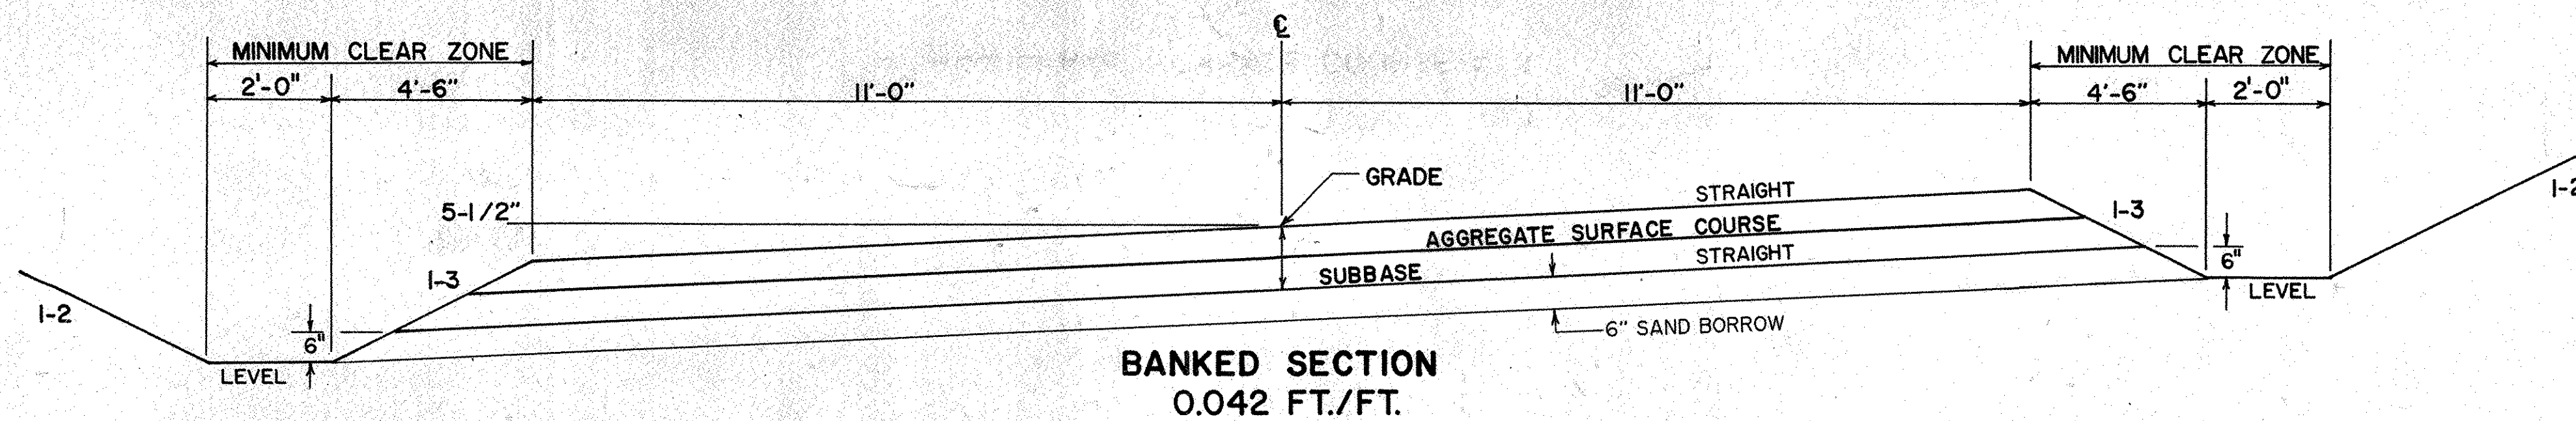

BANKED SECTION
0.042 FT./FT.

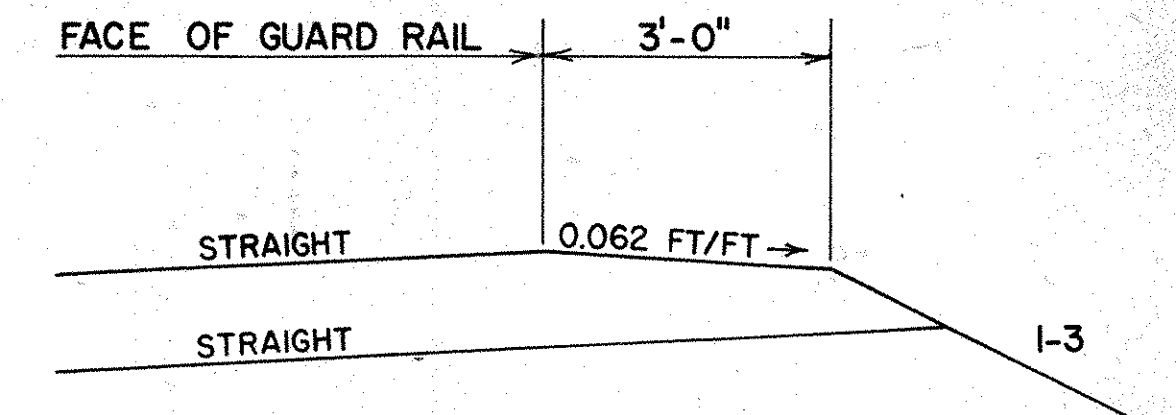

DETAIL OF GUARD RAIL ON HIGH SIDE OF BANKED CURVE

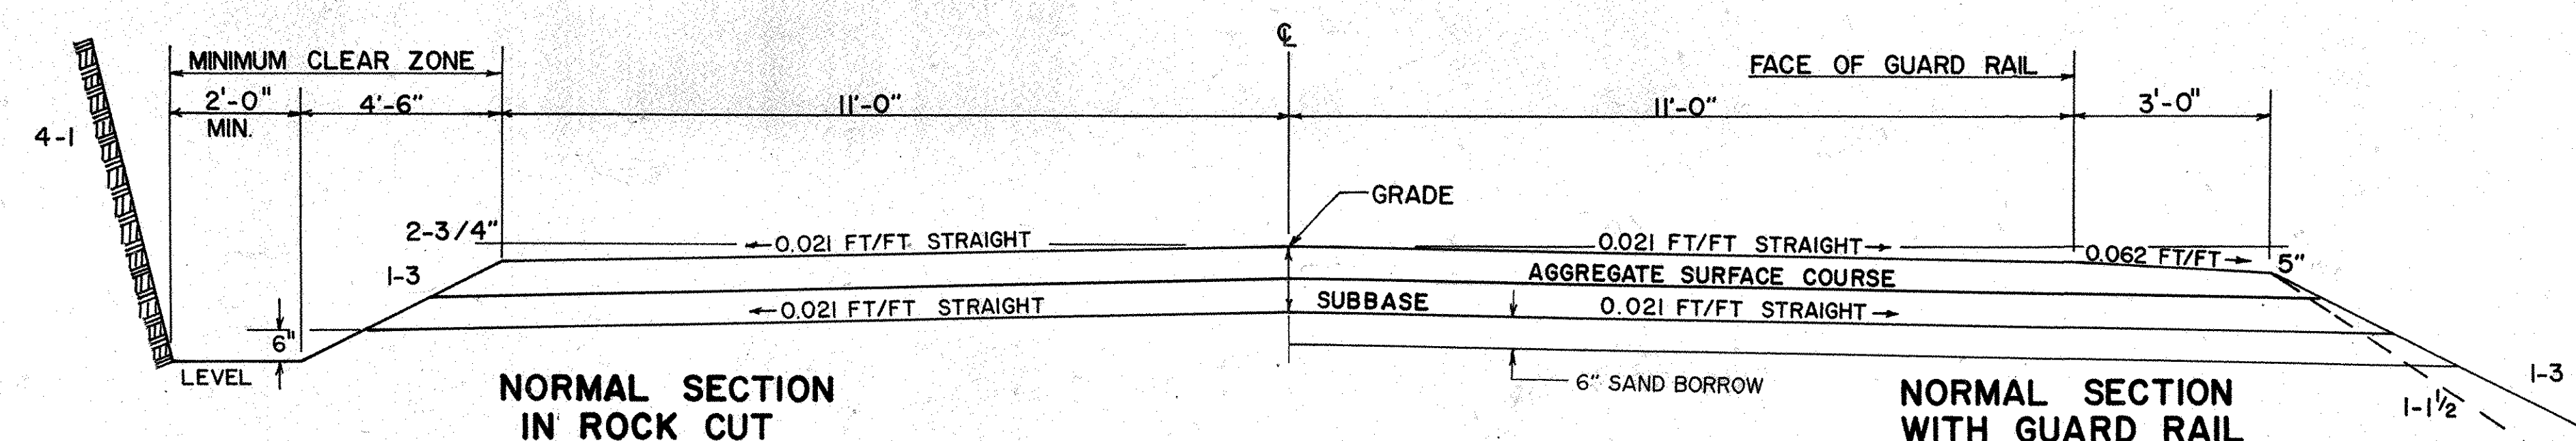

NORMAL SECTION
IN ROCK CUT

NORMAL SECTION
WITH GUARD RAIL

FOR SLOPES IN SOLID ROCK EXCAVATION AND DRILLING AND BLASTING OF SOLID ROCK SUBGRADE, SEE STANDARD SHEET A-61.

BUILT AS DESIGNED

SEEDING FORMULA
SEE SHEET 2

GENERAL NOTES

- SEED- TO BE APPLIED PER SEEDING FORMULA AS DIRECTED BY THE ENGINEER.
- FERTILIZER-FORMULA 10-20-10 TO BE USED WITH SEED, APPLIED AT THE RATE OF 500 LBS/ACRE.
- AGRICULTURAL LIMESTONE-TO BE APPLIED AT THE RATE OF 2 TONS/ACRE OR AS DIRECTED BY THE ENGINEER.
- HAY MULCH- TO BE PLACED ON EARTH SLOPES AT THE RATE OF 2 TONS/ACRE OR AS DIRECTED BY THE ENGINEER.
- TOPSOIL - TO BE USED WITH SEED AS INDICATED ON THE PLANS OR AS DIRECTED BY THE ENGINEER.
- MARKER POSTS (WOOD OR STEEL, AS SPECIFIED)- TO BE PLACED AS DIRECTED BY THE ENGINEER.
- SLOPE ROUNDING- ALL CUT SLOPES TO BE ROUNDED IN ACCORDANCE WITH STANDARD SHEET B-5.
- PAY LIMITS OF SAND BORROW WHEN USED IN CONJUNCTION WITH UNDERDRAIN-SEE STANDARD SHEET D-2

TYPICAL SECTIONS FOR
EAST MONTPELIER

PROJECT RS
NO. 0246(1)

SHEET 4 OF 128 SHEETS