


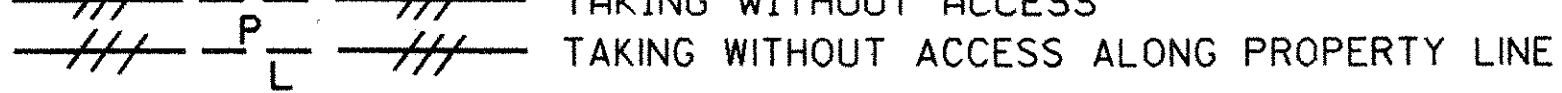
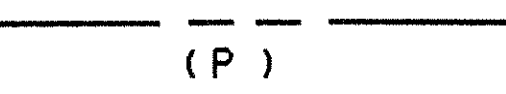
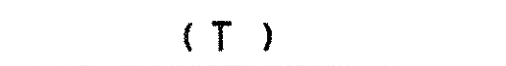

STATE OF VERMONT
AGENCY OF TRANSPORTATION
TABLE OF PROJECT PROPERTY ACQUISITION
RIGHT OF WAY PLANS
DETAIL SHEET

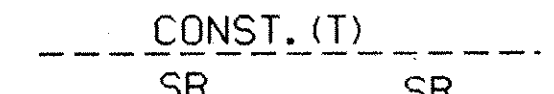
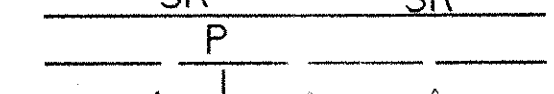

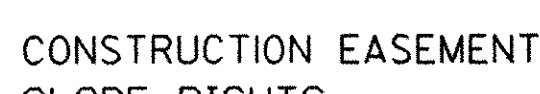
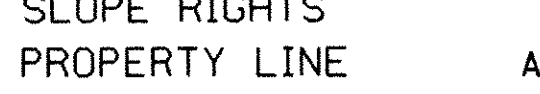
PARCEL NO.	GRANTOR	SHEET NO.	BEGINNING STATION	ENDING STATION	TAKING	REM.	RIGHTS	TITLE TAKEN	DATE	TOWN OR CITY RECORDED	BK.	PG.	REMARKS	REVISION NO.	SHEET	DESCRIPTION OF REVISION	DATE	MADE BY	APPROVED BY	
7A	HAWKINS, DENNIS R. & NANCY L. HAWKINS, HUGH M. & SUSAN W. HAWKINS, HUGH C. & MARAH C. - LIFE ESTATE	12, 13, 14	REV. 122+05 RT. TH 54 REV. 10+60 LT. TH 54 REV. 11+00 LT. TH 54 REV. 11+20 LT. TH 54 REV. 11+05 LT. REV. 122+05 RT. 124+80 RT. 125+00 RT. 128+30 RT. 130+00 RT. 129+50 RT. 128+60 RT. 130+00 RT. 128+30 RT. 131+26 RT. 131+50 RT. 131+66 RT. 132+36 RT. 130+90 RT. 132+71 RT. 132+84 RT. 133+25 CL 134+72 RT. 135+00 RT. 135+20 RT. 136+00 RT. 140+00 RT. 140+18 RT. 140+64 RT. REV. 148+80 RT. REV. 148+80 RT. REV. 148+80 RT. REV. 150+15 RT.	144+50 RT. TH 54 REV. 11+15 LT. 145+33 RT. 129+50 RT. 125+00 RT. 131+25 RT. 143+00 RT. 129+60 RT. 130+20 RT. 130+00 RT. 131+66 RT. 132+36 RT. 132+84 RT. 132+25 RT. 134+72 RT. 135+20 RT. 139+76 RT. 145+30 RT. REV. 150+15 RT. REV. 150+18 RT. REV. 150+03 RT.	0.63A±		LANDSCAPE (T) CUL. & DR. (P) CONST. (T) 0.65A± SLOPE (T) 0.53A± CUL. (P) DR. (P) DITCH (P) 0.08A± SLOPE (P) 0.63A± CUL. (P) CUL. (P) DR. (P) CUL. (P) DRIVE (P) DITCH (P) CUL. (P) DRIVE (T) DITCH (P) CUL. (P) DRIVE (T) DITCH (P) CUL. (P) DRIVE (T) DITCH (P) CUL. (P) SLOPE (T) 0.03A± CONST. (T) 0.03A± LANDSCAPE (T)	WOOE		E. MONTPELIER			TREE PLANTING FENCE 3425 S.F. ± 12' GRAVEL FENCE 20' GRAVEL WATERLINE 12' GRAVEL 16' GRAVEL 1310 S.F. ± 1300 TREES FENCE							
		7B		12, 13	125+20 LT. 129+68 LT. 129+85 LT. 131+75 LT. 132+00 LT. 134+00 LT.	129+50 LT. 132+60 LT.		DRIVE (T) CUL. (P) DRIVE (T) DRIVE (T)						FENCE 15' GRAVEL 40' GRAVEL FENCE 40' GRAVEL						
7C		13, 14	145+00 LT. 135+40 LT. 136+00 LT. 135+63 LT. 135+75 LT. 136+00 LT. 138+00 LT. 140+64 LT. 141+15 LT. REV. 149+71 LT.	REV. 150+02 LT. REV. 149+95 LT. 140+75 LT. 136+25 LT. REV. 150+02 LT. 140+50 LT. REV. 150+01 LT.	0.06A±		CONST. (T) 0.36A± CUL., DIT. & DR. (P) SLOPE (T) 0.08A± REMOVE & RESET (T) DITCH (P) CUL., DIT. & DR. (P) SLOPE (T) 0.39A± DRIVE (T)						2500 S.F. ± 3655 S.F. ± WATERLINE FENCE 12' GRAVEL							

PARCEL NO. 7 CONTINUED ON NEXT SHEET

ACCT. RYAN
ZFHCT0,1163E3630.DGN
PRF: 63E36303
DATE PLOTTED 21-FEB-1991

DR. (T)- DRAINAGE RIGHT
DIT. (T)- DITCHING RIGHT
CH. (T)- CHANNEL RT.
DRIVE (T)- DRIVE RIGHT
CUL. (T)- CULVERT RIGHT
[W]- WATER SOURCES

PRESENT R.O.W.
 TAKING WITHOUT ACCESS
 TAKING WITHOUT ACCESS ALONG PROPERTY LINE
 TAKING WITH ACCESS
 PERMANENT EASEMENT
 TEMPORARY EASEMENT

LEGEND
 CONSTRUCTION EASEMENT
 SLOPE RIGHTS
 PROPERTY LINE
 TOP OF CUT
 TOE OF SLOPE

APPROVED: LAWRENCE BLISS, L.S. DATE: 6-6-90
 AGENT D, PLANS & TITLES

This sheet for R.O.W. information only.

R. O. W. PLANS
 EAST MONTPELIER
 RSEGC RS 0246(1) SA
 SHEET 9 OF 16
 14 OF 123