
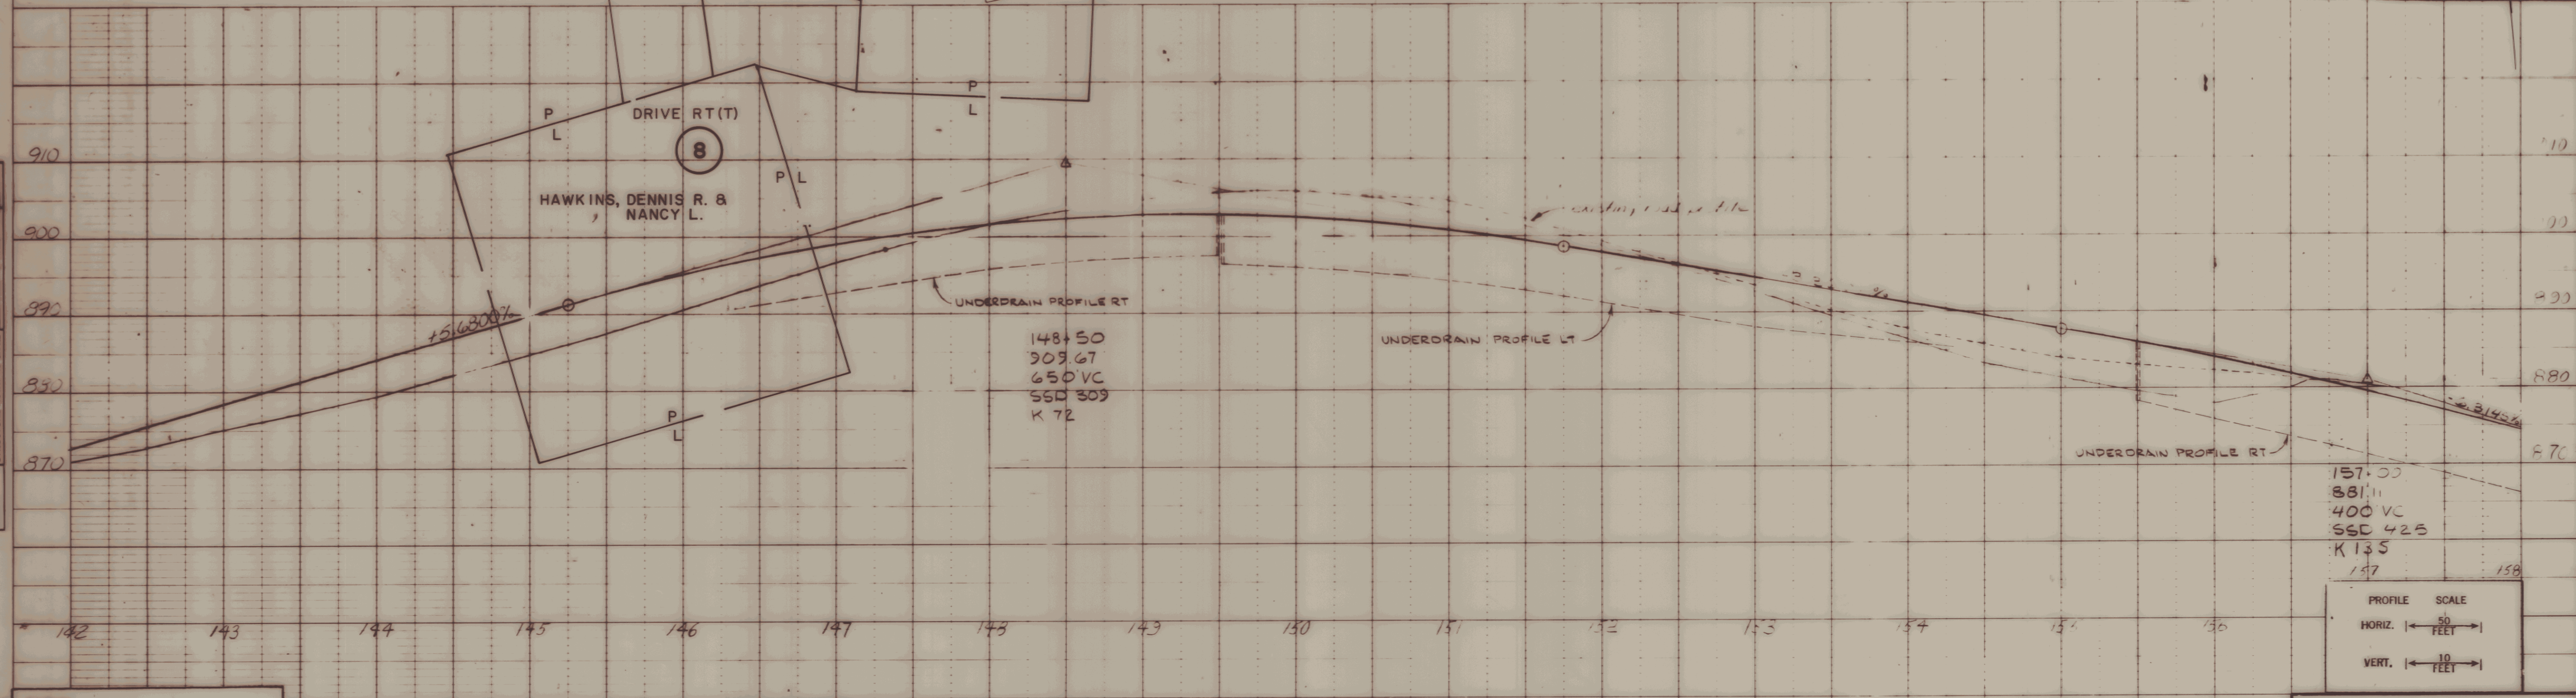


DATE	BY	REVISION

DATE	BY	REVISION

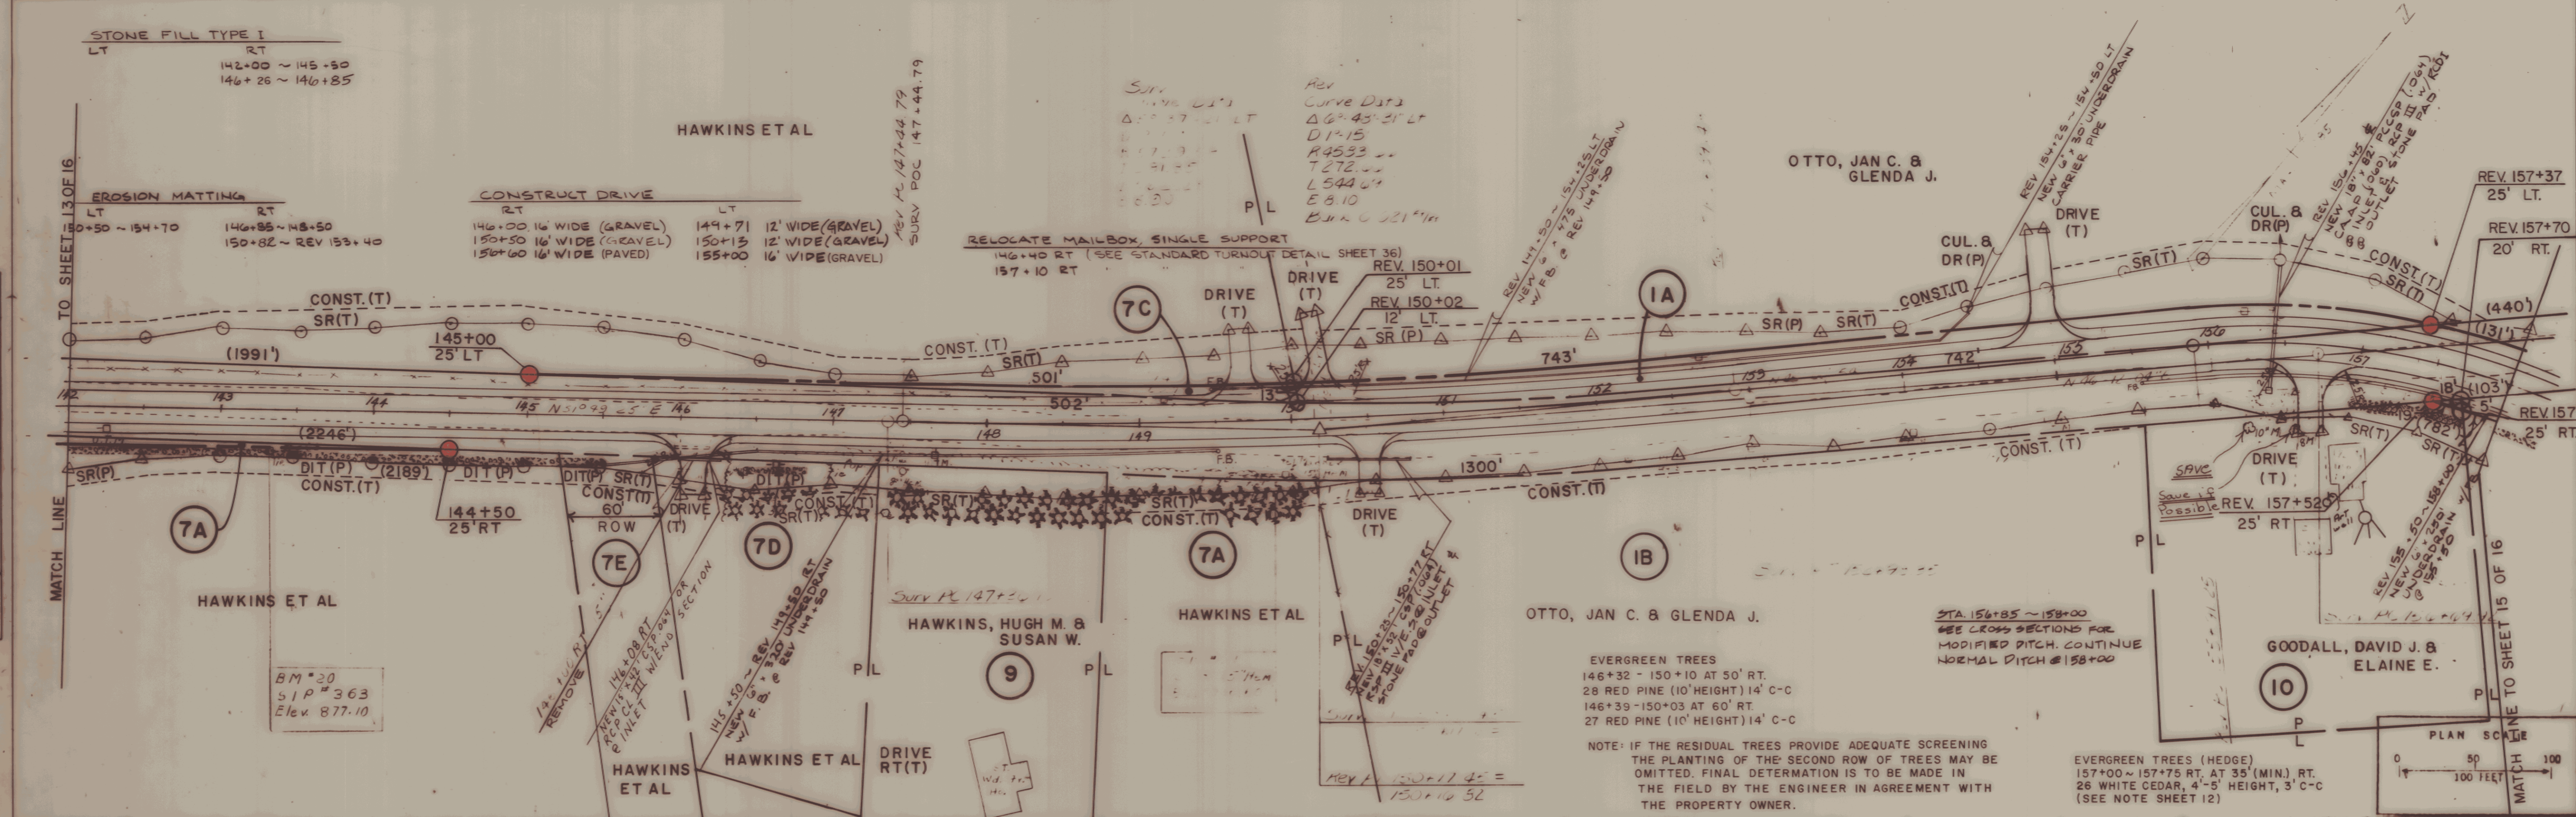

DATUM
 VERTICAL NGVD 329
 HORIZONTAL N/A

PROFILE SCALE
 HORIZ. 1" = 50 FEET
 VERT. 1" = 10 FEET

EAST MONTPELIER
 RSEGC-RS 0246(1) SA
 R.O.W. SHEET 14 OF 16

This sheet for R.O.W. information only.