
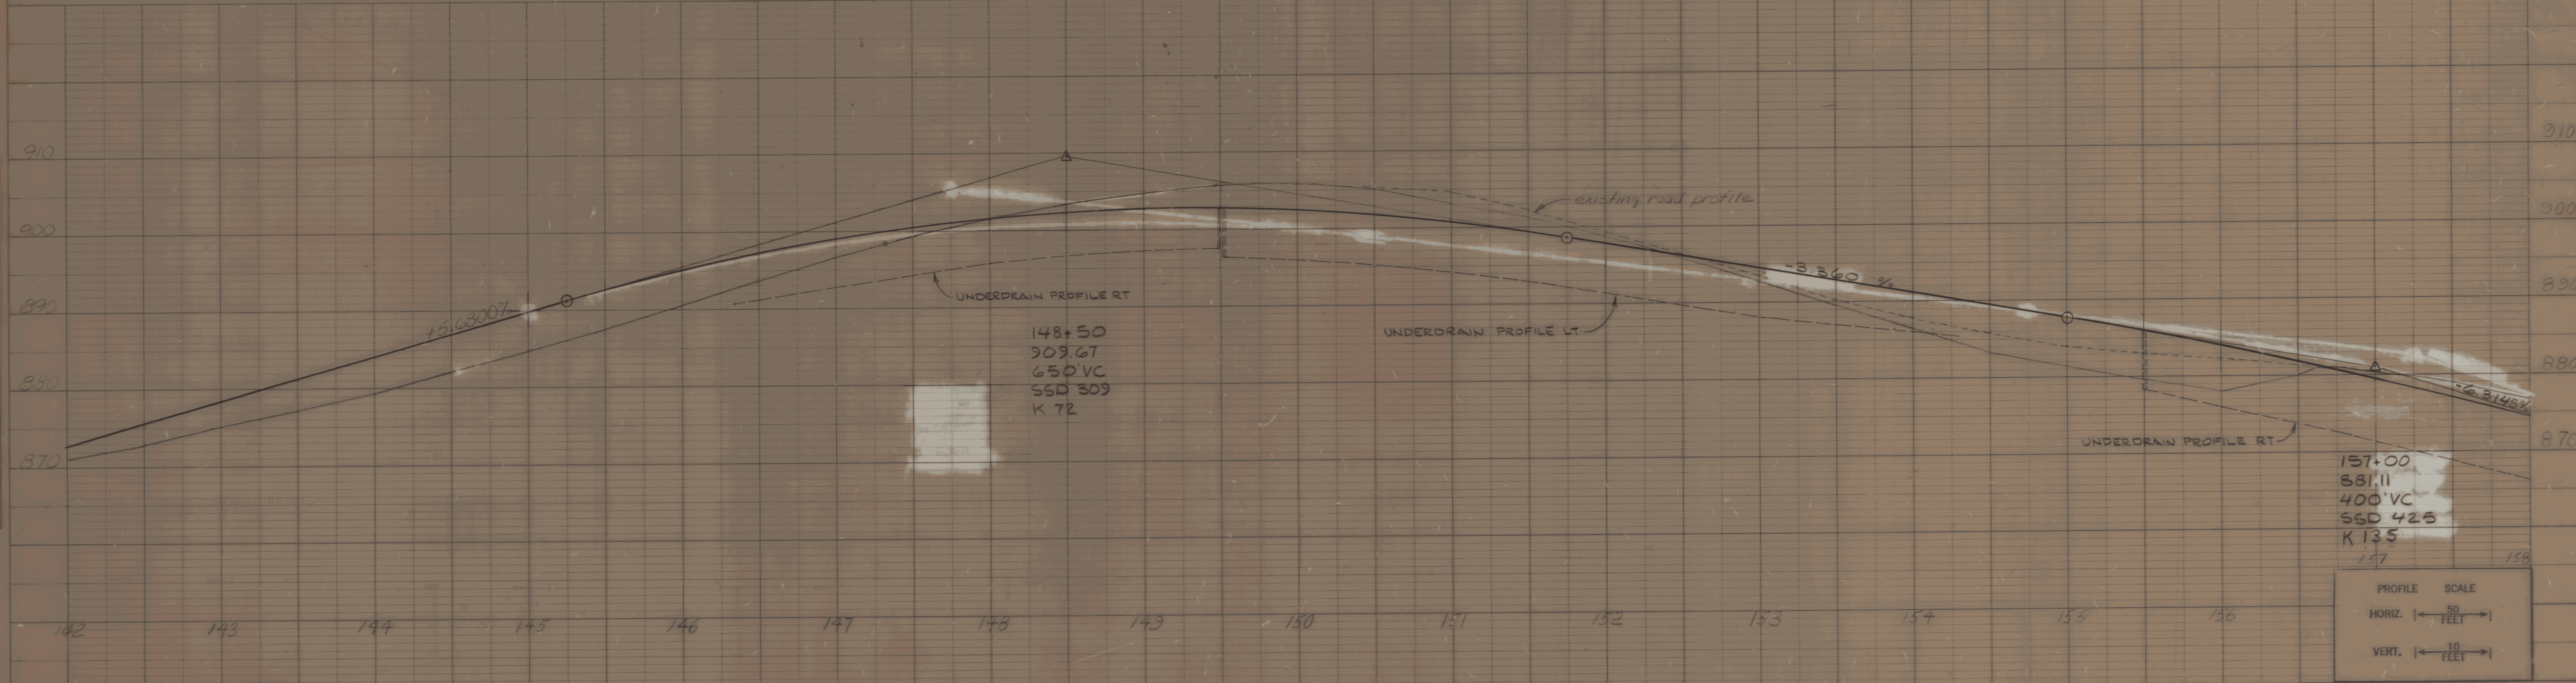


PLAN	DATE	
	BY	
NOTE BOOK	NO.	
	DATE	

PROFILE	DATE	
	BY	
NOTE BOOK	NO.	
	DATE	

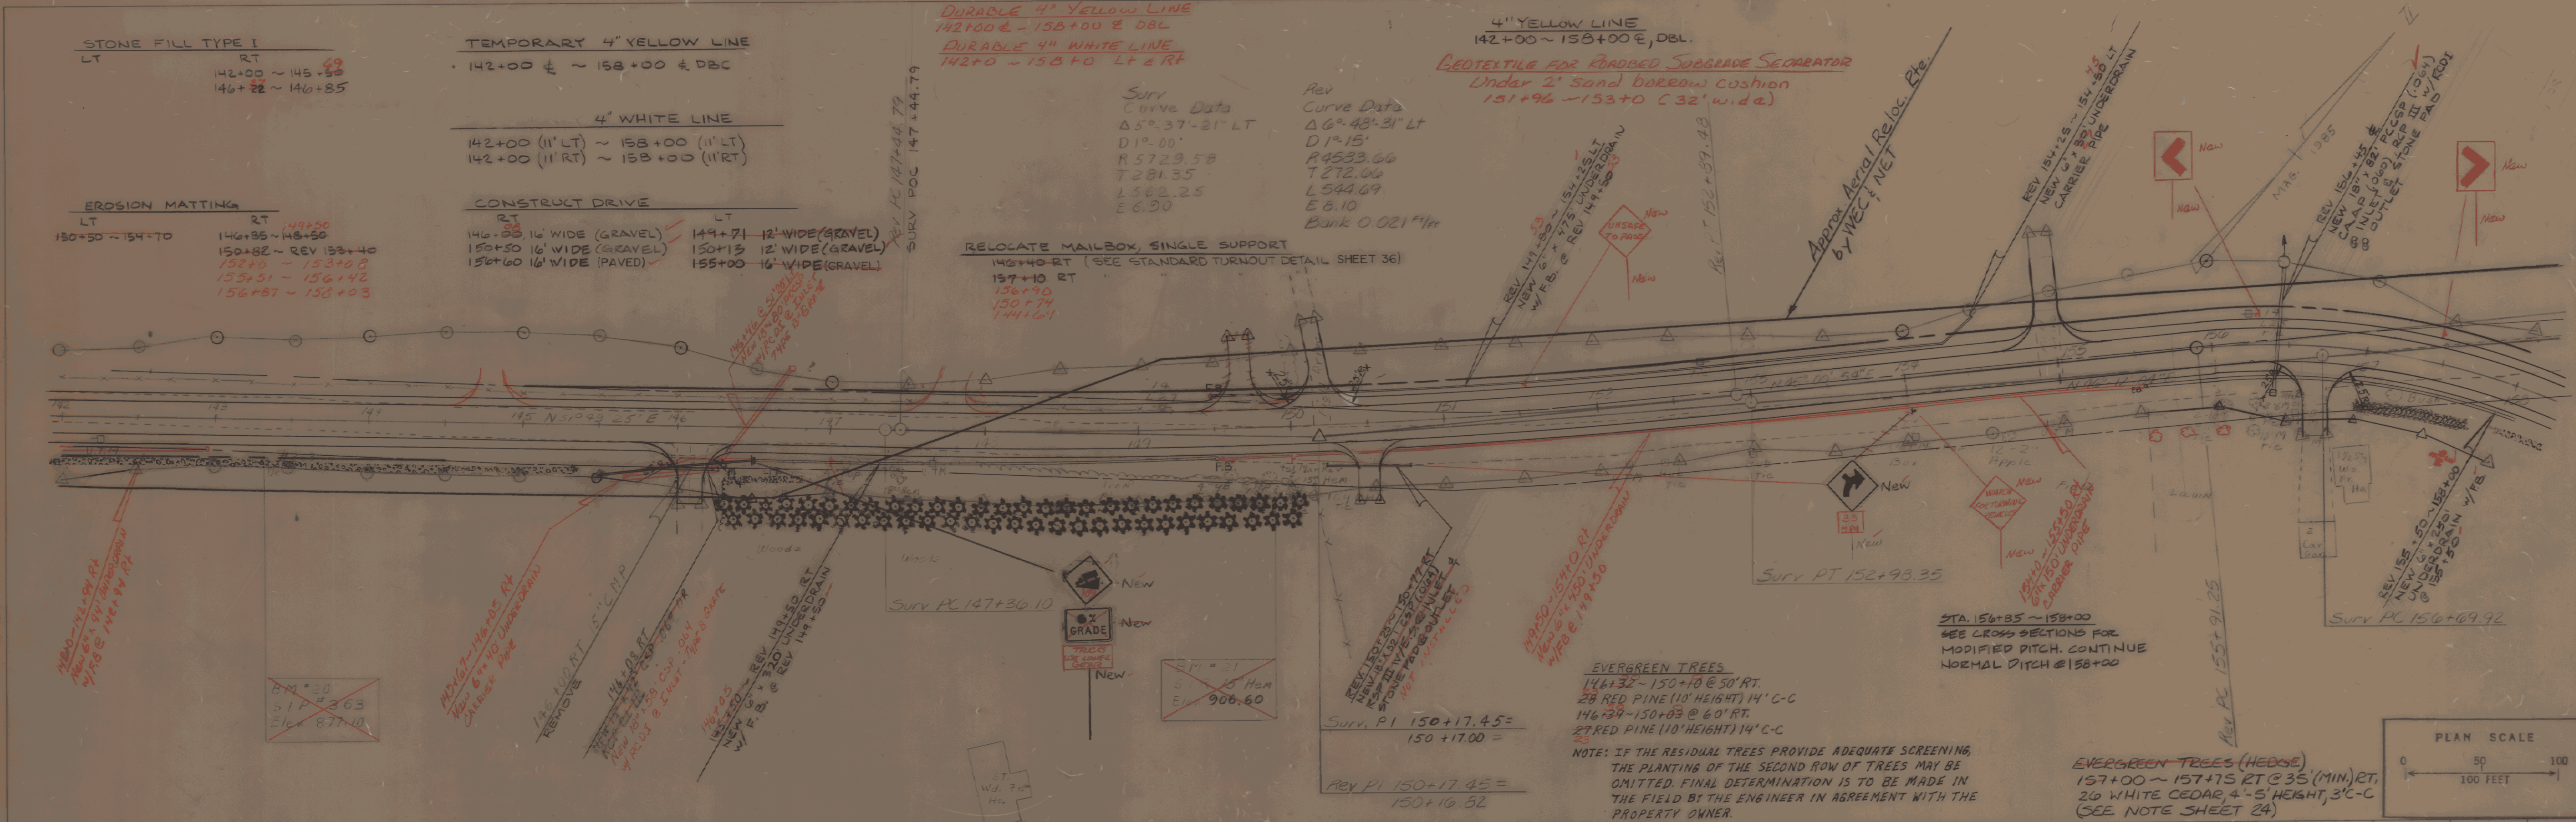

DATUM
 VERTICAL NGVD 1929
 HORIZONTAL N/A

EAST MONTPELIER
 Proj. RS No. 0246 (1)
 Sheet 26 of 128