


DATE: _____ BY: _____
 PLAN
 SUBMITTED: _____
 NOTE BOOK: _____
 ALIGNMENT CHECKED: _____
 BY: _____ DATE: _____
 No. _____

DATE: _____ BY: _____
 PROFILE
 SUBMITTED: _____
 NOTE BOOK: _____
 GRADE CHECKED: _____
 BY: _____ DATE: _____
 No. _____

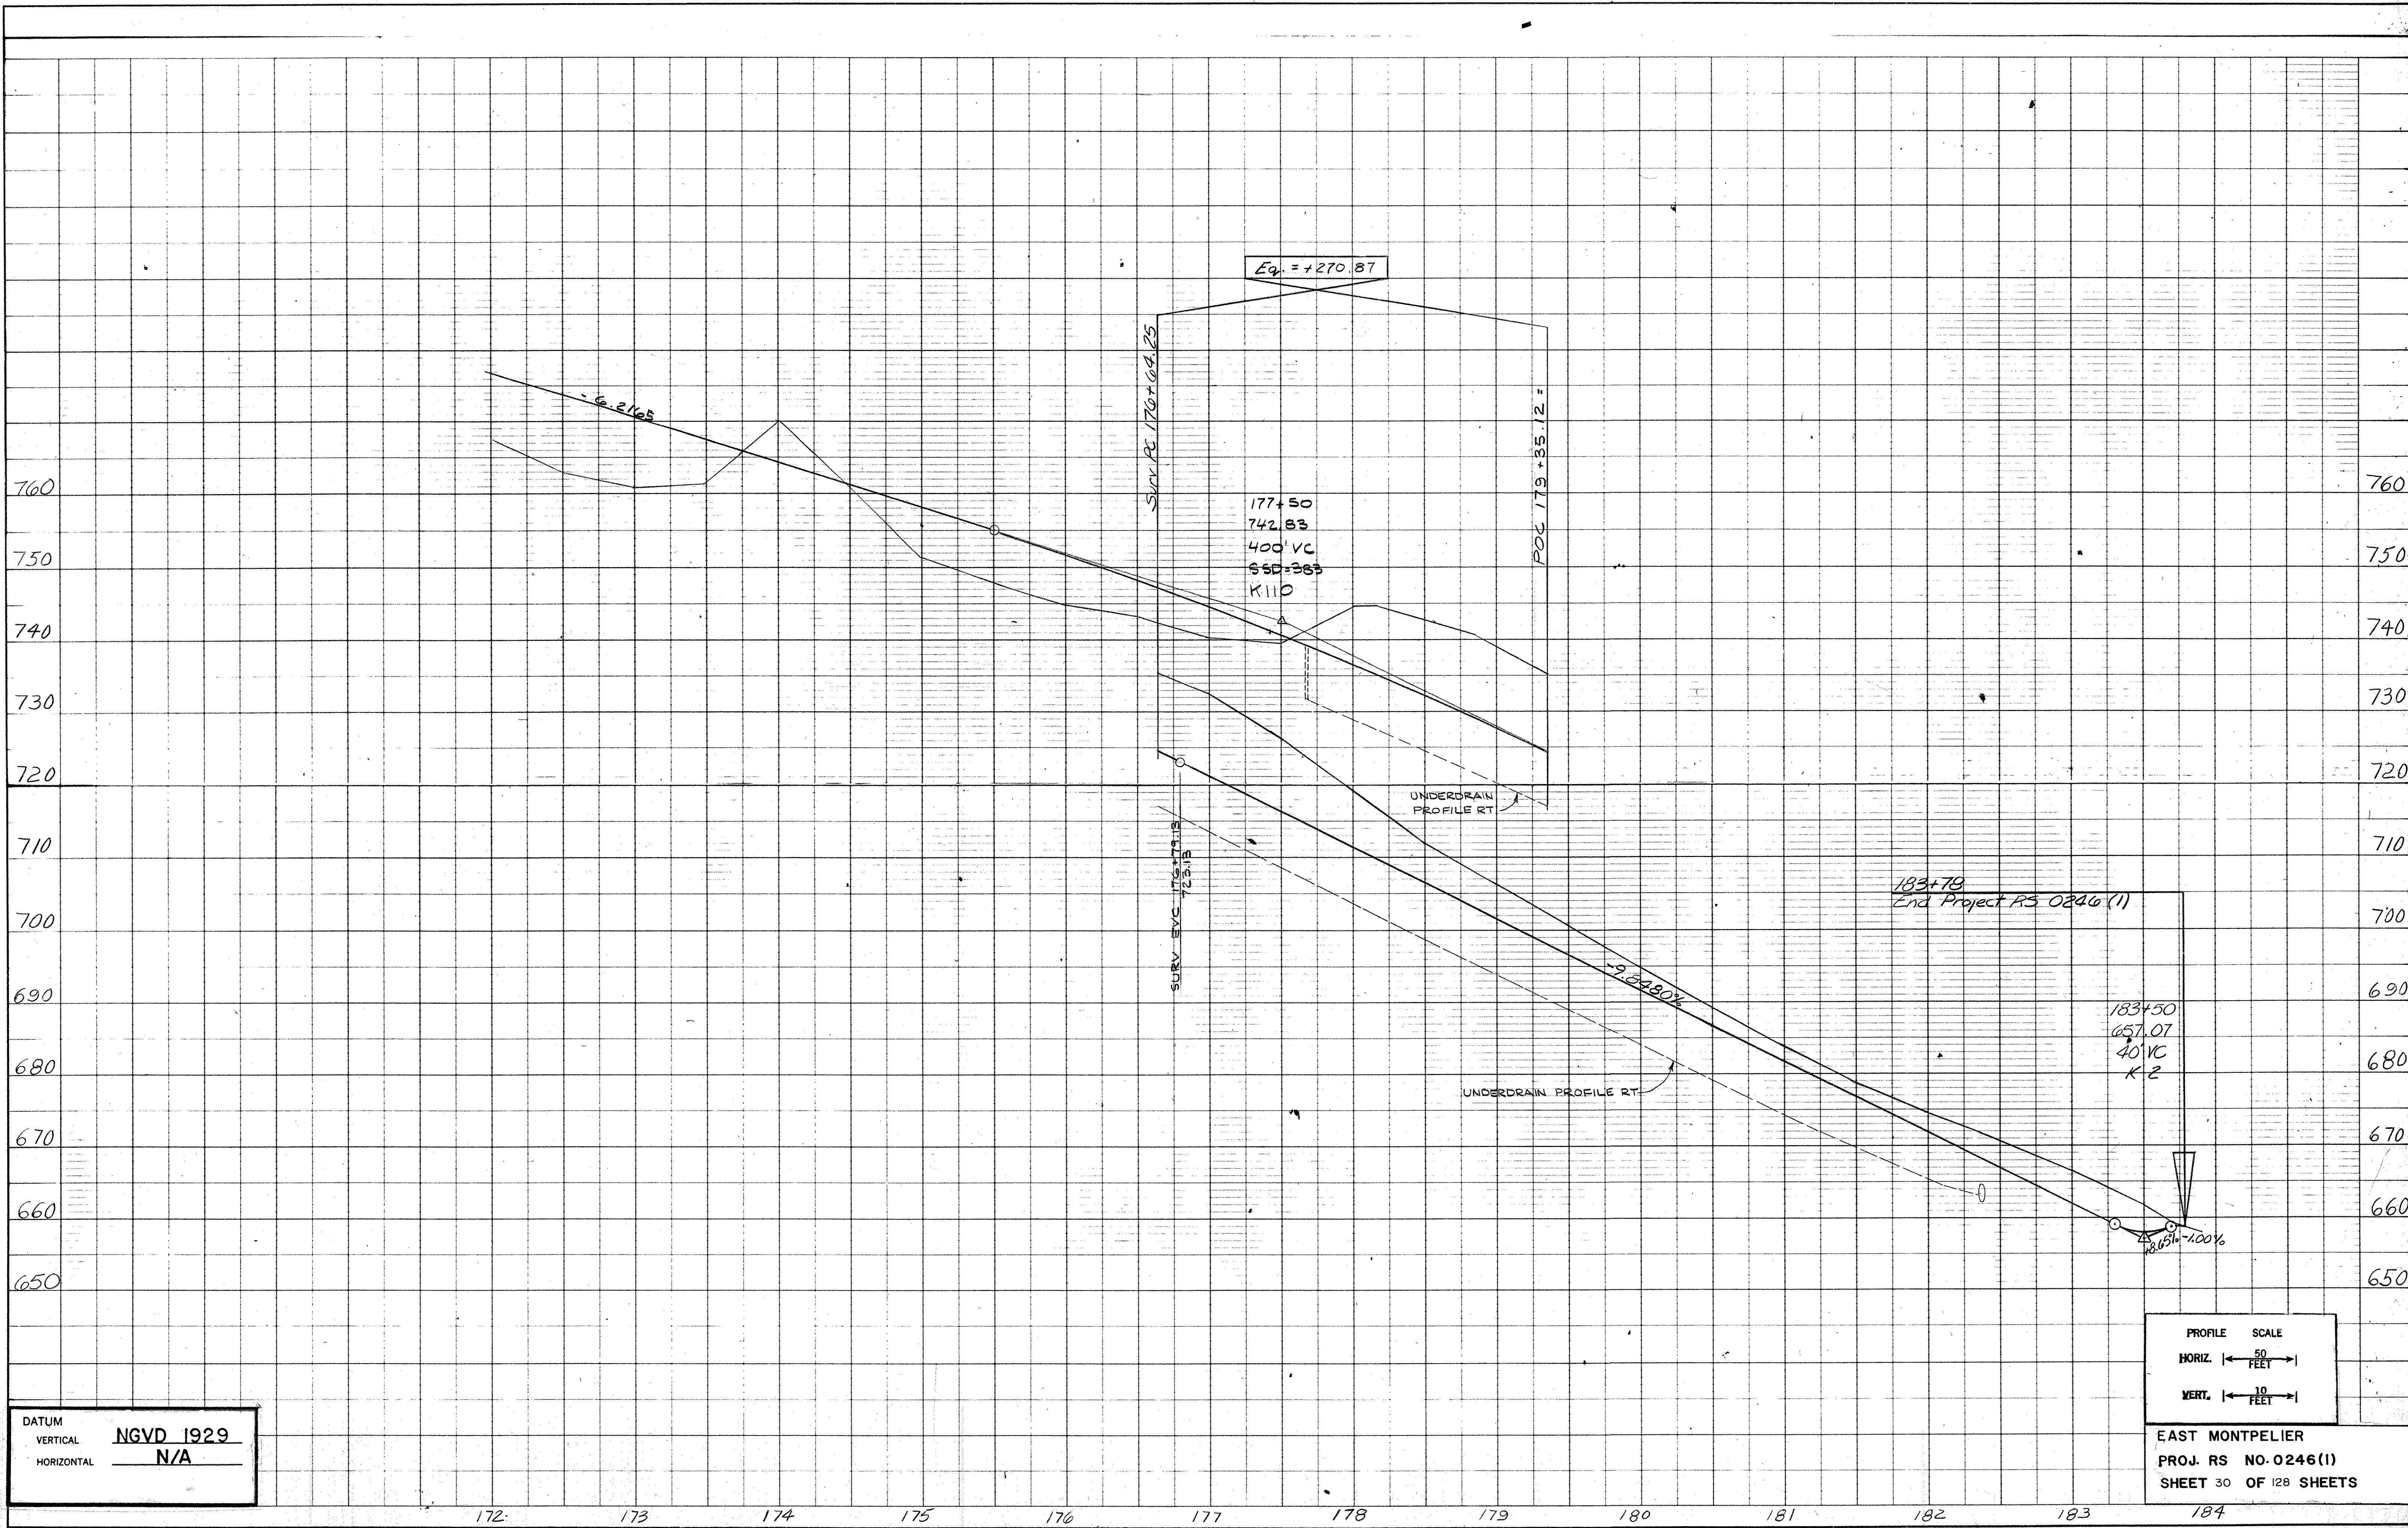

DATUM
 VERTICAL NGVD 1929
 HORIZONTAL N/A

PROFILE SCALE
 HORIZ. 50 FEET
 VERT. 10 FEET

EAST MONTPELIER
 PROJ. RS NO. 0246(1)
 SHEET 30 OF 128 SHEETS