

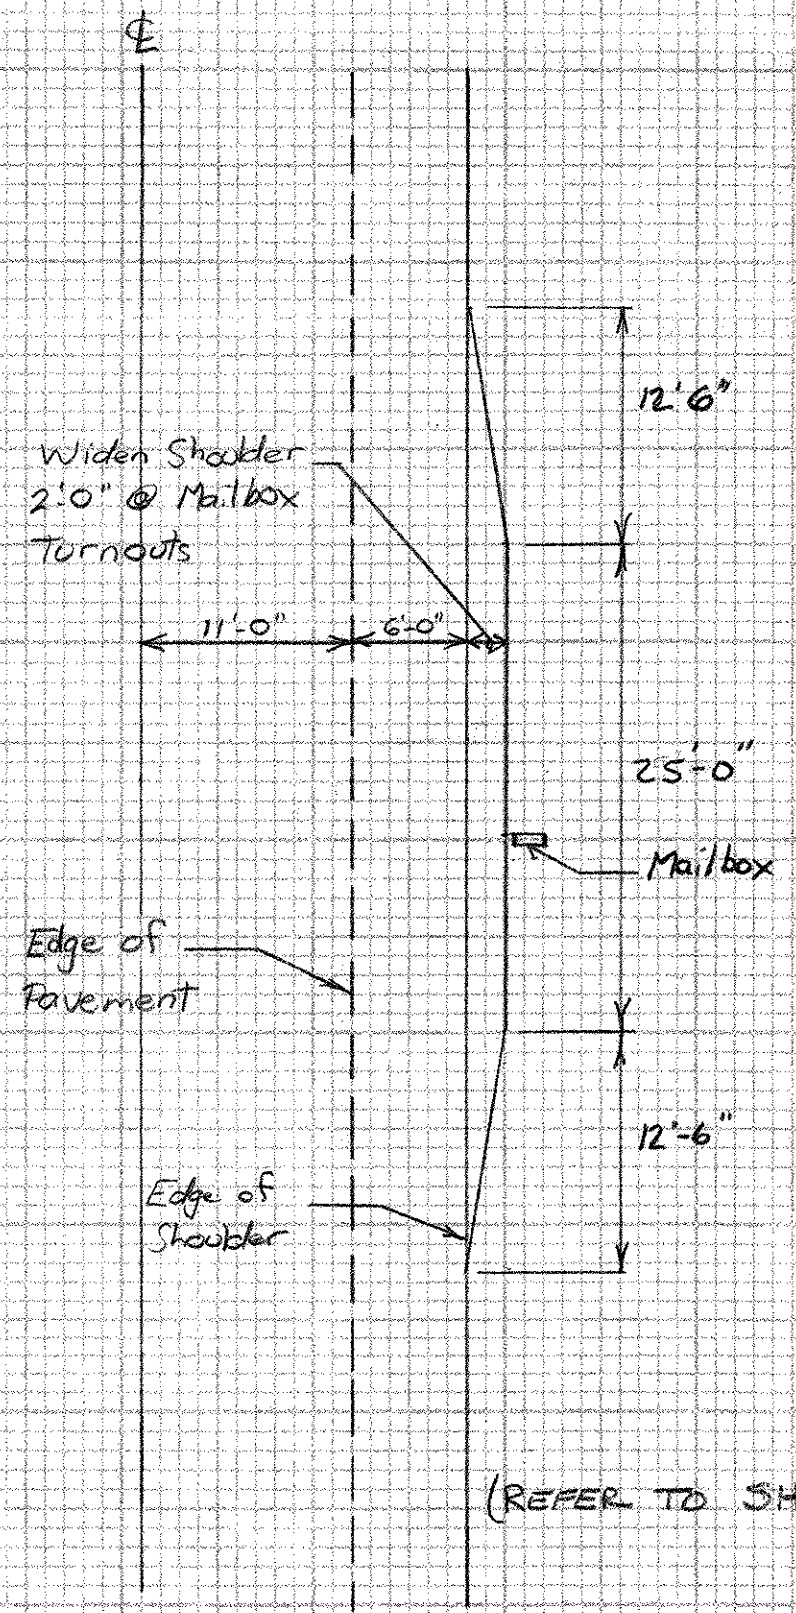


Elev. PCC 113+53.88
 D 3.024' LT
 Bank 0.038 FT/FT

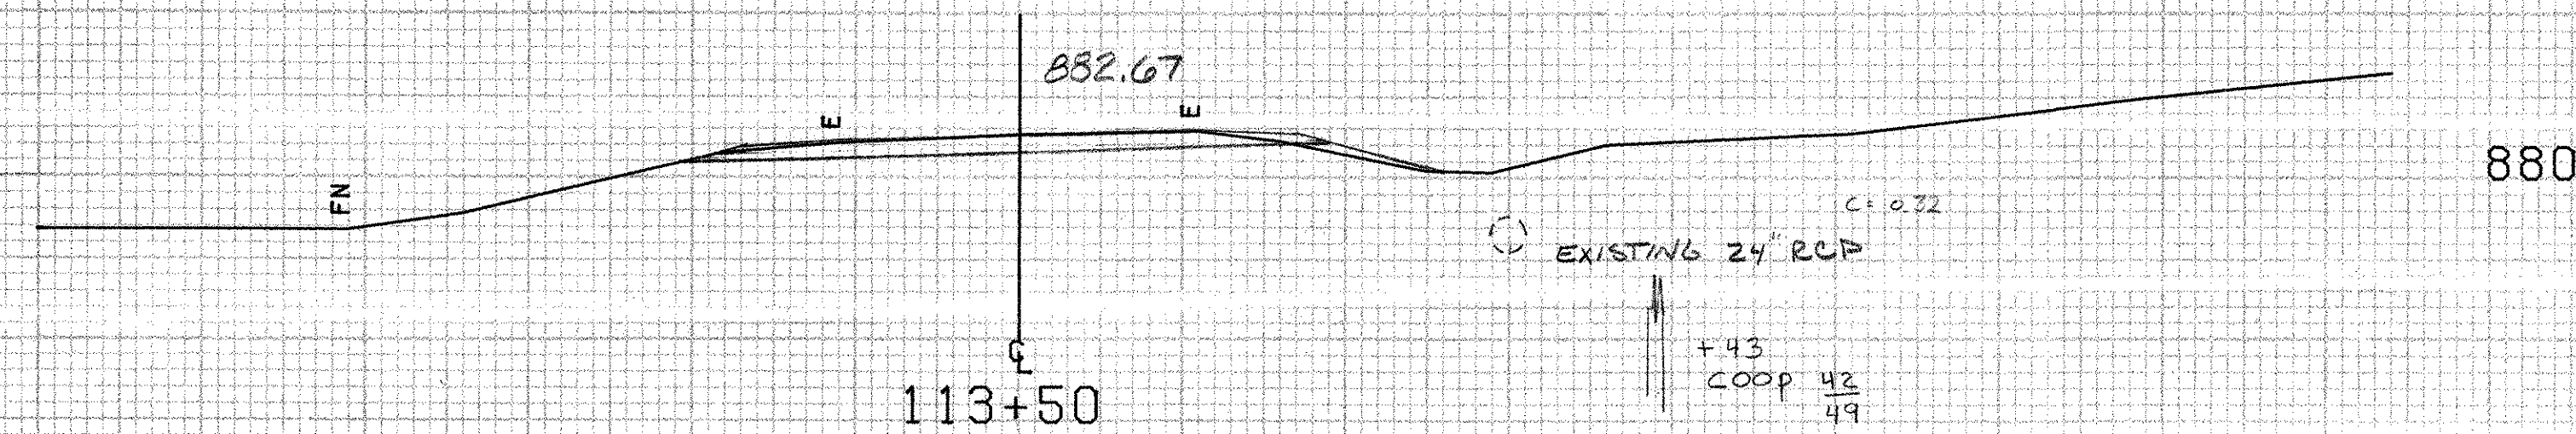


Typical Turnout @ Mailbox
 scale: 1" = 10'

- STA 113+30 LT
- STA 133+40 LT
- STA 146+40 RT
- STA 157+10 RT
- STA 179+35 RT

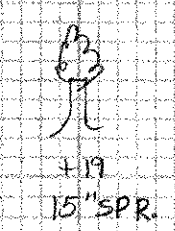


113+30 LT. Relocate Mailbox, DS

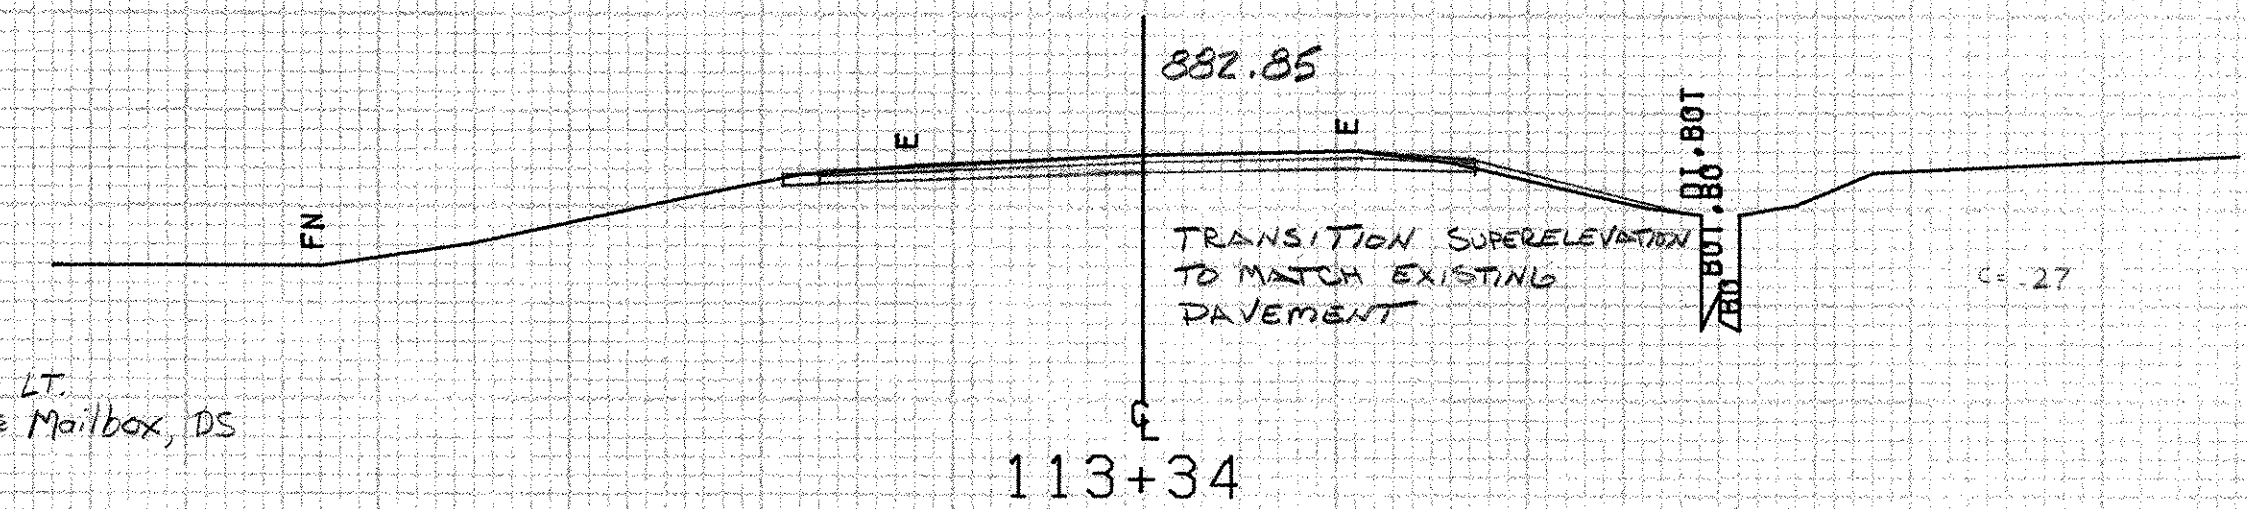


113+25 Begin Approach

MAINTAIN EXISTING DRAINAGE SYSTEM
 113+34 ~ 116+94 RT

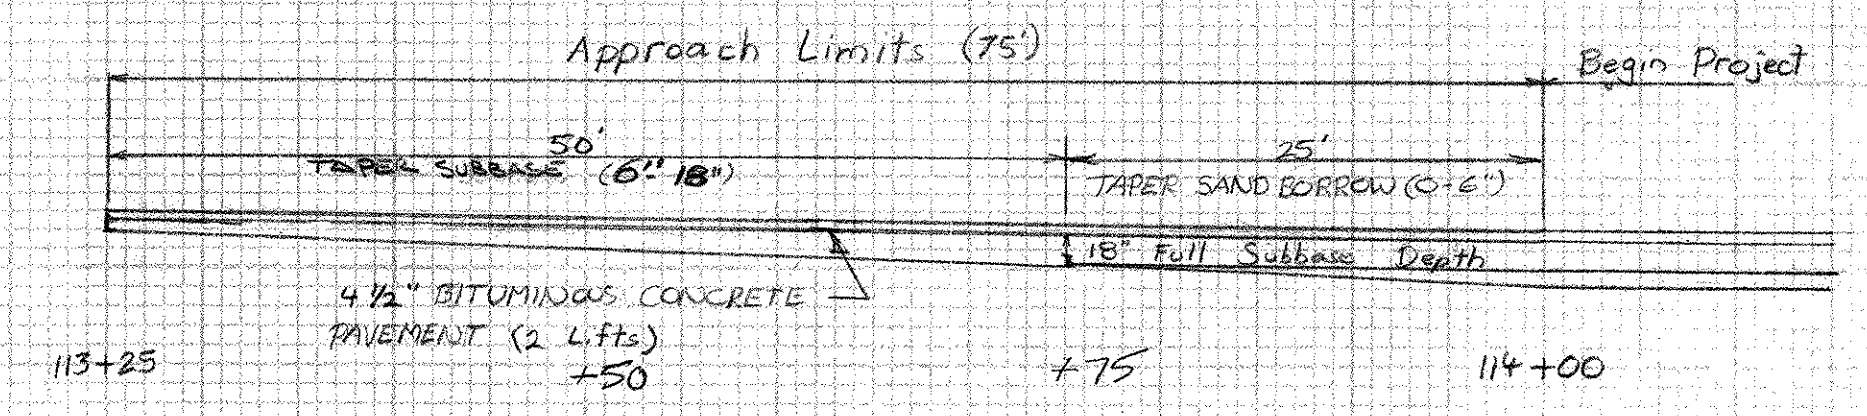

Pavement and Subbase Transition Diagram

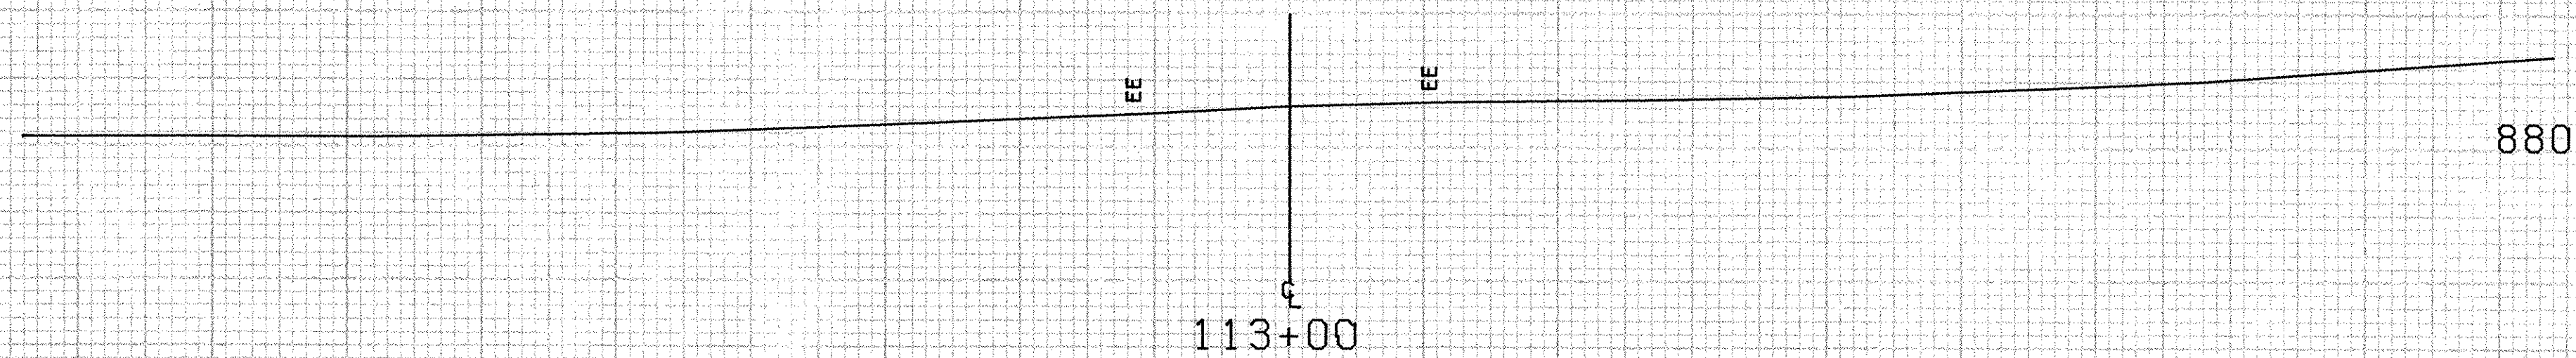

FROM STA. 113+00	TO STA. 113+50
PROJECT NAME EAST MONTPELIER MAIN	
NO. RS0246(1)	PLOTTED 02/24/83
SURVEYED BY LAYALLEE	JAN82
SHEET 36 OF 128	SHEETS

SCALE 1" = 10 FEET