



116+75
 BEGIN DRILLING & BASTING OF SOLID
 ROCK SUBGRADE

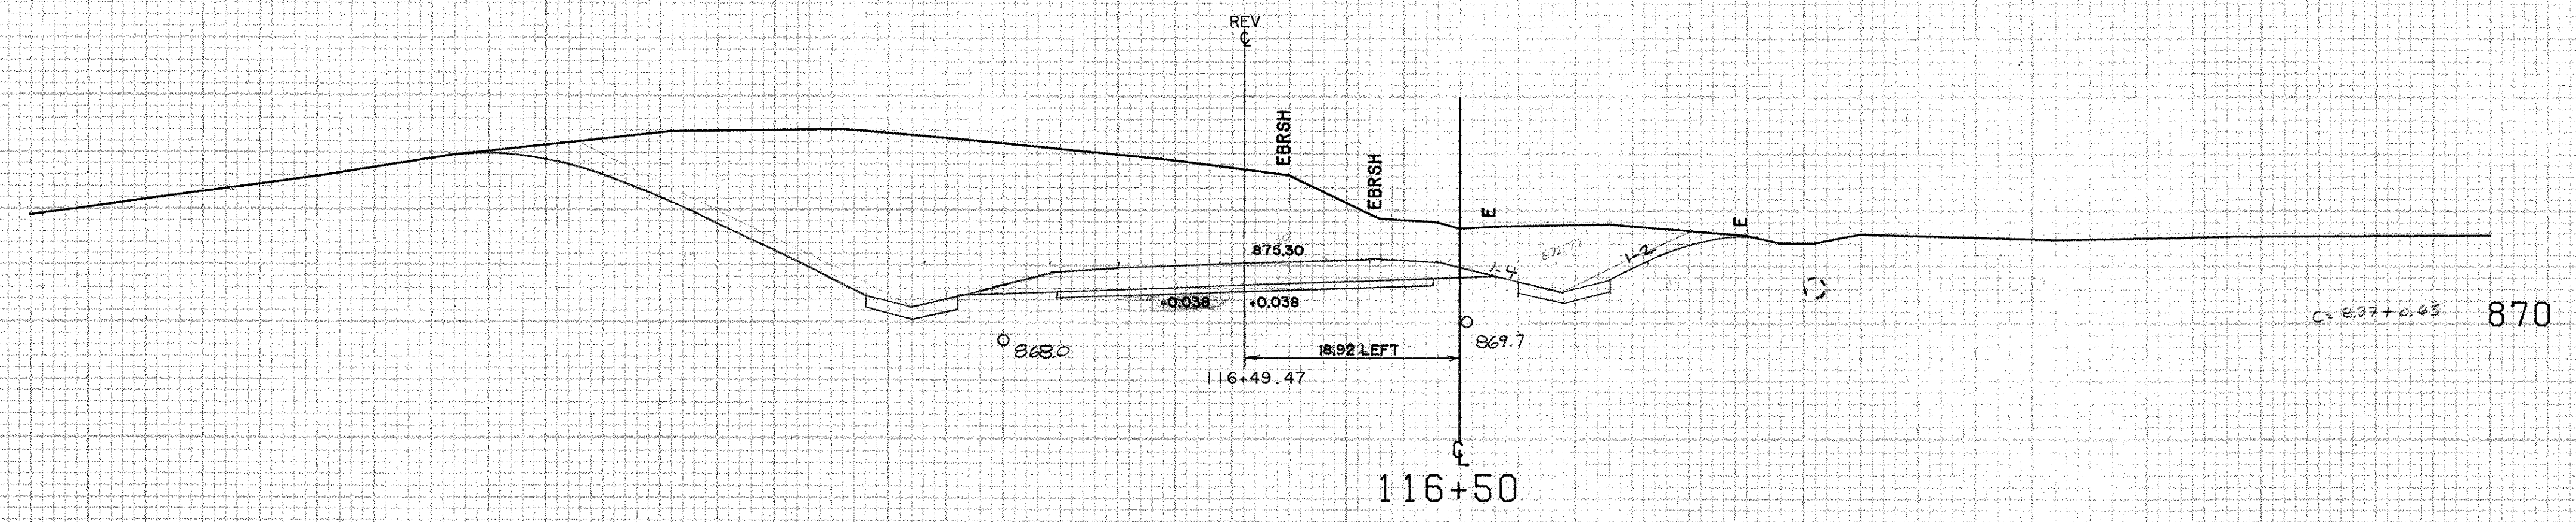



116+00~125+00±LT
 BARB WIRE FENCE
 (SEE DETAIL, SHEET 4 & SPECIAL PROVISIONS)

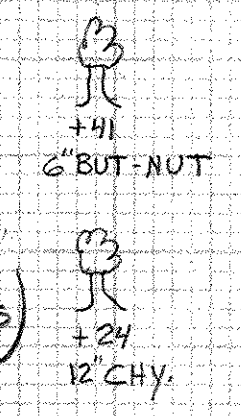

116+00~118+00 RT
 DECIDUOUS TREES
 ALTERNATE PLANTING OF SUGAR MAPLE
 AND WHITE ASH (SUGAR MAPLE, 6 ASH)
 100' BEHIND TOP OF CUT, 20' C-C


Note: If ledge is
 encountered in
 ditches where stone
 fill is specified, it
 may be omitted, subject
 to the approval of the
 Engineer.

REV 15+95 LT
 BEGIN STONE FILL
 TYPE I
 REV 116+00 LT
 Begin 6" x 25' Underdrain
 w/ Flushing Basin @ 116+00

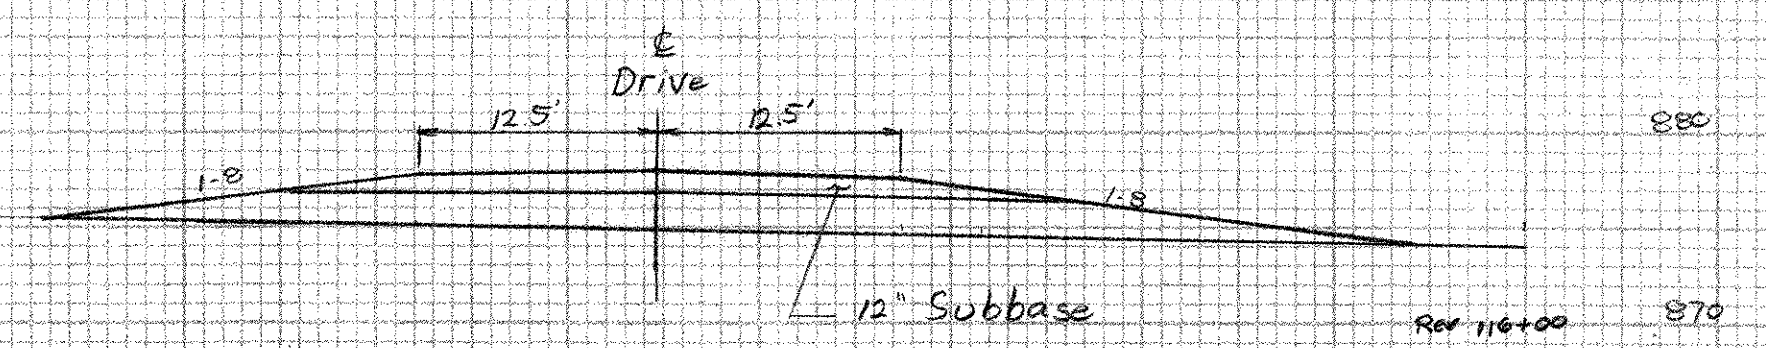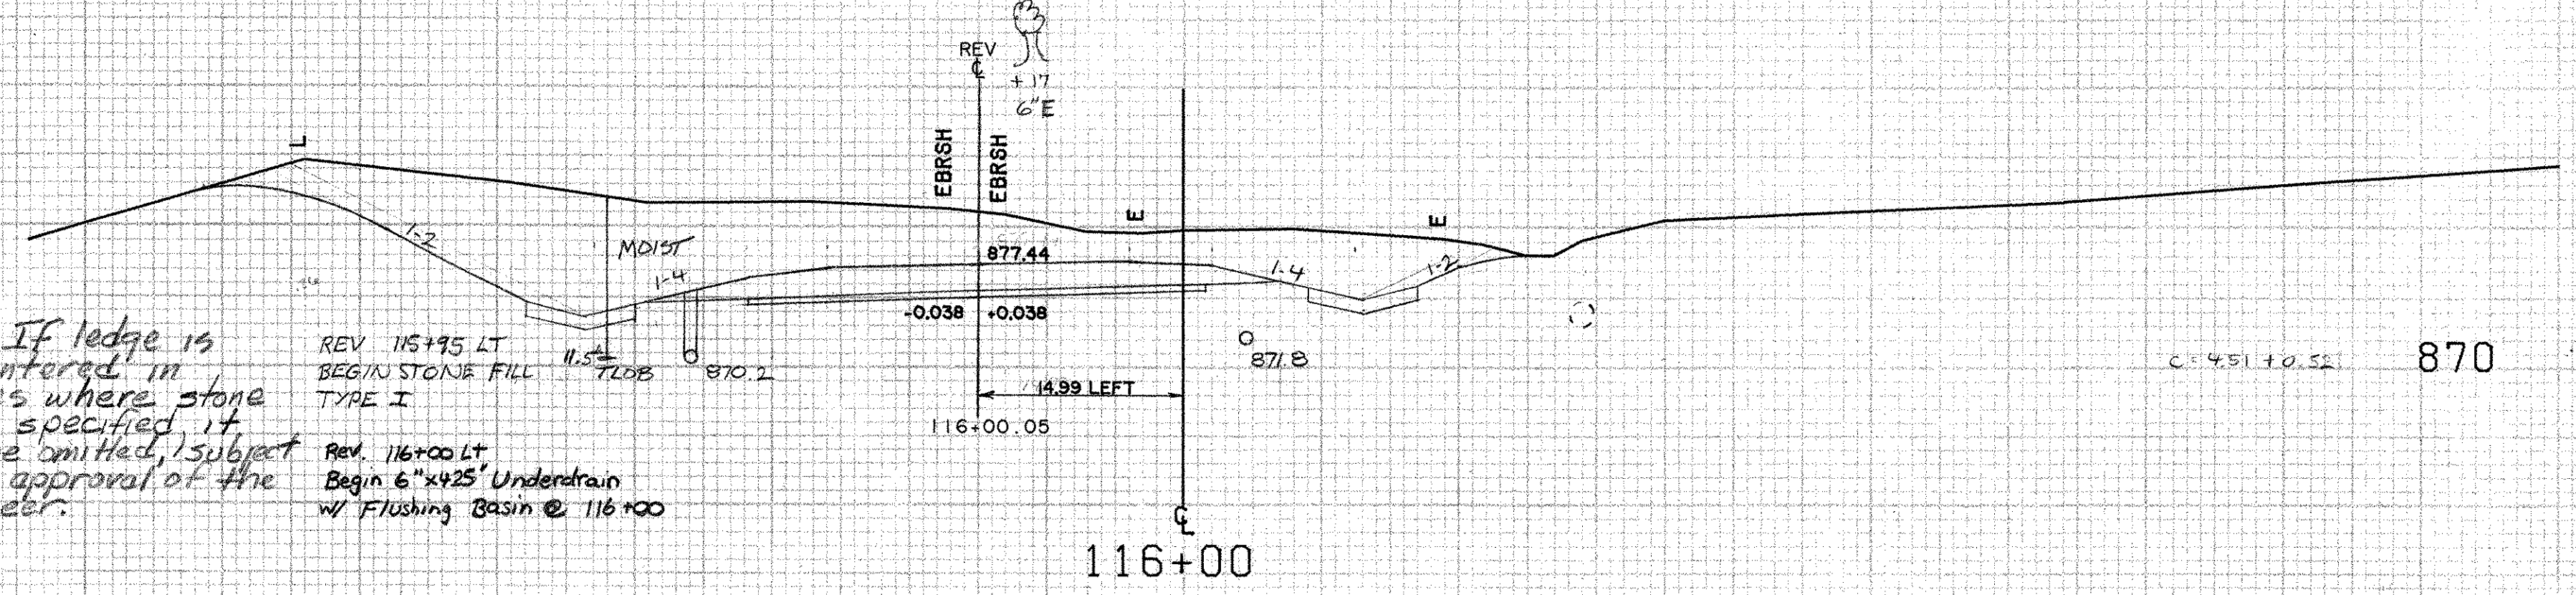

Section A-A

115+50 LT
 CONSTRUCT DRIVE

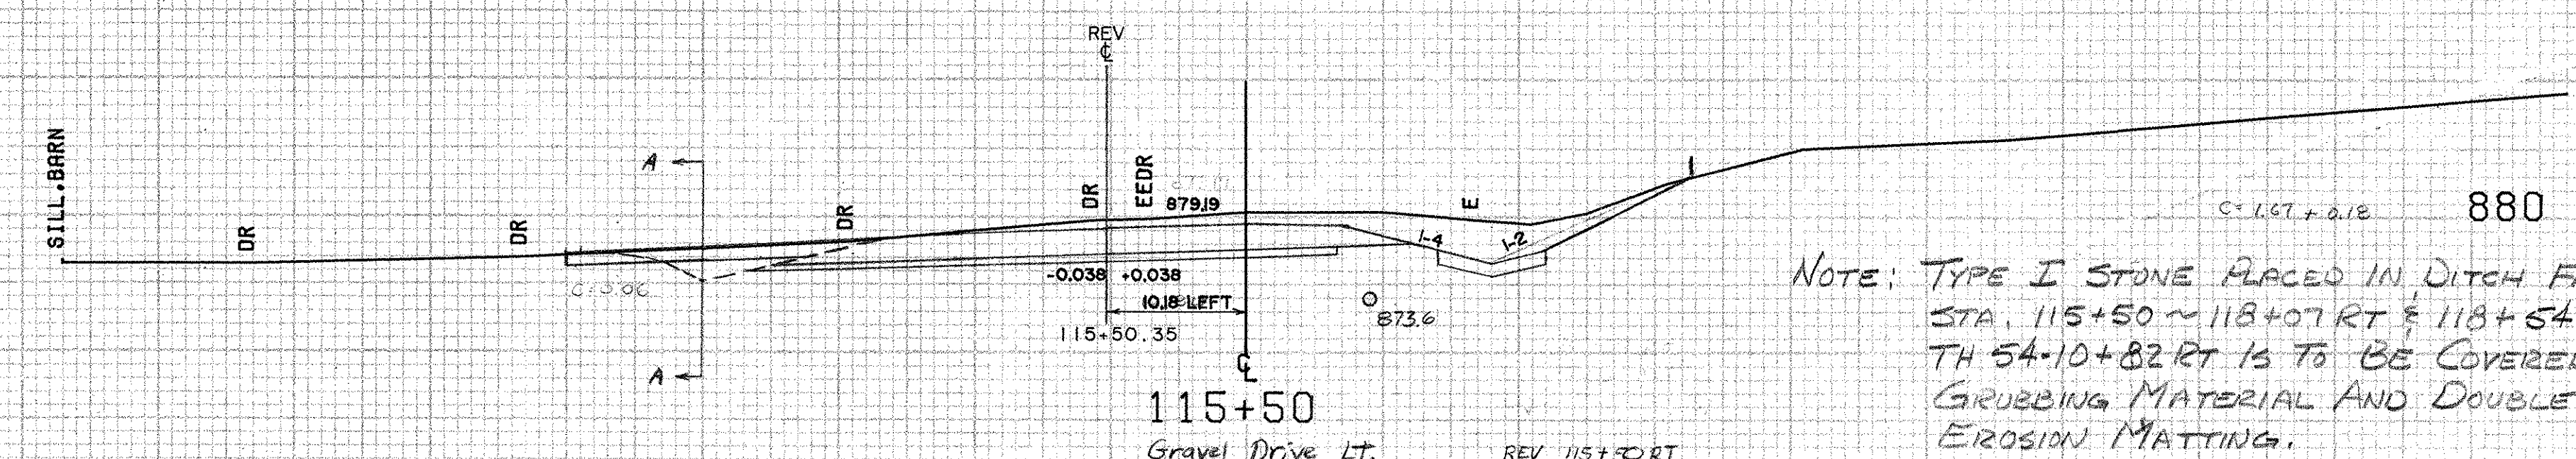

NOTE: TYPE I STONE PLACED IN DITCH FROM
 STA. 115+50~118+07 RT & 118+54~
 TH 54+10+82 RT IS TO BE COVERED W/ 6"
 GRUBBING MATERIAL AND DOUBLE WIDTH
 EROSION MATTING.

REV 115+50 RT
 BEGIN STONE FILL TYPE I
 BEGIN GRUBBING MATERIAL W/ EROSION MATTING (DOUBLE WIDTH)

FROM STA.	115+50	TO STA.	116+50
PROJECT NAME	EAST MONTPELIER MAIN		
NO.	RS0246(1)		
SURVEYED BY	LAVALLEE	PLOTTED	02/24/83
SHEET	38	OF 128	SHEETS

SCALE 1" = 10 FEET