

118+75
END DRILLING & BLASTING
OF ROCK SUBGRADE

+85
Guy post

+60
6" POP

+92 #14
L38

INTERPOLATED
LEDGE LINE

EXISTING 24" RCP

REV. 118+54 RT
BELOW STONE FILL TYPE I
BEGIN GRUBBING MATERIAL W/ DOUBLE WIDTH EROSION MATTING

12" SUBBASE OF AGGREGATE
SURFACE COURSE (TYP. FOR
GRAVEL & FIELD DRIVES)


Section A-A

INTERPOLATED
LEDGE LINE

EXISTING 24" RCP

118+22 RT
CONSTRUCT DRIVE (SEE SPECIAL PROVISIONS)

118+04 ~ 118+54 RT
NEW 24" x 20" RCPSP (CG4),
CAAP (C060) OR RCP III W/
RCDI @ INLET & STONE
FILL @ OUTLET

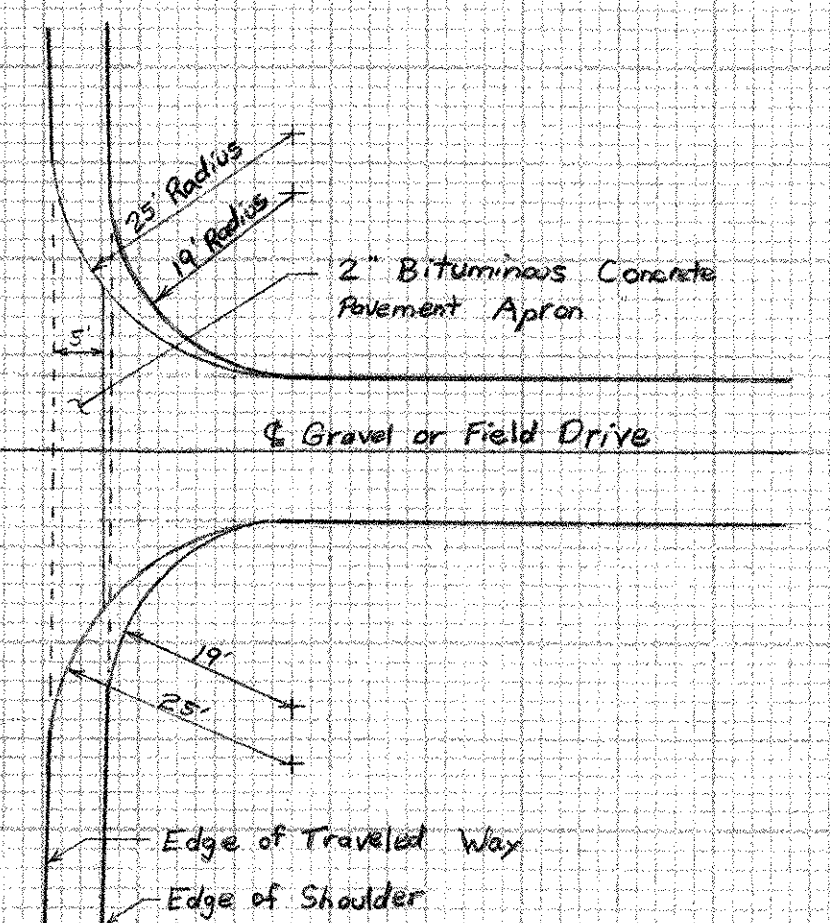

Typical Driveway Plan
Scale: 1" = 20'

+12
4" CHY

E TREES

E TREES

FROM STA. 118+00	TO STA. 118+50
PROJECT NAME EAST MONTPELIER MAIN	
NO. RS0246(1)	PLOTTED 02/24/83
SURVEYED BY LAVALLÉE	JAN82
SHEET 40 OF 128	SHEETS

SCALE 10 FEET