

U 3.0241 LT
Bank 0.038 FT/FT

V-91-70

822.56

-0.037 +0.037

L-4 L-4

ERO ERO

DITCH DITCH

810




806.0

F. 9.8

123+00

0.53' LT.
22.91.07

1" = 36'

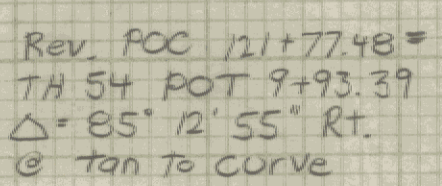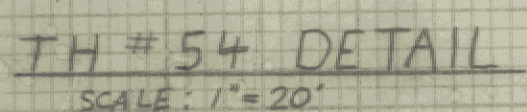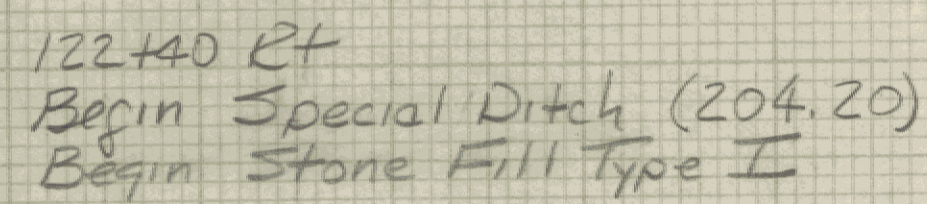

FROM STA.	122+00	TO STA.	123+00
PROJECT NAME	EAST MONTEPELIER		MAIN
NO.	RS0246(1)	PLOTTED 02/24/83	
SURVEYED BY	LAYALLEE	JAN82	
SHEET 43	OF 128	SHEETS	