
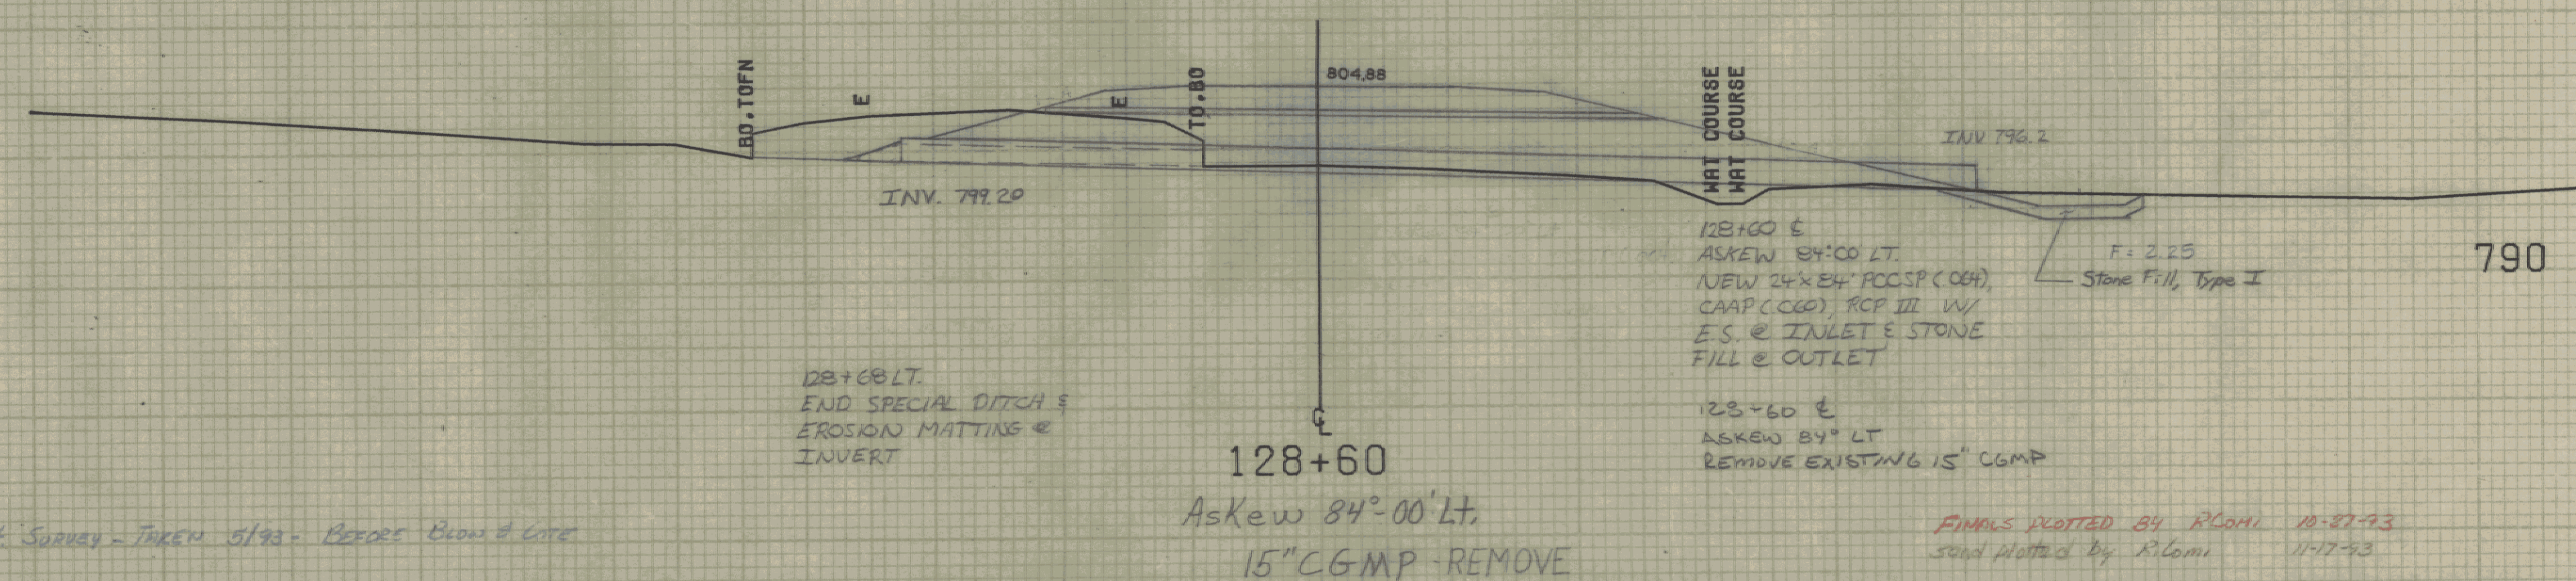
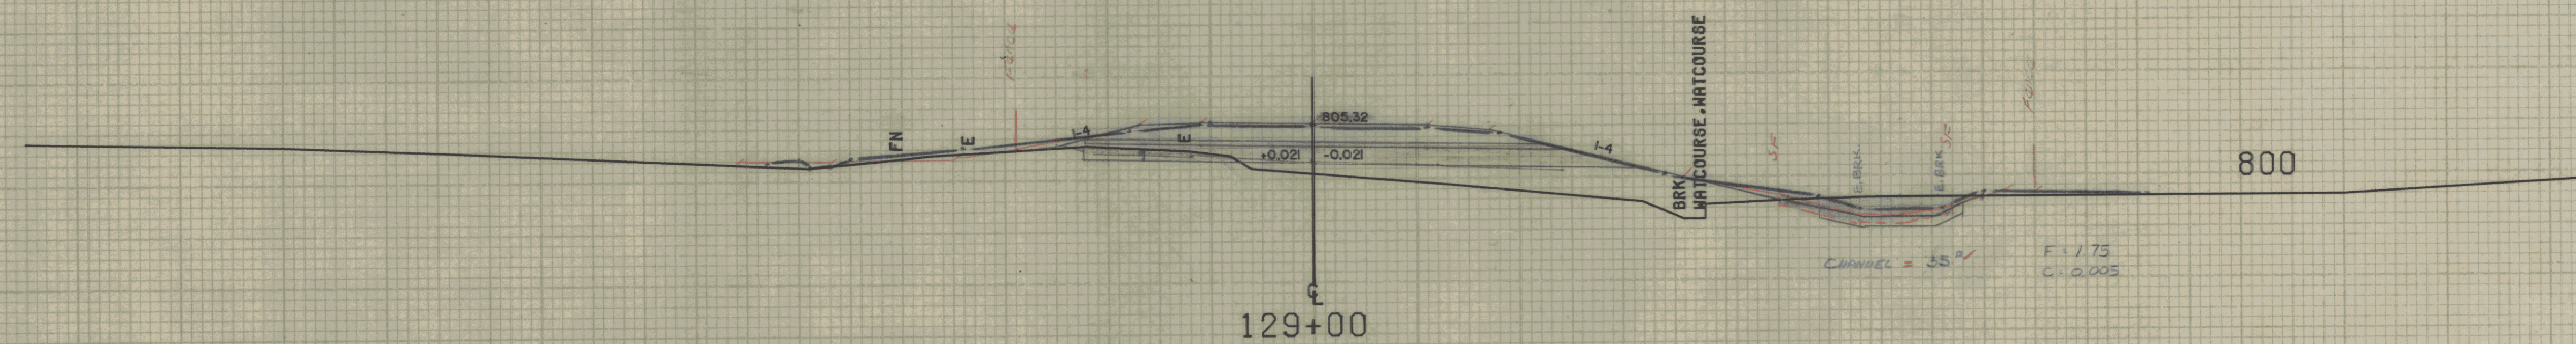


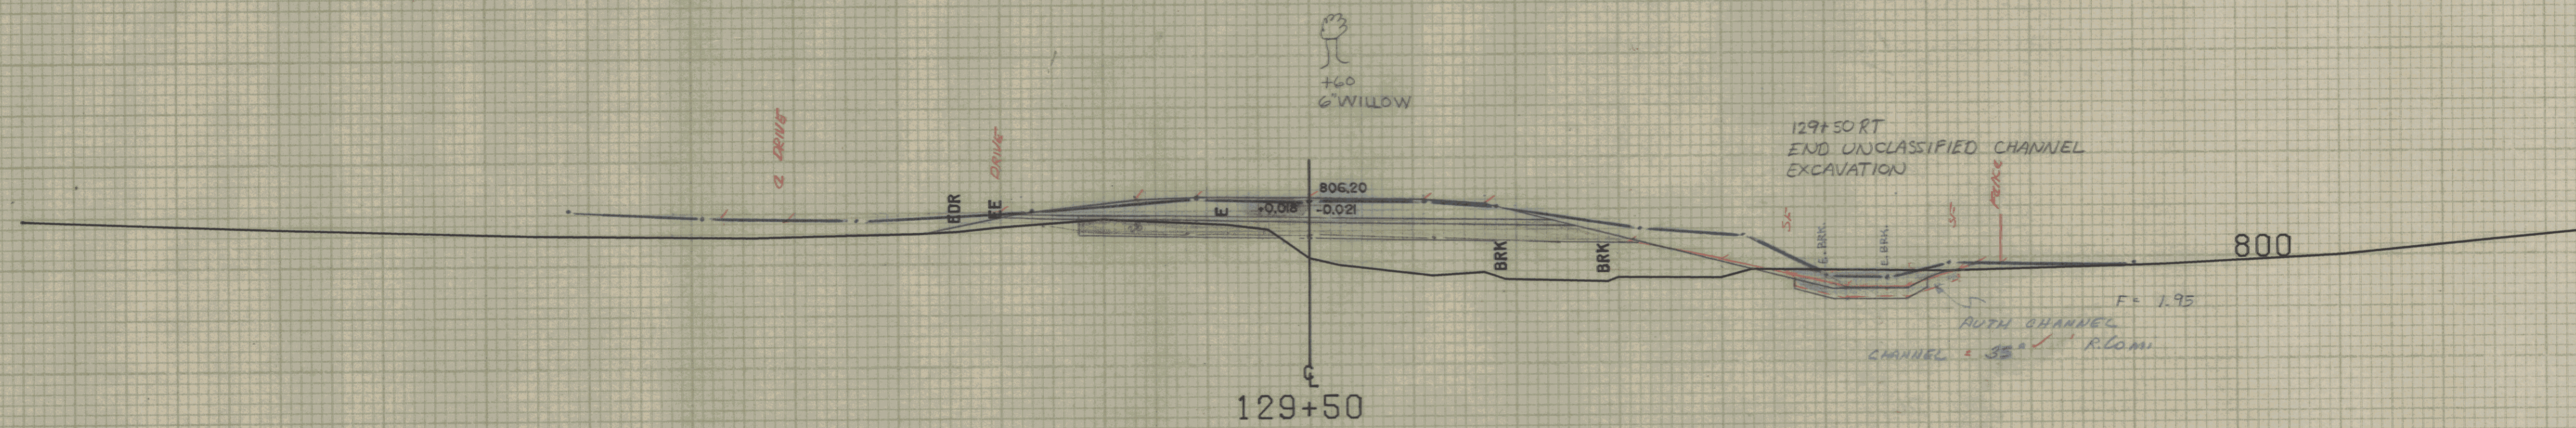

BLUE PLOT BY VT SURVEY - TAKEN 5/93 - BEFORE BLOW & LITE

FINALS PLOTTED BY R. LOM 10-27-93
Send plotted by R. Lom 11-17-93

OLD PLOT BY C. L. LOM

1-31-94

SCALE 10 FEET

FROM STA.	128+60	TO STA.	129+50
PROJECT NAME	EAST MONTPELIER MAIN		
NO.	R50246(1)		
SURVEYED BY	LAVALLEE		
SHEET	48	OF	128 SHEETS
			JAN82
			PLOTTED 02/24/83