
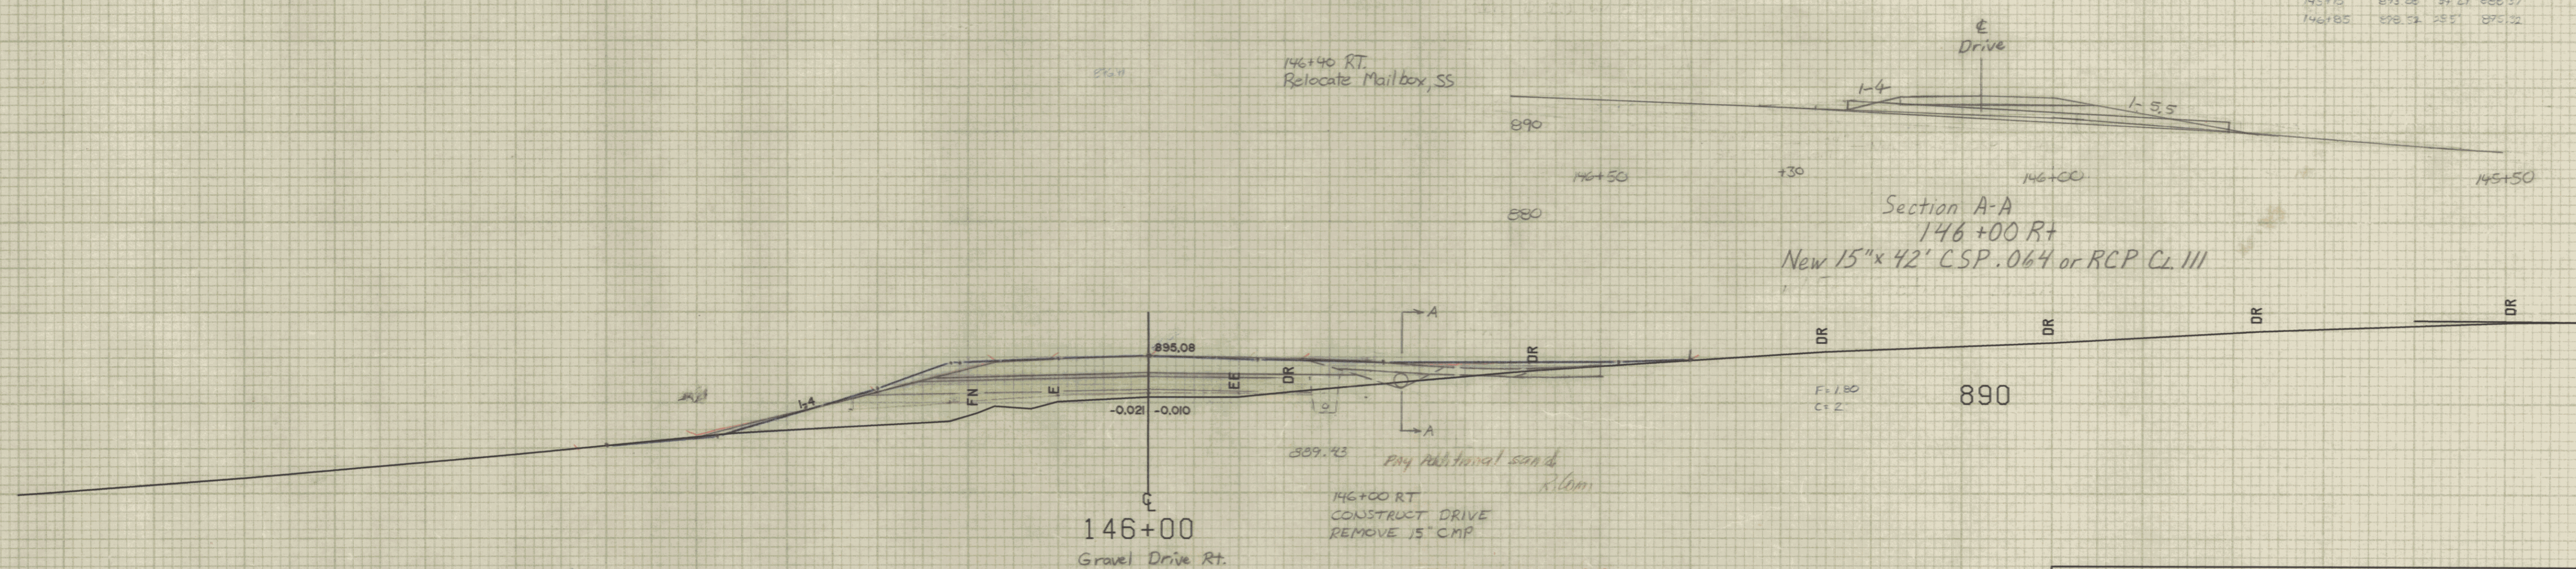
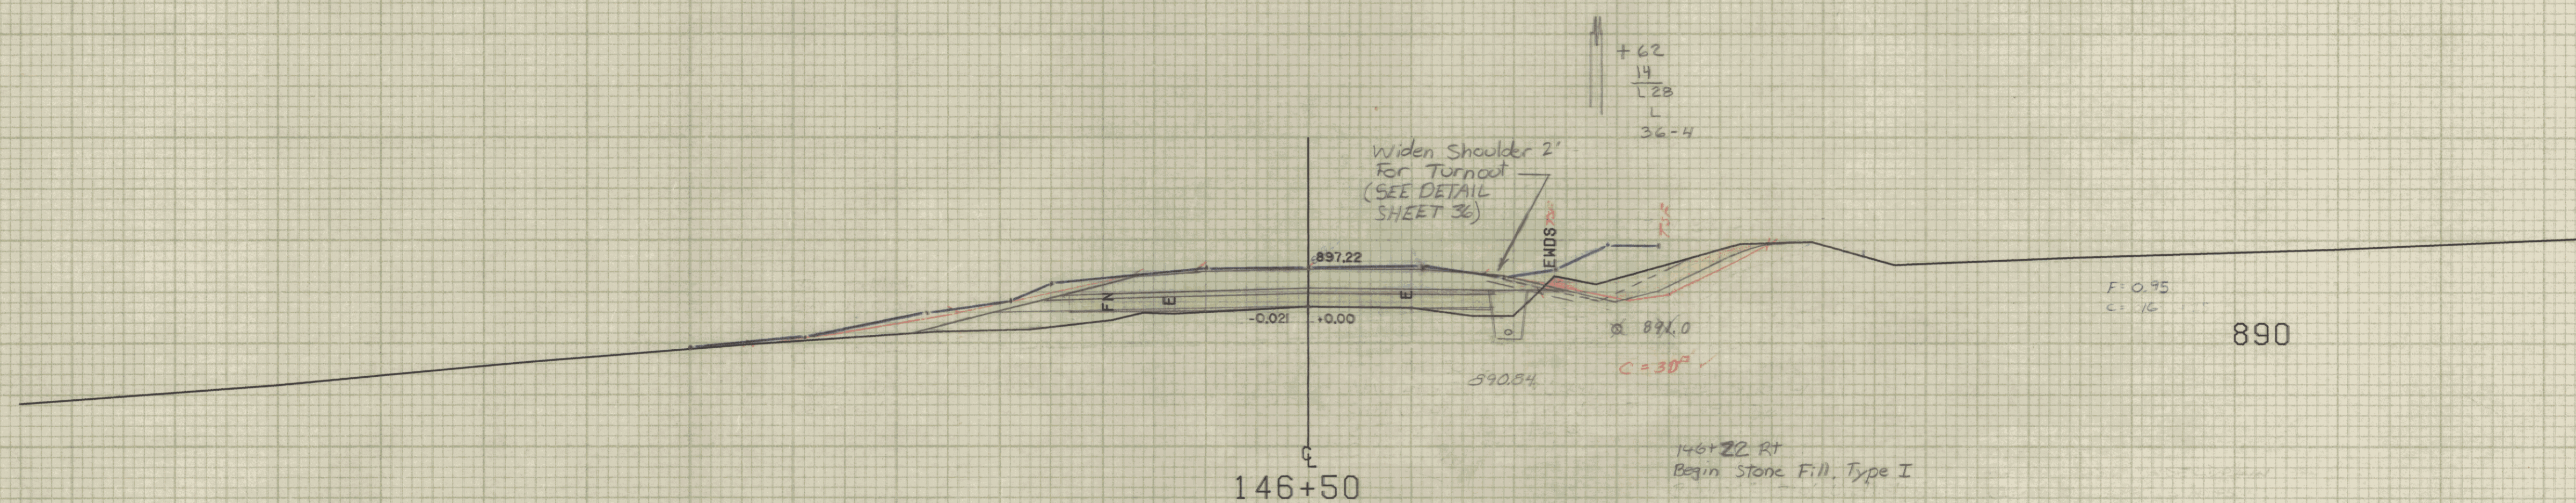


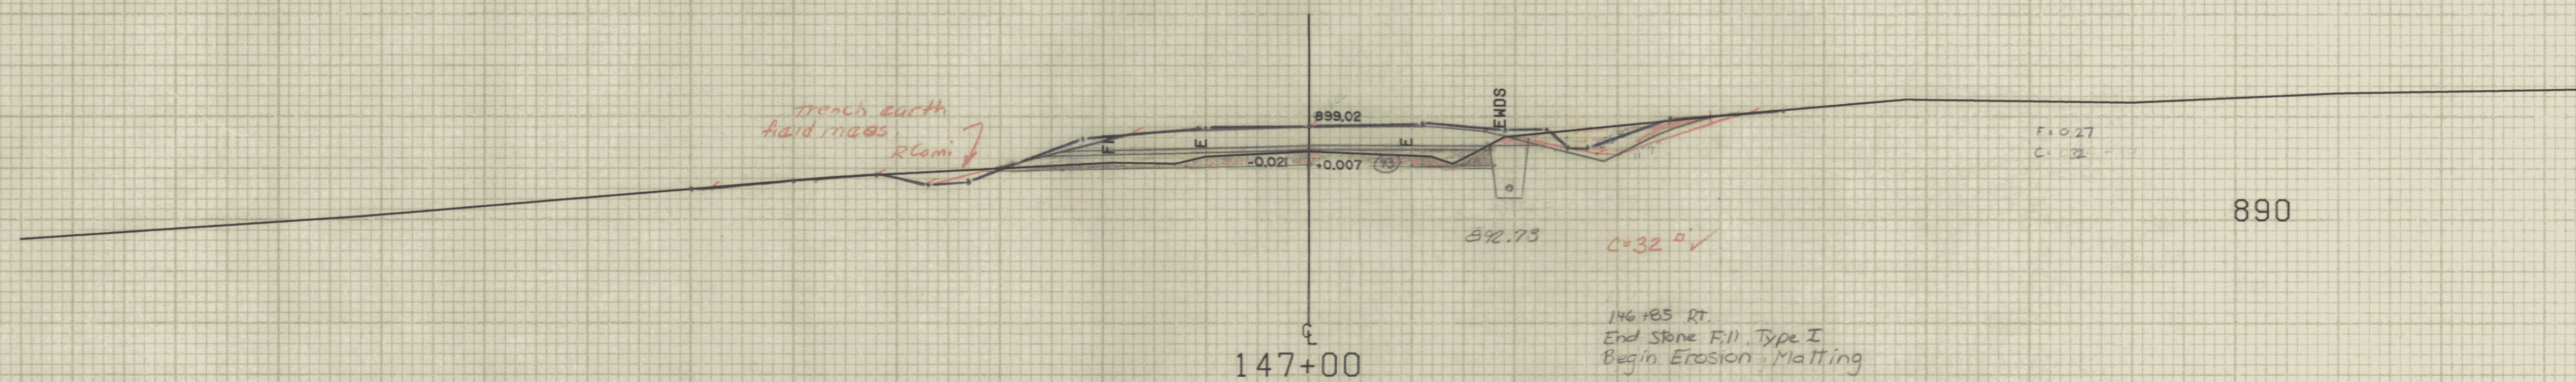

Blue Print by VT Survey - Sectional Map 1993 - Before Bridge Gate

FILES PLOTTED BY R. G. 11-5-93
SAID B. 11-19-93
ADAM 11-21-93
C.D. PLAN BY C.E. LOHR 1-21-94

SCALE 10 FEET

FROM STA. 146+00	TO STA. 147+00
PROJECT NAME EAST MONTPELIER MAIN	
NO. RS0246(1)	PLOTTED 02/24/83
SURVEYED BY LAVALLEE	JAN82
SHEET 63 OF 128 SHEETS	