



810
800

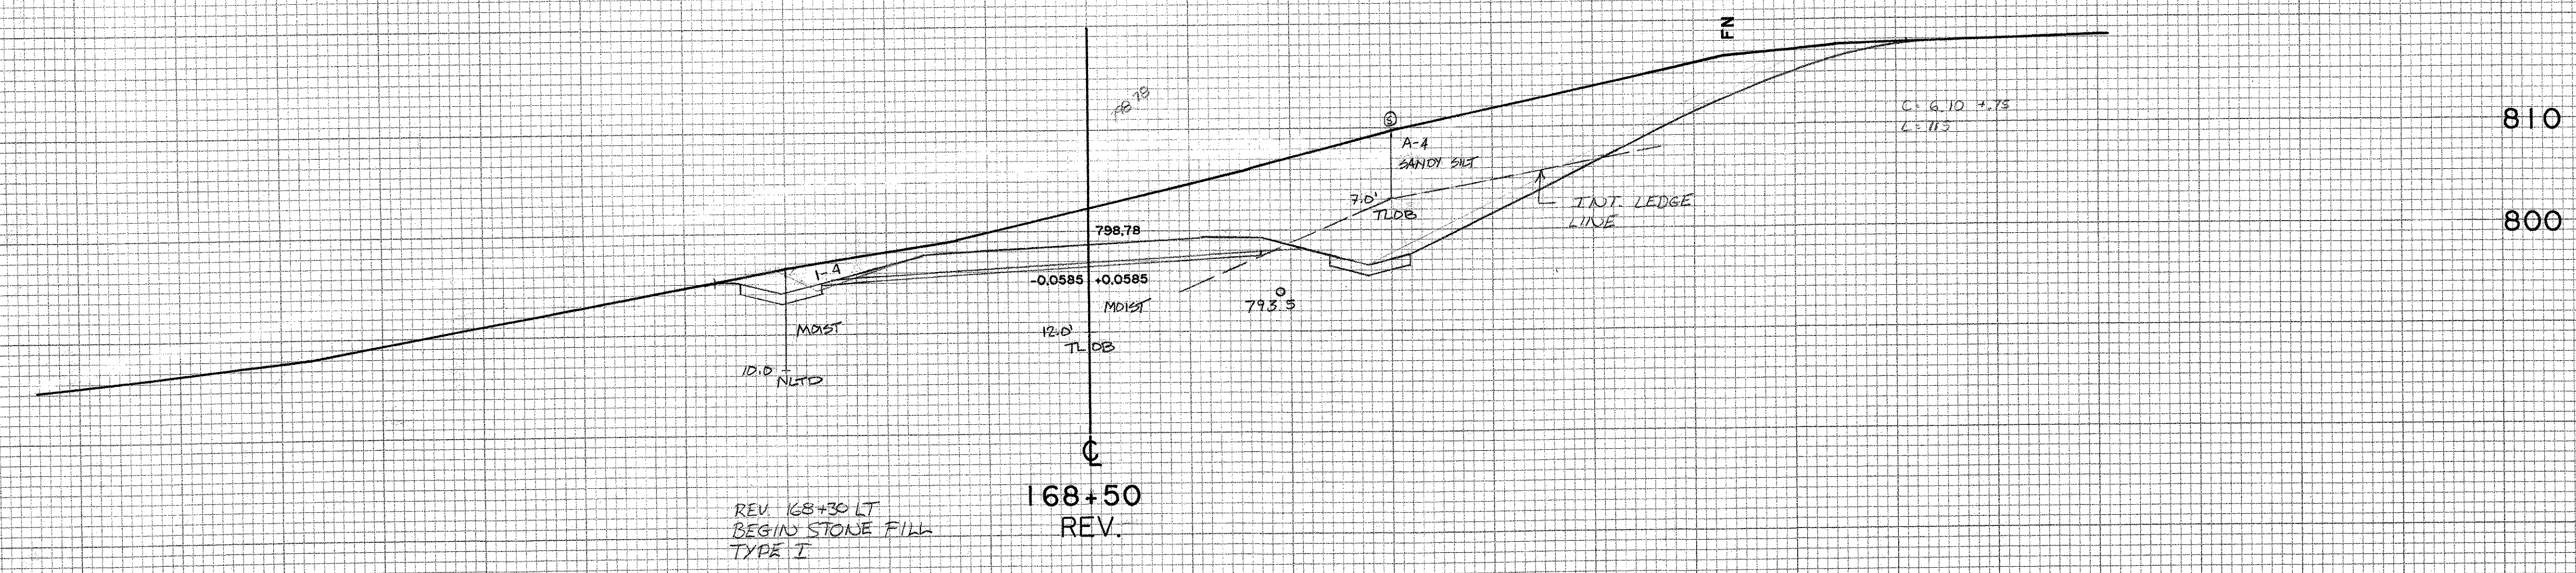

810
800

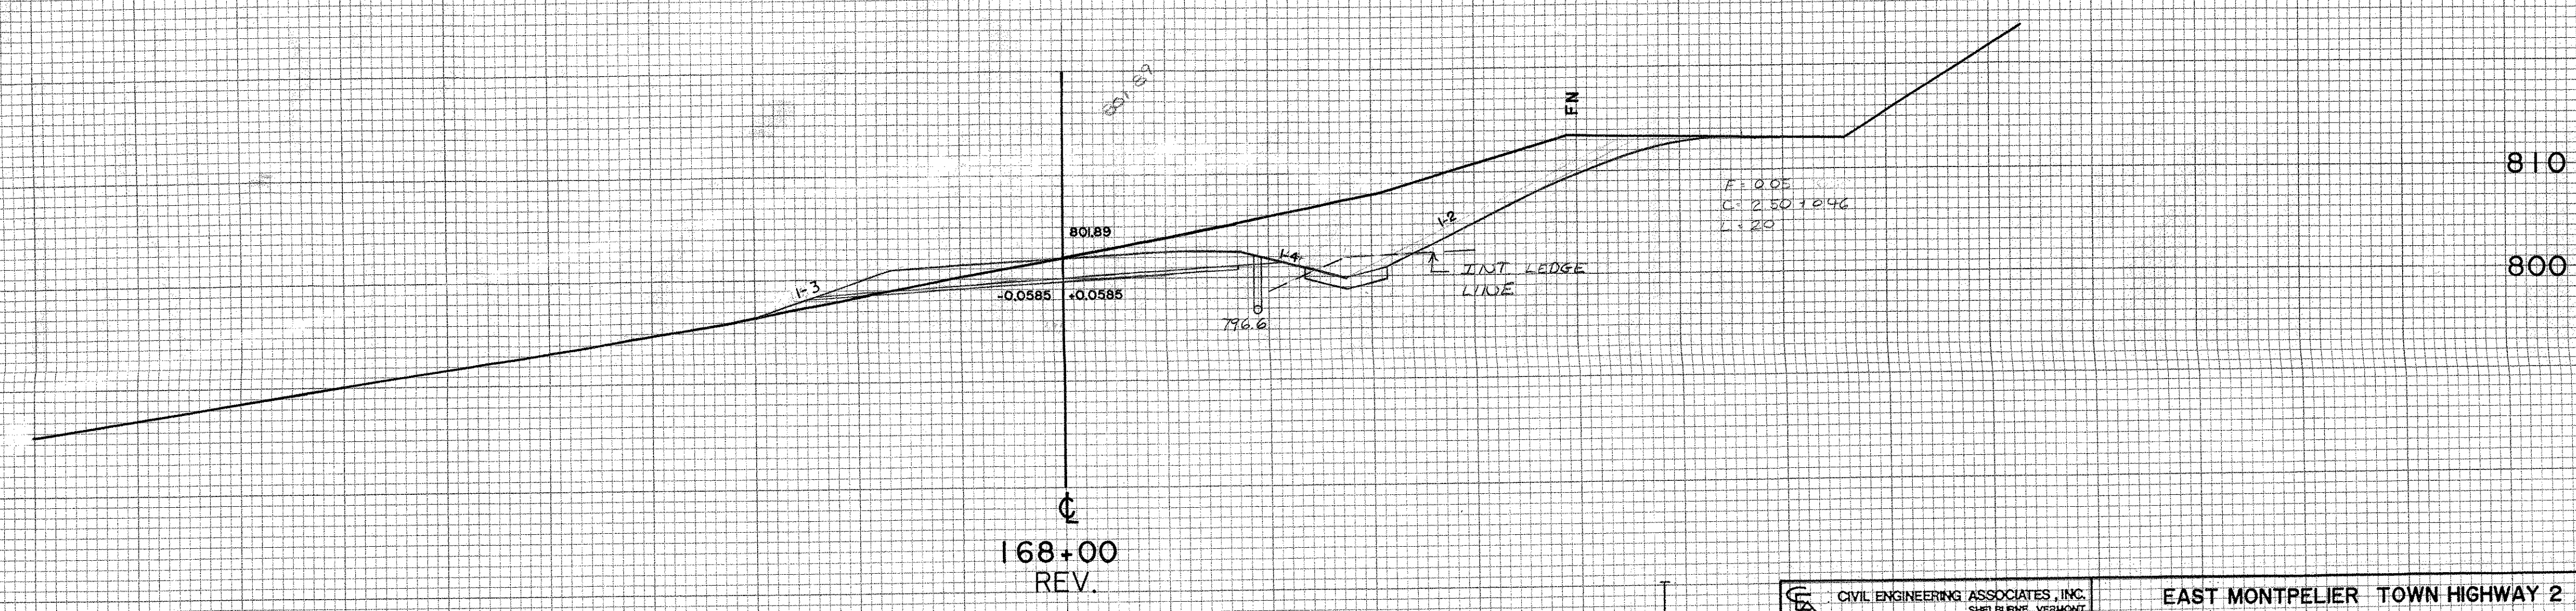

810
800

1" = 10' SCALE 10' X 10" TO THE INCH KEUFFEL & ESSER CO. PRINTED IN U.S.A.	CIVIL ENGINEERING ASSOCIATES, INC. SHELBURNE, VERMONT	EAST MONTPELIER TOWN HIGHWAY 2 ROAD CROSS-SECTIONS STA. 168+00 TO STA. 169+00 VERMONT	SHEET 77 of 128
	Drawn by Date Project No.	JAN 1988 RSO248(0) (87230)	EAST MONTPELIER