


169+60
END DRILLING & BLASTING OF
ROCK SUBGRADE

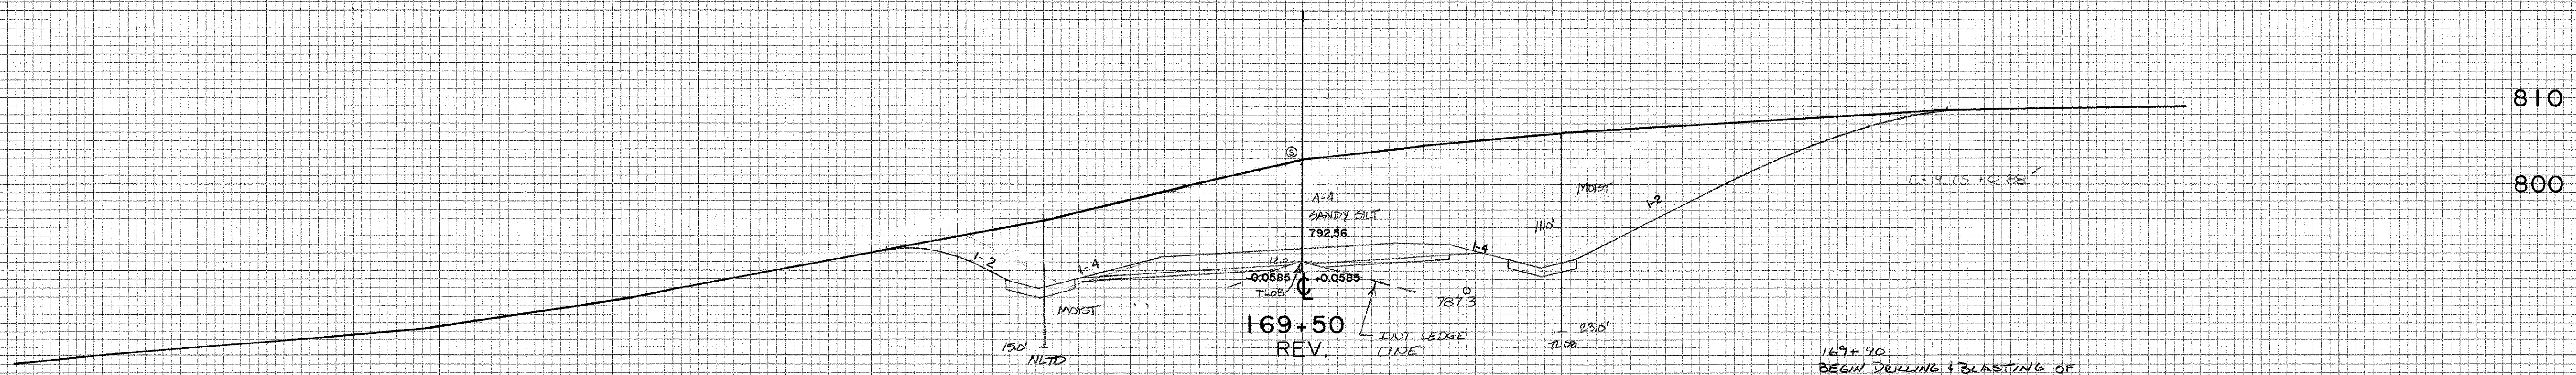

169+40
BEGIN DRILLING & BLASTING OF
ROCK SUBGRADE

1" = 10' SCALE	CIVIL ENGINEERING ASSOCIATES, INC. SHELBURNE, VERMONT	EAST MONTPELIER TOWN HIGHWAY 2 ROAD CROSS-SECTIONS STA. 169+50 TO STA. 170+50 EAST MONTPELIER VERMONT	SHEET 78 of 128
	Drawn by: _____ Date: JAN 1988 Project No. RB0246(1) (87230)		