
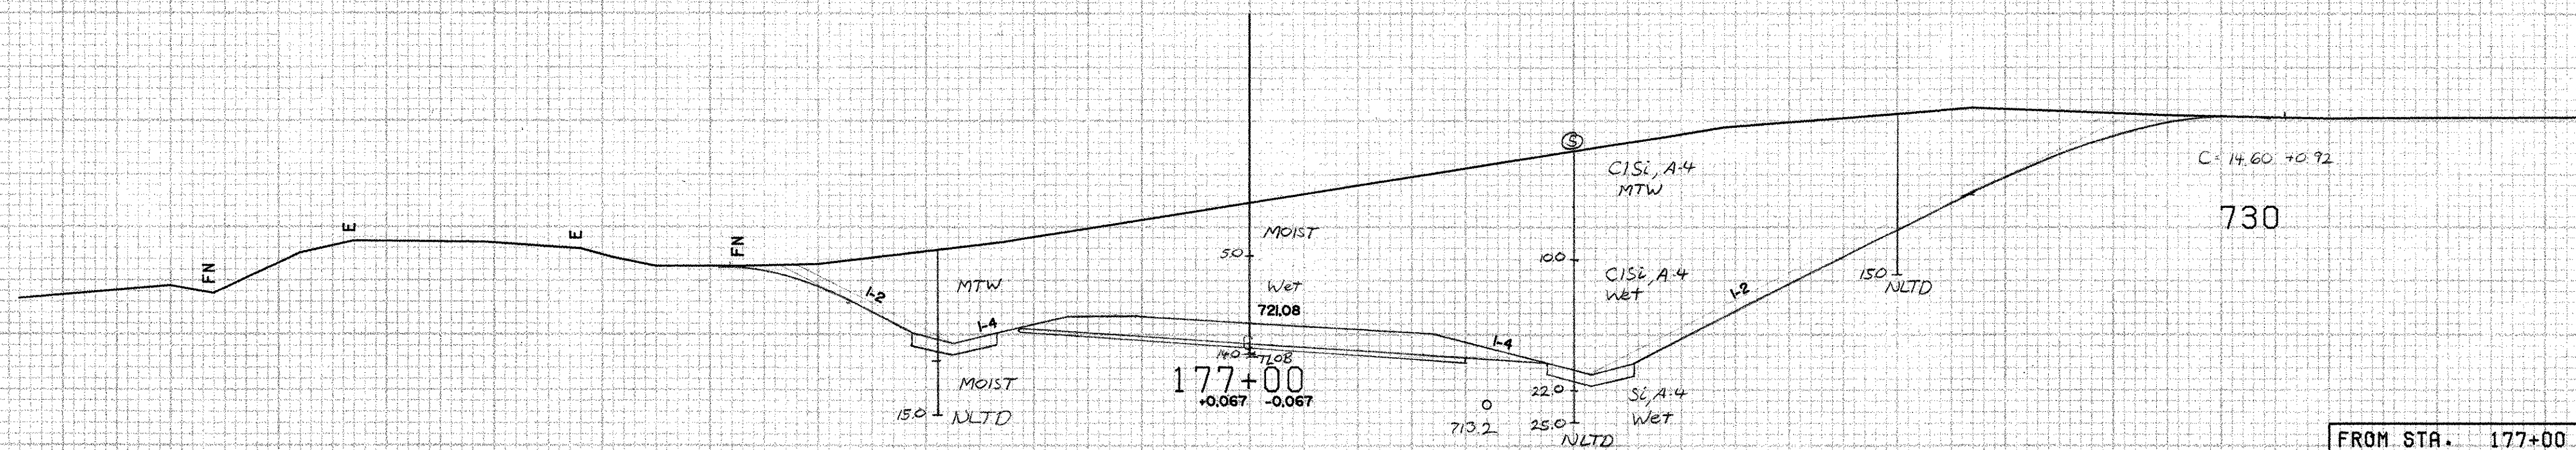


177+75 Lt
 End Excavation of
 Surfaces & Pavements (Exist. TH 2)

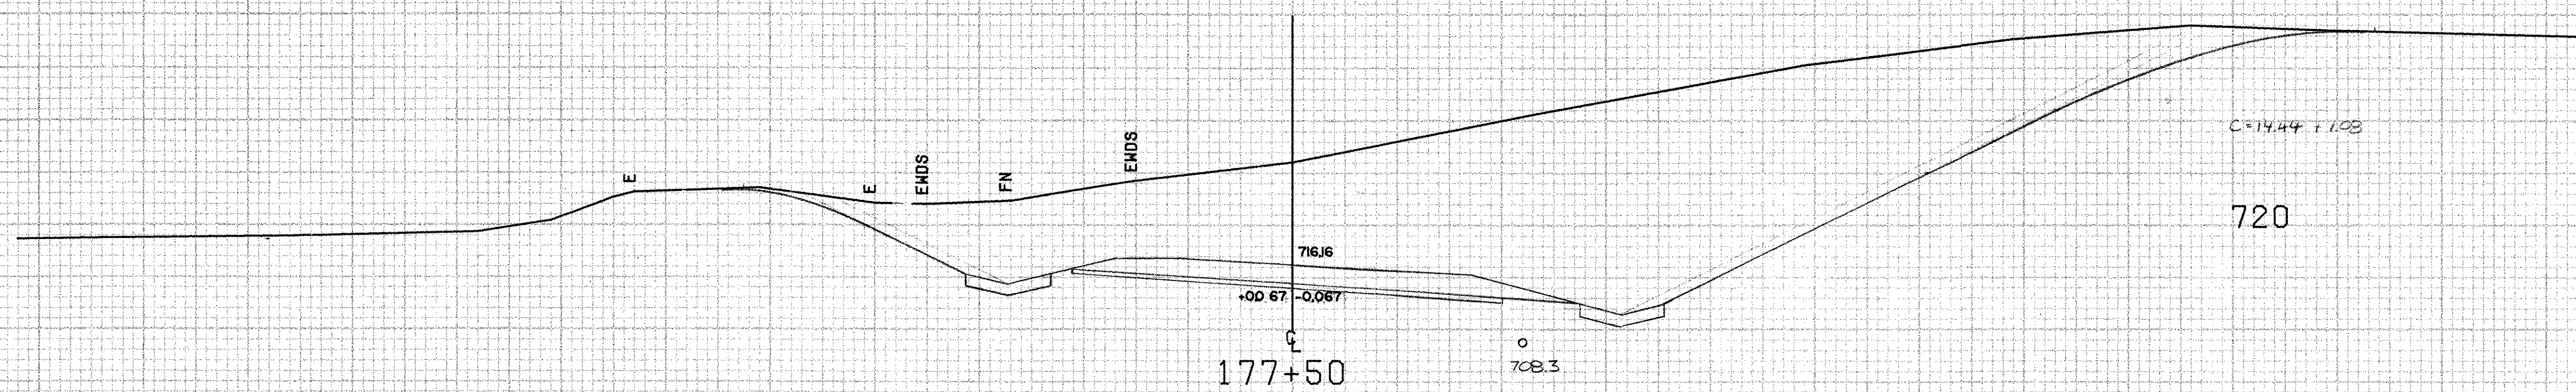

FROM STA.	177+00	TO STA.	178+00
PROJECT NAME	EAST MONTPELIER MAIN		
NO.	RS0246(1)		
SURVEYED BY	LAVALLEE	PLOTTED	02/24/83
SHEET	85 OF 128	SHEETS	JAN82

SCALE 1" = 10 FEET