


179+57 678.39
179+59 678.11

196
6-6' ELMS

Sta 179+80 LT
End Stone F.II, Type I

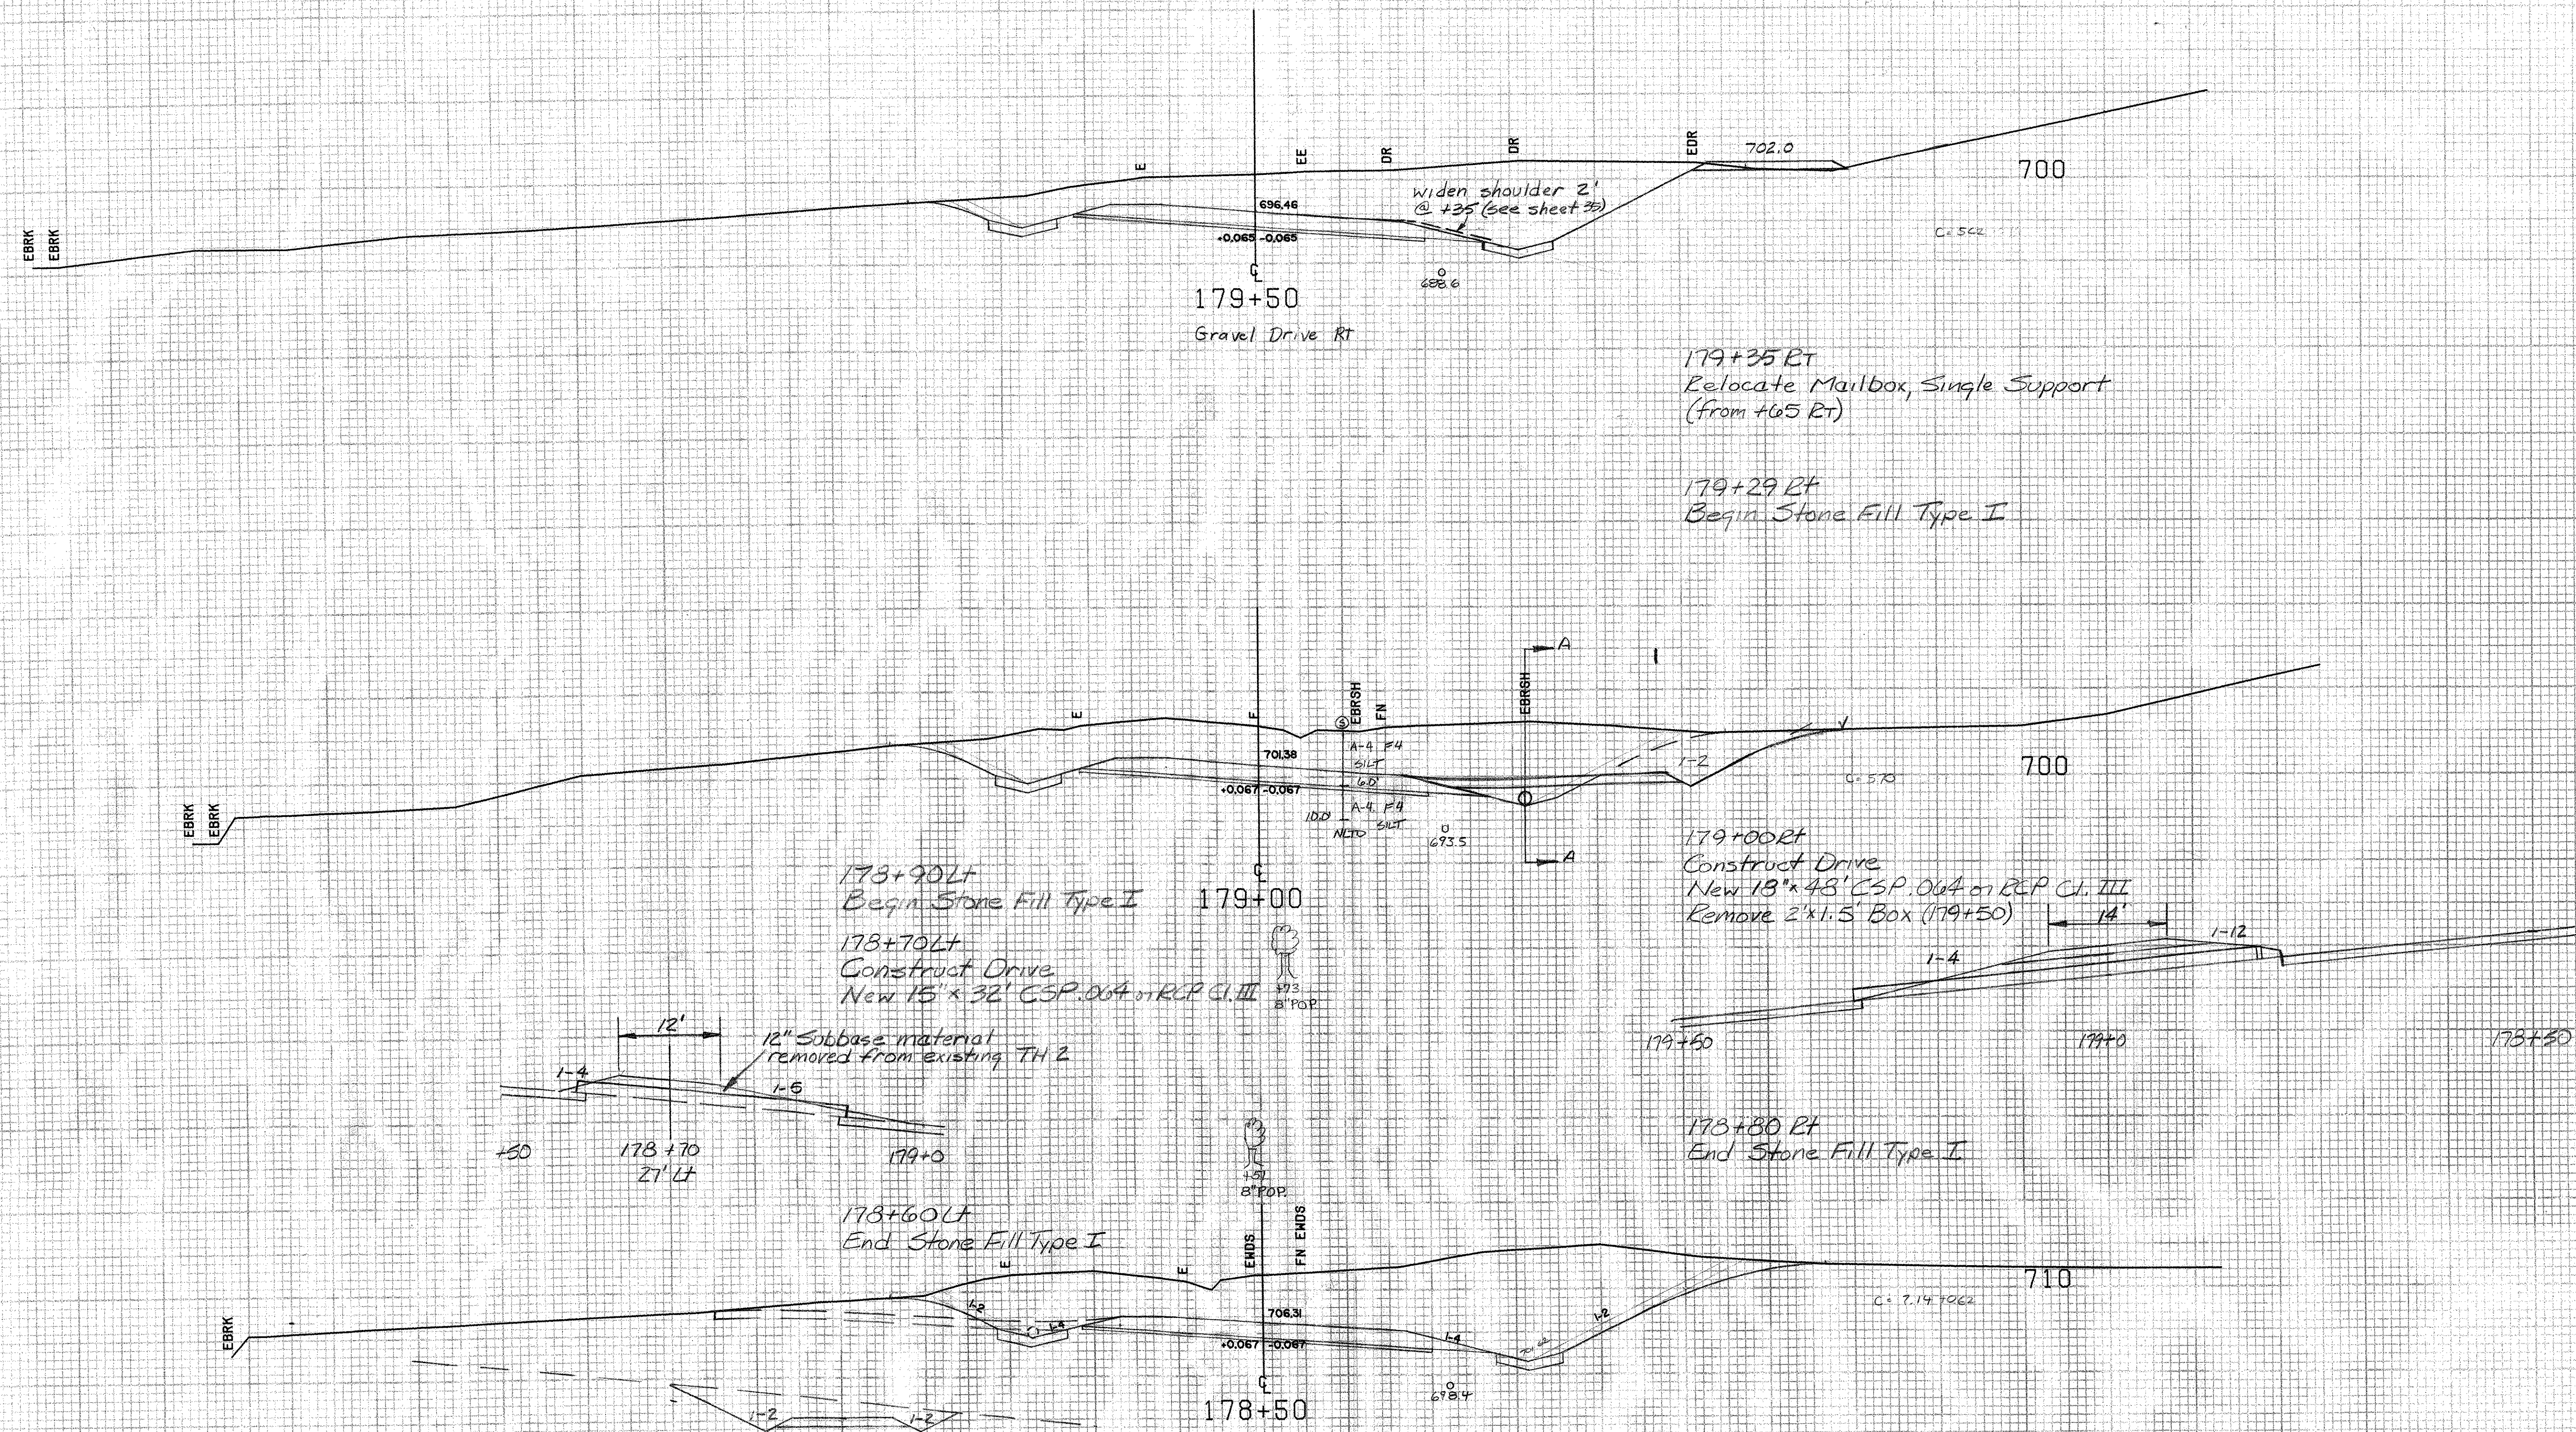

179+35 RT
Relocate Mailbox, Single Support
(from +65 RT)

179+29 RT
Begin Stone Fill Type I

178+90 LT
Begin Stone Fill Type I

178+70 LT
Construct Drive
New 15' x 32' CSP.064 on RCP Cl. III

179+00 RT
Construct Drive
New 15' x 32' CSP.064 on RCP Cl. III
Remove 2' x 1.5' Box (179+50)

178+80 RT
End Stone Fill Type I

12' Subbase material
removed from existing TH 2

178+70
27' LT

178+60 LT
End Stone Fill Type I

FROM STA. 178+50	TO STA. 179+50
PROJECT NAME EAST MONTPELIER MAIN	NO. R50246(1)
SURVEYED BY LAYALLEE	PLOTTED 02/24/83
SHEET 86 OF 120	SHEETS

SCALE 10 FEET