
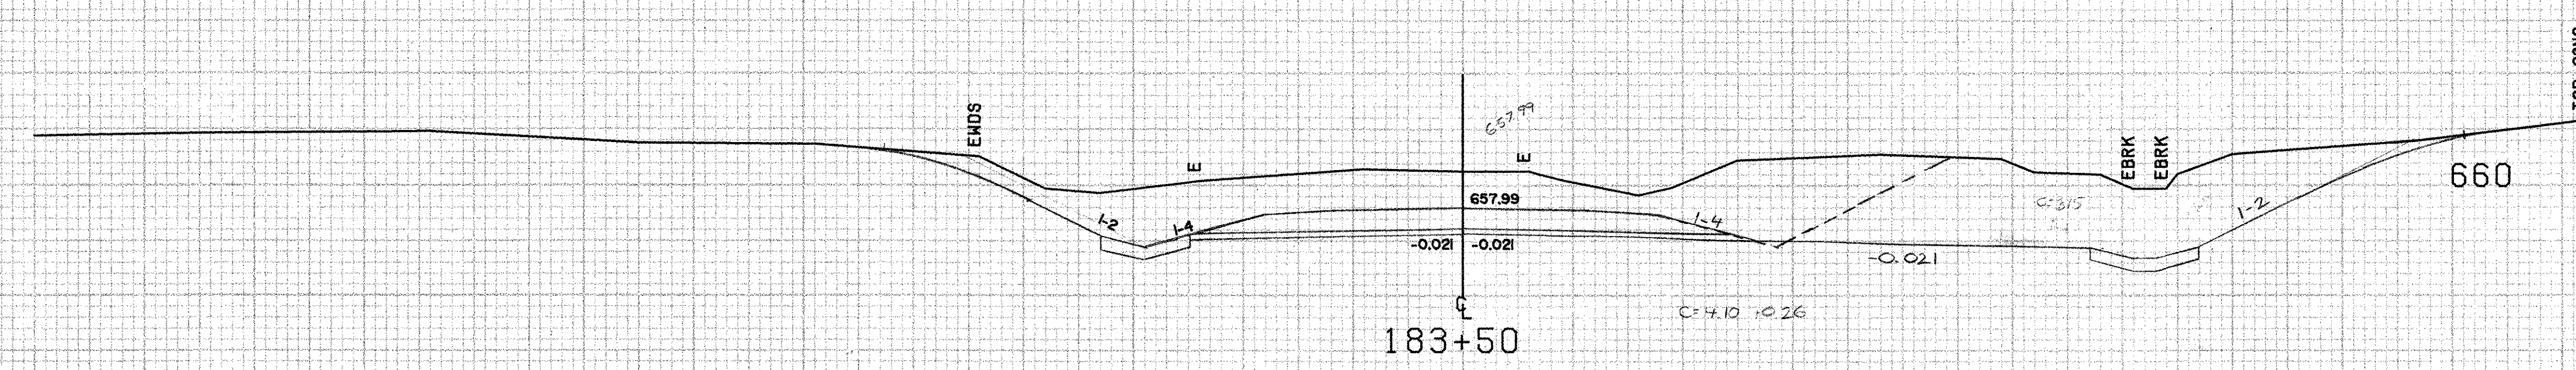


DETAIL INT. US 2 & TH #2
SCALE 1" = 20'

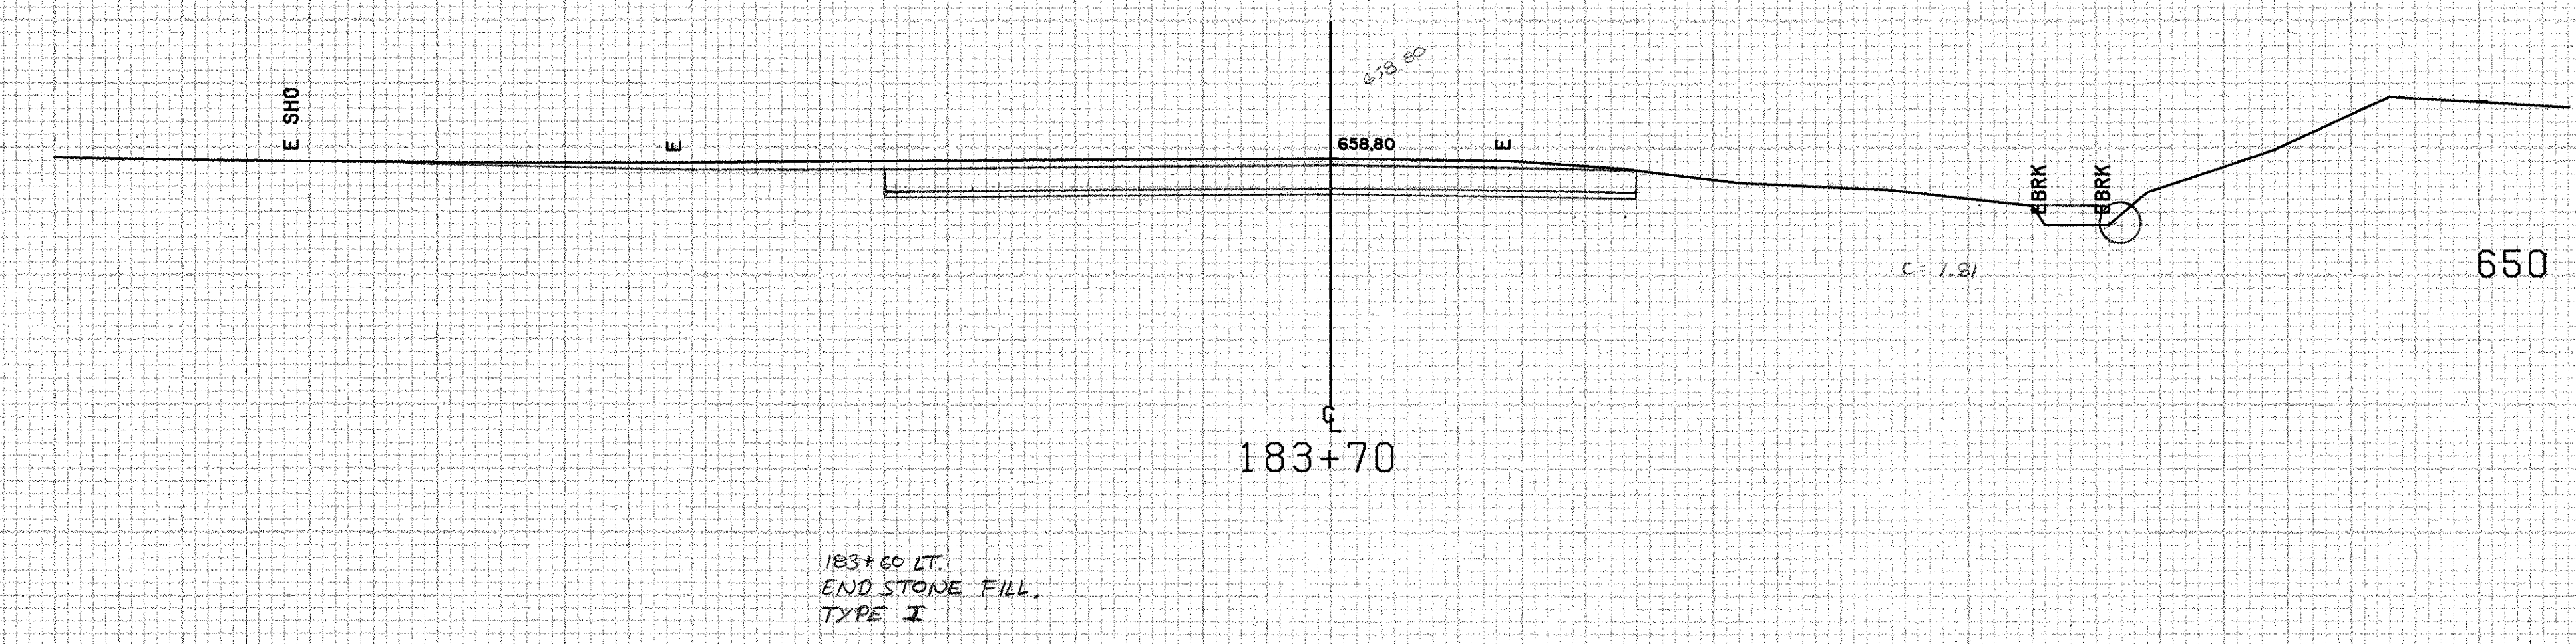

FROM STA. 183+50 TO STA. 183+90.91
PROJECT NAME EAST MONTPELIER MAIN
NO. RS0246(1) PLOTTED 02/24/83
SURVEYED BY LAYALLEE JAN82
SHEET 90 OF 128 SHEETS

SCALE 10 FEET