

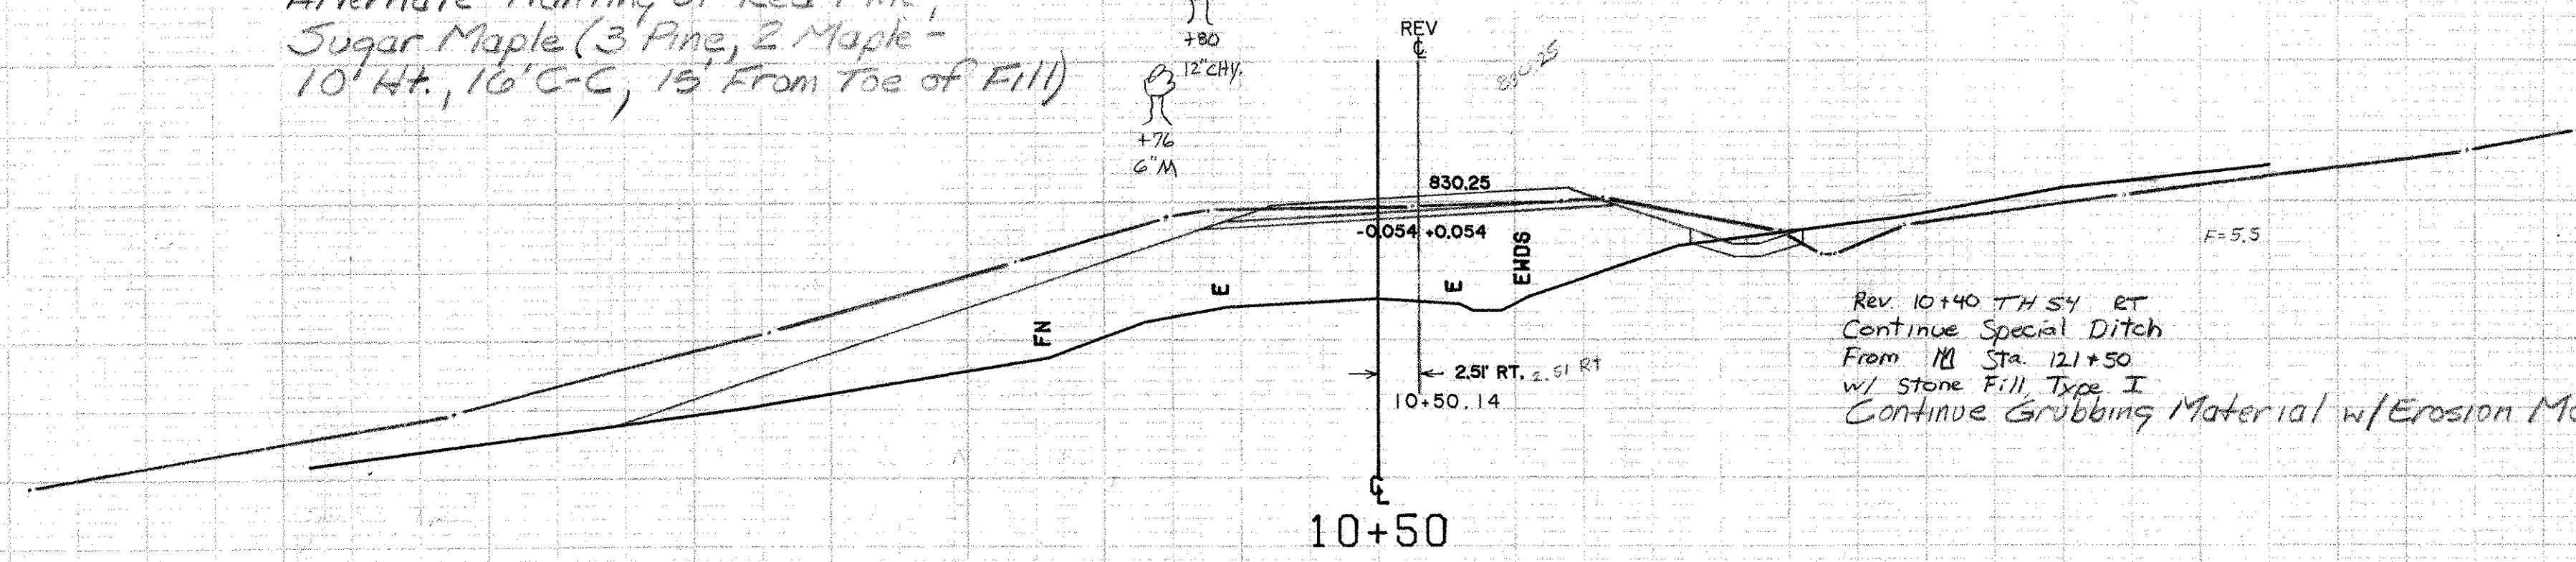


10+60 ~ 11+15 LT
 Evergreen & Deciduous Trees -
 Alternate Planting of Red Pine &
 Sugar Maple (3 Pine, 2 Maple -
 10' Ht., 16' C-C, 15' From Toe of Fill)

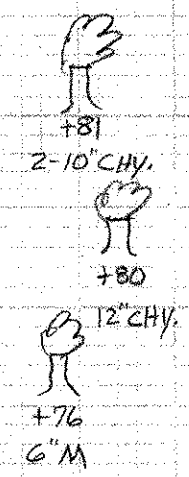

820

10+35 TH 54
 BITUMINUS CONCRETE
 PAVING LIMIT

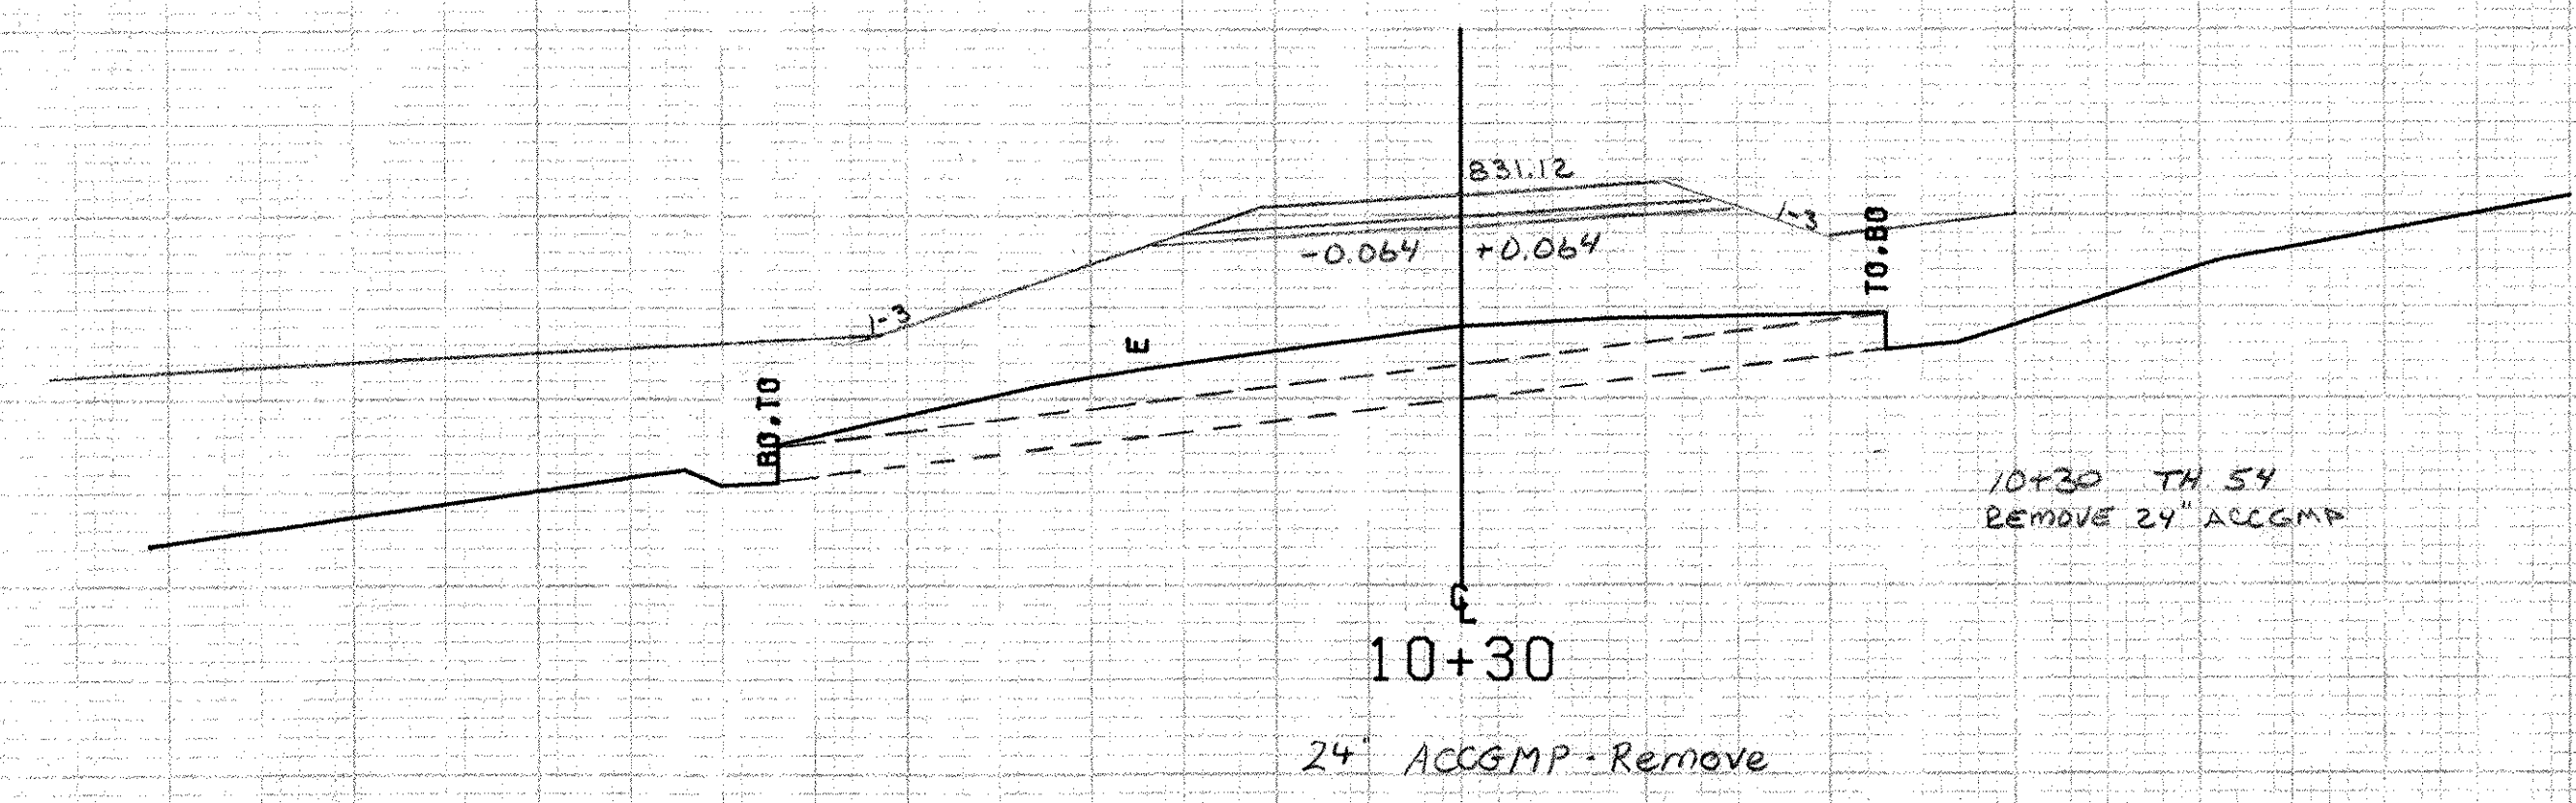


820

10+30 TH 54
 REMOVE 24\"/>

24\"/>

DITCH
 DITCH

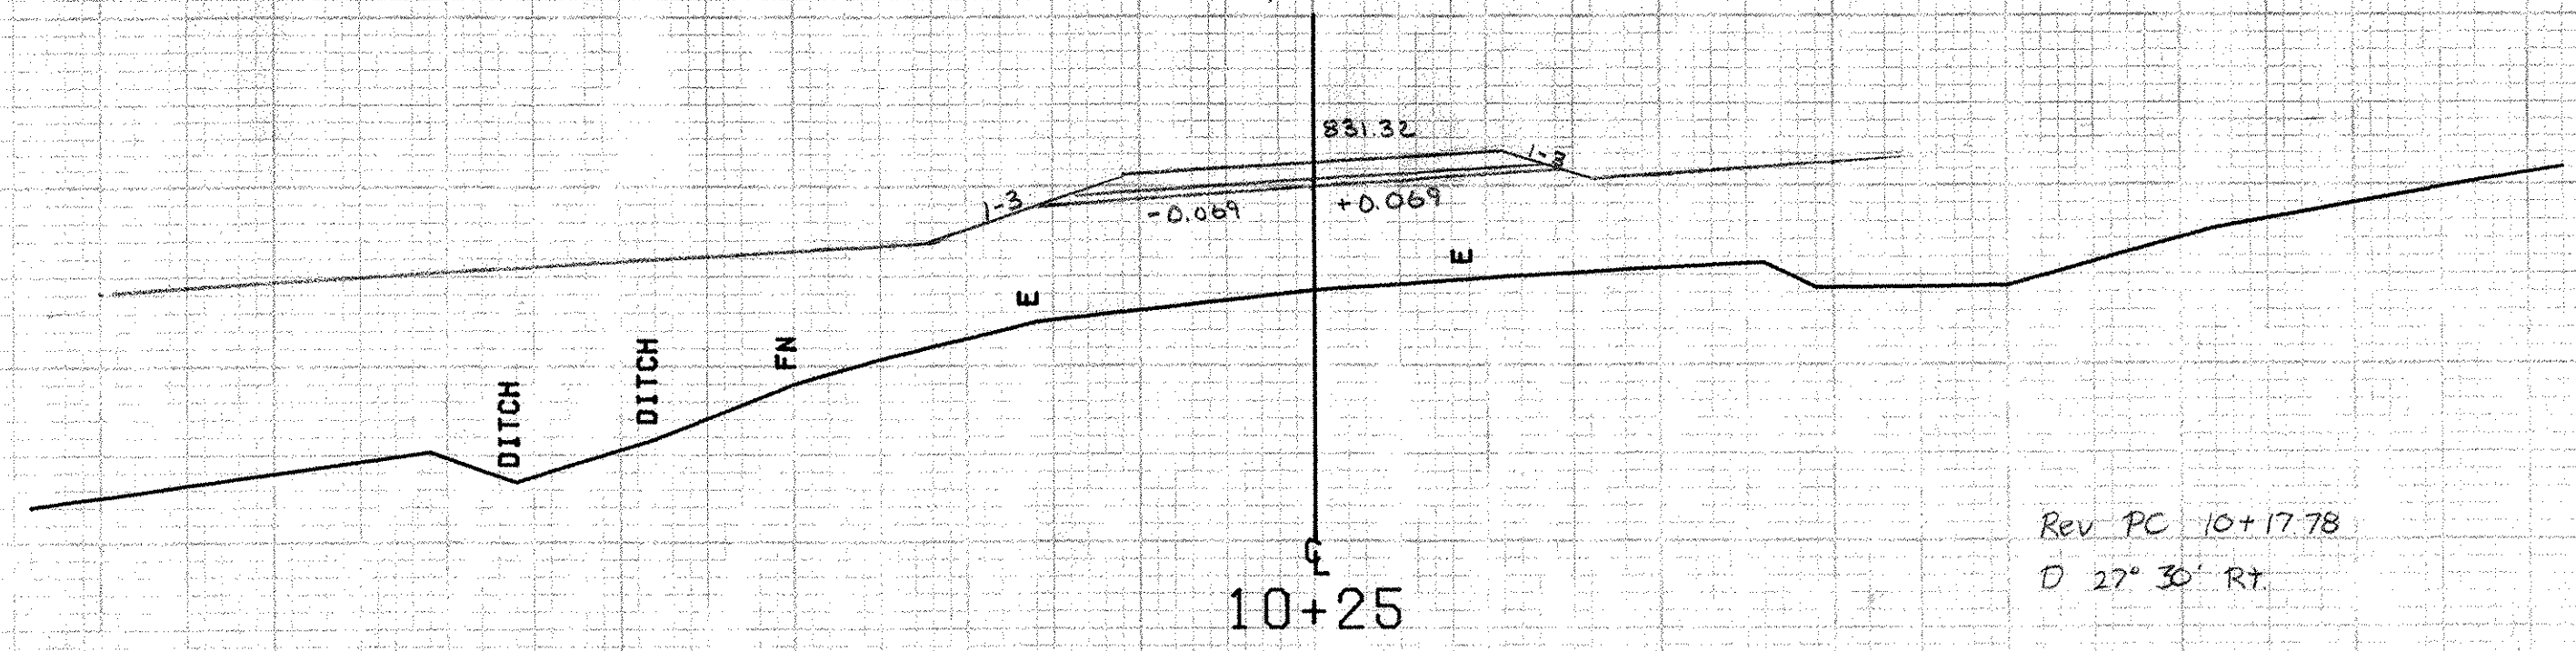

820

Rev. PC 10+17.78
 D 27' 30\"/>

10+25
 M Rev 121+78.89 @ 17' RT =
 TH 54 10+10.59
 Begin Approach Constr.

FROM STA.	10+25	TO STA.	10+50
PROJECT NAME	EAST MONTPELIER TH54		
NO.	RS0246(1)	PLOTTED	02/23/83
SURVEYED BY	LAVALLEE	JAN	82
SHEET	95	OF	128 SHEETS

SCALE 1" = 10 FEET