


REV. PC 12+14.60
 D 17° 00' RT
 Bank 0.42 Ft/Ft

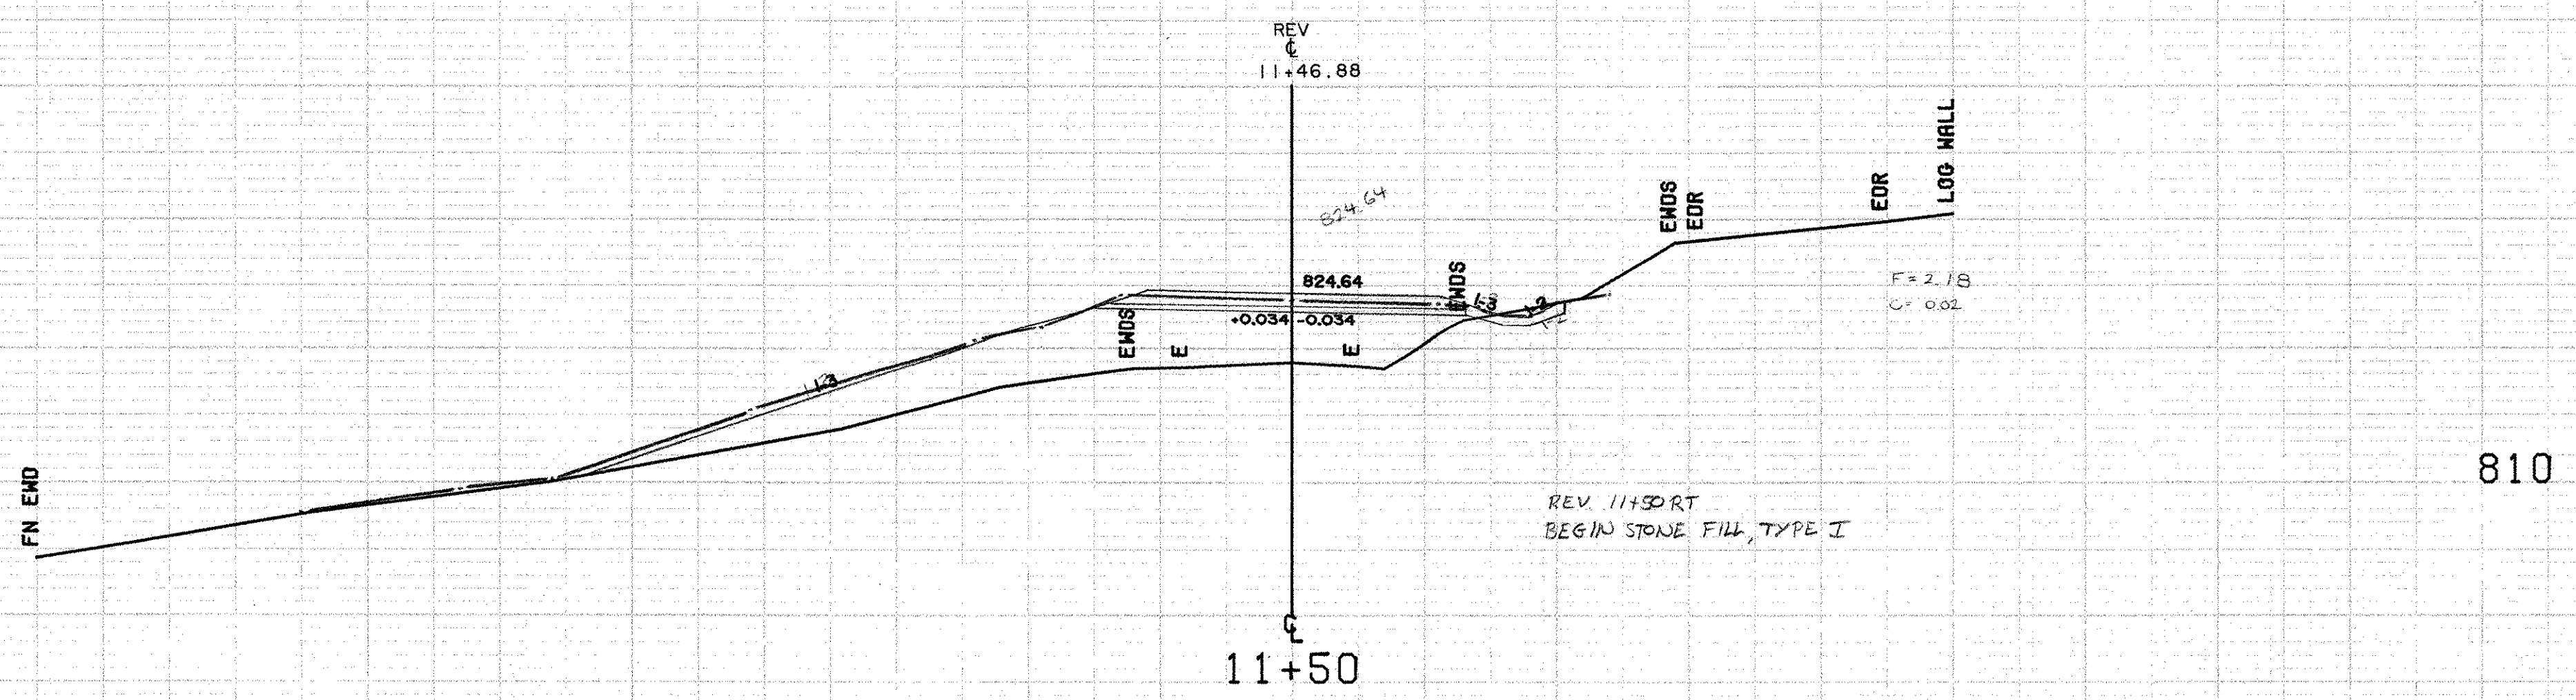

REV 11+30 RT
 BEGIN STONE FILL, TYPE I

FROM STA.	11+50	TO STA.	12+00
PROJECT NAME	EAST MONTPELIER TH54		
NO.	RS0246(1)	PLOTTED	02/23/83
SURVEYED BY	LAVALLÉE	JAN82	
SHEET	97 OF 120	SHEETS	

SCALE 10 FEET