
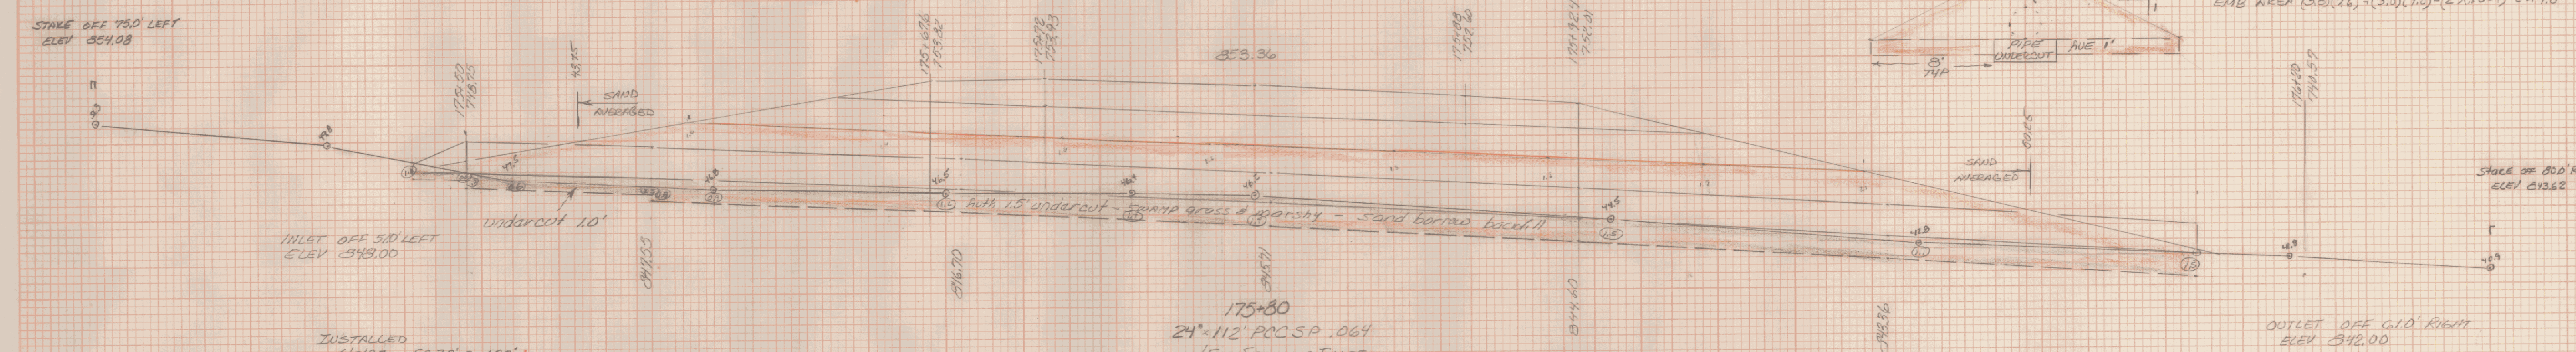


EAST MONTPELIER
RSECC-RS 0246(1)
DRAINAGE SHEET #3
SCALE = 1" = 5'

EMB AREA $(3.8)(26) + (3.8)(1.5) - (2)(.705^2) = 44.0$

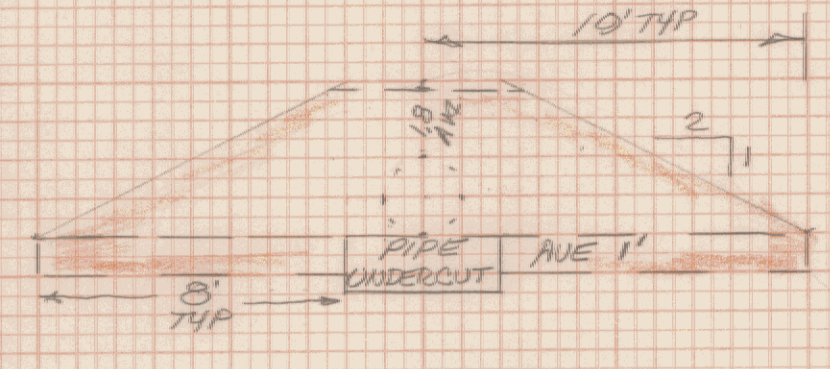

INSTALLED
6/21/92 - 5820' = 100'
7/7/92 - 15.12' = 12"
7/7/92 6"WD SECTION
C.S.
7/21/92


SAND BORROW
UNDERCUT
END SECTION $(2.5)(3)(3.5)(1/2)$ 0.2
PIPE $(10)(12) + (1.5)(100) + (4)(1)(1/2)$ 24.6
FILL $(10)(16)(1/2) + (4)(4)(9/16)(1/2)$ 21.9
244.4 CY
R.L.M. 7/23/92
10/21/92 7/24/92

175+80
24" x 112" PCC SP .064
w/ END SECTION & INLET
STONE PAD @ OUTLET
GRADE 4.72% w/ 6" CAMBER
54° RIGHT

TRENCH EXCAVATION
END SECTION $(3.8)(9.0)(3.5)(1/2)$ 0.3
PIPE $(10)(20) + (2.5)(9) + (1.5)(15) + (1.5)(12) + (1.5)(20) + (1.5)(10)(4)(1/2)$ 22.3
22.6 CY
Inlet stone fill - 2 pg 149
outlet stone fill - 2 pg 149
2.9 R.L.M. 7/24/92
30.5 CY R.L.M. 12-23-93
1.98.94

OUTLET OFF 610' RIGHT
ELEV 842.00

STONE OFF 610' RIGHT
ELEV 837.18

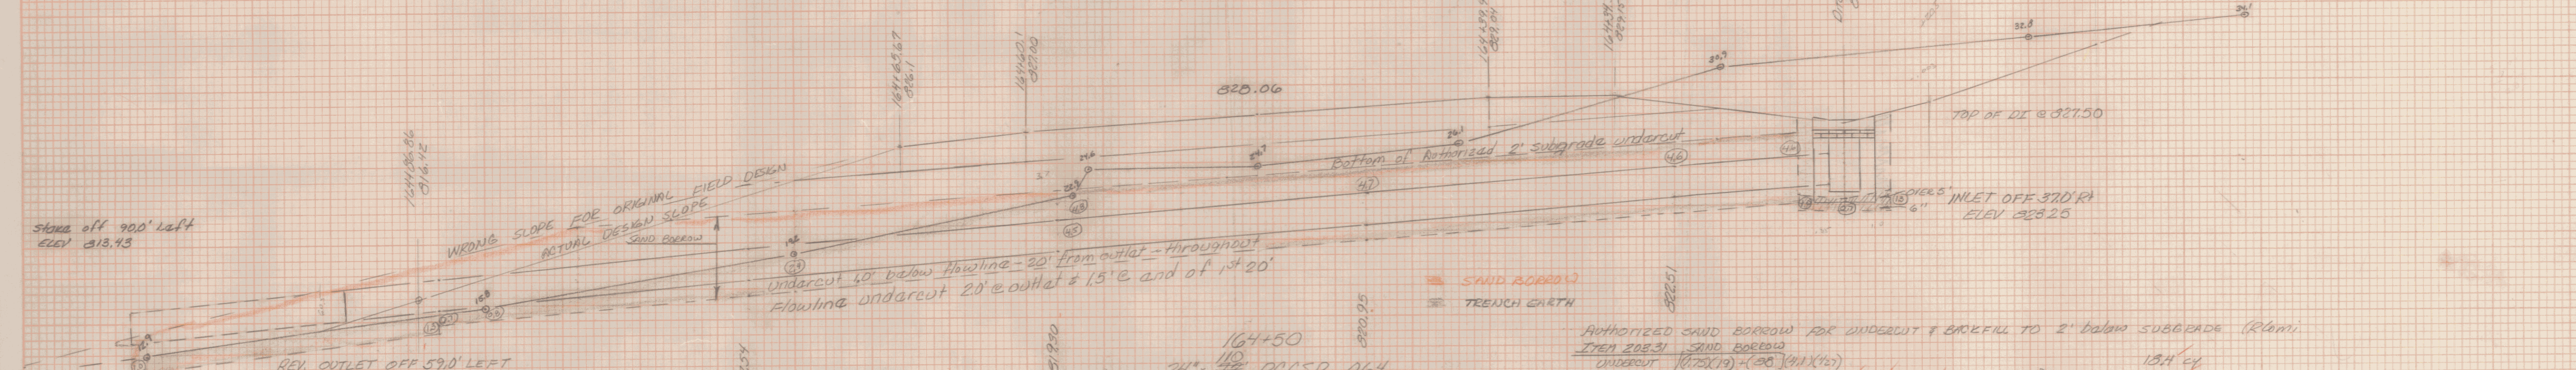


OUTLET OFF 730'
ELEV 818.75
Note:
ORIGINAL DESIGN AND
INSTALLATION WAS WRONG (R.L.M.)
REMOVED 14' ON 7/10/92

INSTALLED ON 4/13/92
REMOVED & REPAID ON 4/14/92
PIPE LENGTHS FROM OUTLET
5' 20' & 10'
OUTLET END REISED TO 6" LONG
(SEE NOTE LEFT)

164+50
24" x 112" PCC SP .064
RCI & INLET w/ TYPE B GATE
STONE PAD @ OUTLET
47°20' LEFT
GRADE 3.64% w/ 1/2" CAMBER

Authorized SAND BORROW FOR UNDERCUT & BACKFILL TO 2' BELOW SUBGRADE (R.L.M.)
ITEM 208.31 SAND BORROW
UNDERCUT $(1.5)(12) + (20)(4)(1/2)$ 18.4 CY
* PIPE $(22.5)(30) + (4)(1)(5.1) + (3.75)(20) + (3.6)(9)(4)(1/2)$ 56.9 CY
DI $(0.5)(6)(6) + (3.75)(20)(1/2)$ 41.9
* pay sand to original design limit (see note for left) 30.2 CY R.L.M. 7-15-92
ITEM 204.20 TRENCH EXCAV
DI $(3)(6)(6) + (2.75)(2)(6)(150\%) (1/2)$ 8.5
PIPE $(115)(10) + (75)(3) + (16)(20) + (2.75)(12) + (4.5)(6.2) + (4.75)(10.7) + (4.15)(20) + (4)(5)(5)(1/2)$ 51.4
59.9 CY
Top stk off 62.7
ELEV. 885.66
R.L.M. 7/23/92
9/21/92

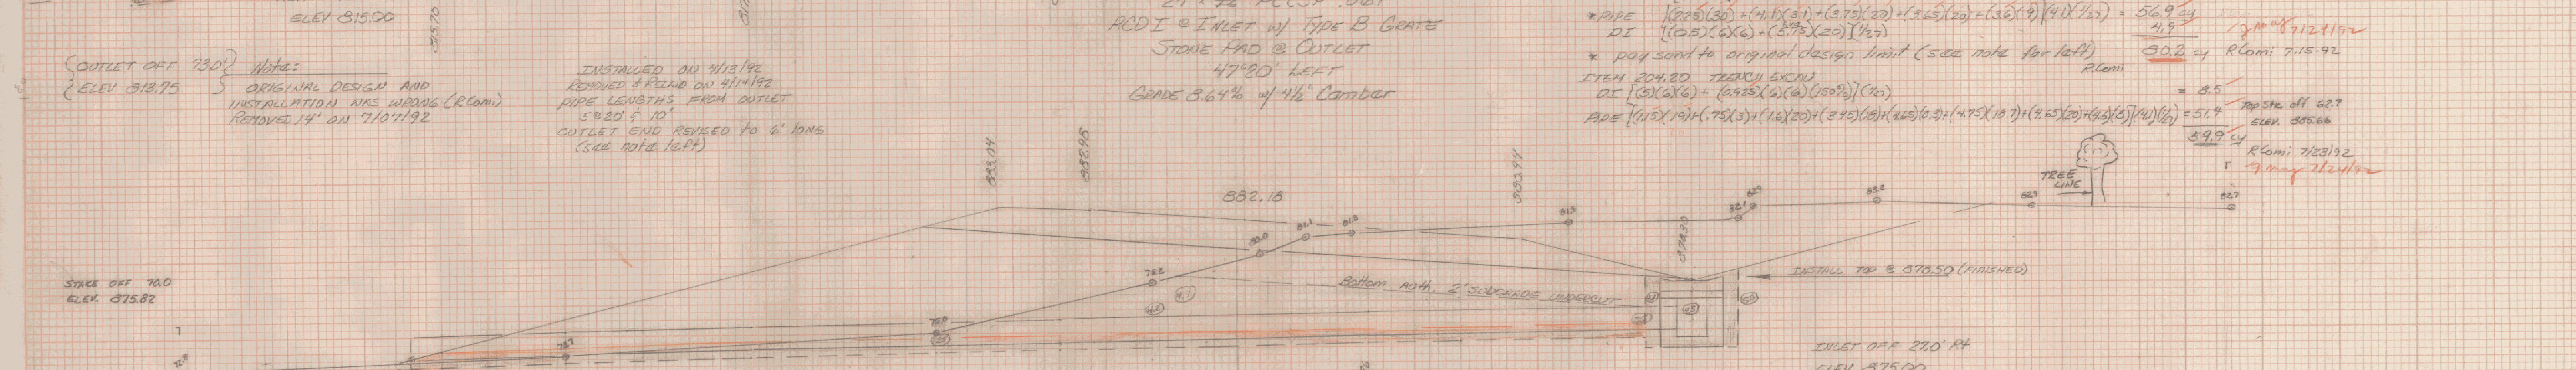

OUTLET OFF 550' LEFT
ELEV 873.50

INSTALLED ENTIRE PIPE ON 6/26/92
PIPE LENGTHS FROM OUTLET
10'-12'-20'-20'

156+45
18" x 82" PCC SP .064
RCI & INLET, w/ TYPE B GATE
@ 90°
GRADE 1.829% w/ 2" CAMBER

TRENCH EXCAVATION
DROP INLET $(4)(3)(3) + (4.75)(3)(6)(1/2)$ 6.2
PIPE 100% $(0.5)(10) + (0.875)(24) + (2.75)(14) + (4.75)(1.5) + (3.4)(30.5)(6)(1/2)$ 24.1
30.3 CY
R.L.M. 7/14/92

INLET OFF 270' RT
ELEV 875.00
POURED DI ON 6/26/92 then buried.
Authorized 6" undercut of flowline throughout
pay sand borrow in undercut & 6" up on pipe
Backfilled pipe w/ excavation

DATE	
BY	
REVISION	
NO.	
DESCRIPTION	
DATE	
BY	
REVISION	
NO.	
DESCRIPTION	
