

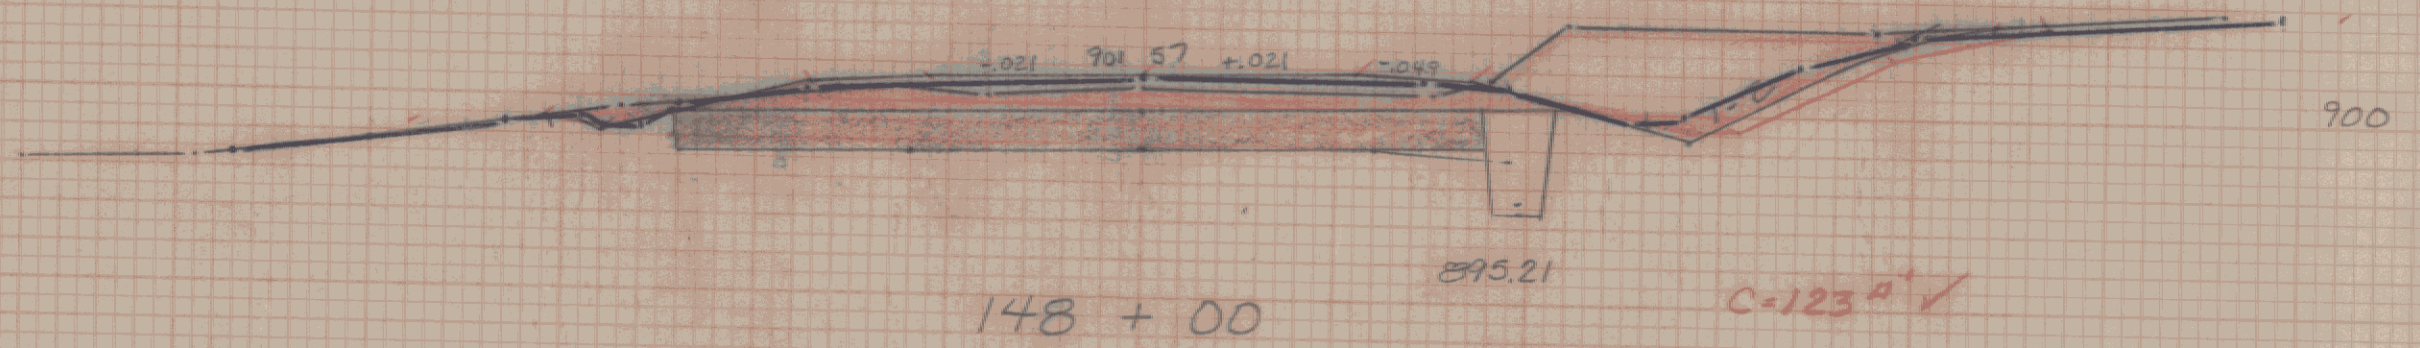


DATE	
BY	
NO.	
REVIEWED	
DESIGNED	
PLOTTED	
TEMPERATURE	
SCALE	
CHECKED	

DATE	1-92
BY	REC
NO.	
REVIEWED	
DESIGNED	
PLOTTED	
TEMPERATURE	
SCALE	
CHECKED	

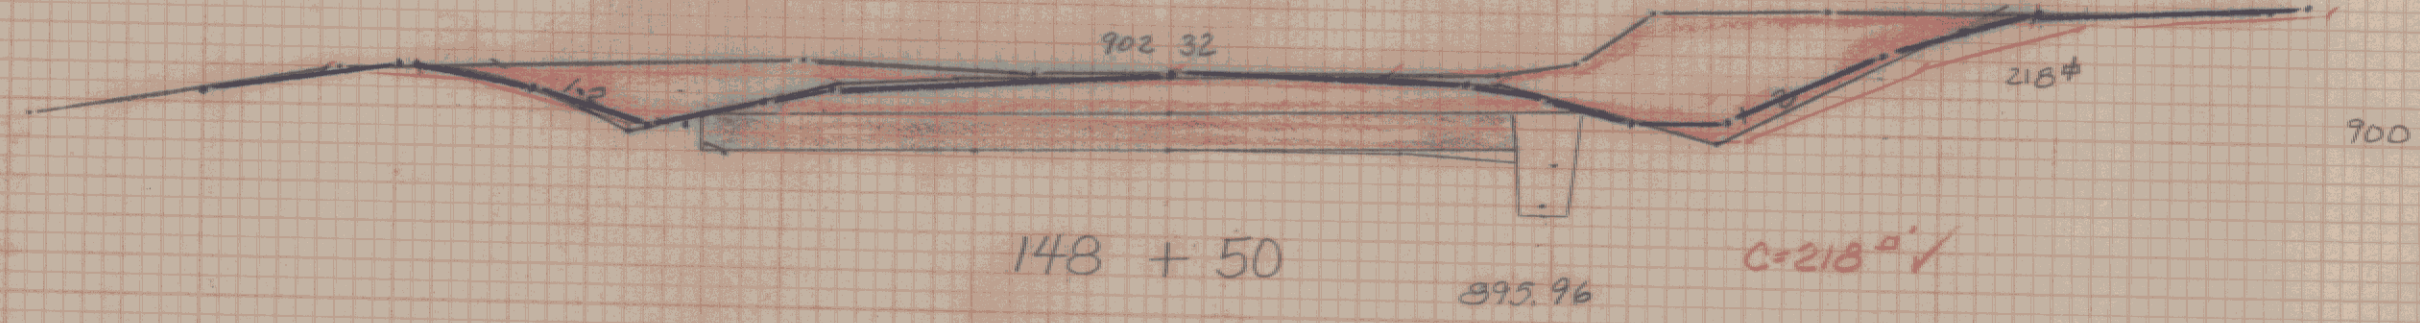

wizard drive 147+26
528.5 21.0'

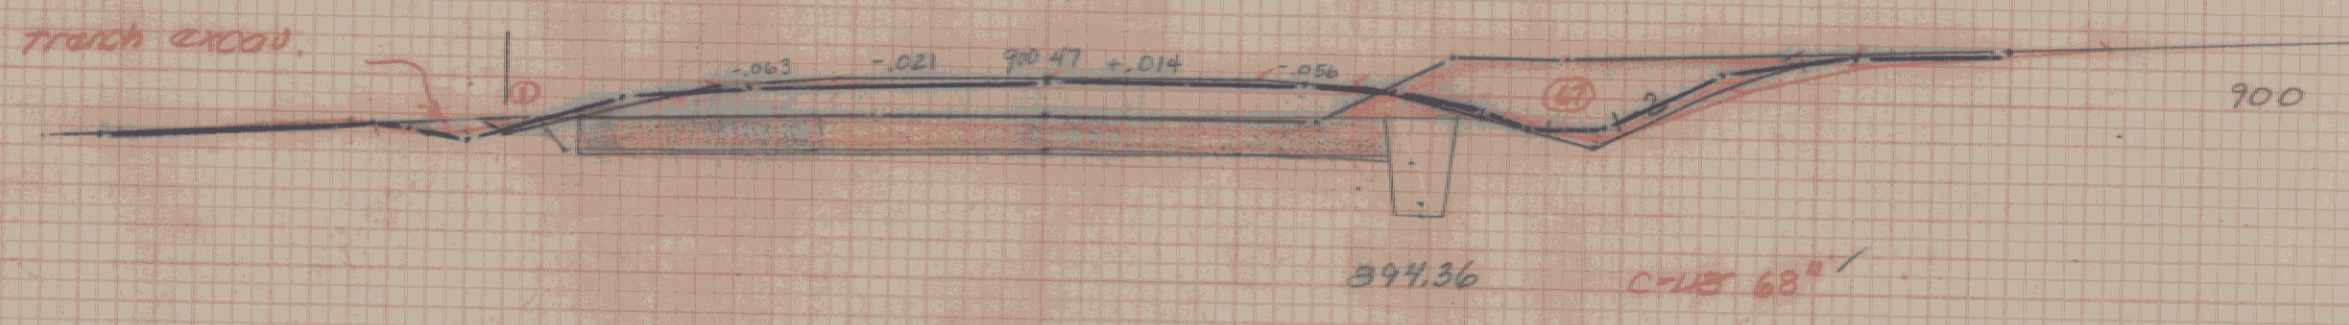

Blue Plot by V4 Survey - Sectioned May 1993 - Prior to Blm. Gate

UNDERDRAIN & UNDERCUT TEMPERED BY KAMI 1-6-93
 FINISH PLOTTED BY R. CAMI 11-5-93
 UNDERCUT 11-19-93
 PLANS BY 12-21-93
 OLD PLAN BY C.E. LOHR 2-1-94
 R.V. 2-1-94

KEY SECTIONS
 STA. 147+50 ~ 148+50
 EAST MONTPELIER
 RSECC RS 0246(1)
 SHEET 4A OF 17A