


DATE	
BY	
ORIGINAL SURVEY	
ADJUSTED SURVEY	
PLATTED	
TEMPLATE	
SCALE	
ANGLS. CHECKED	
NO.	

DATE	
BY	
ORIGINAL SURVEY	
ADJUSTED SURVEY	
PLATTED	
TEMPLATE	
SCALE	
ANGLS. CHECKED	
NO.	

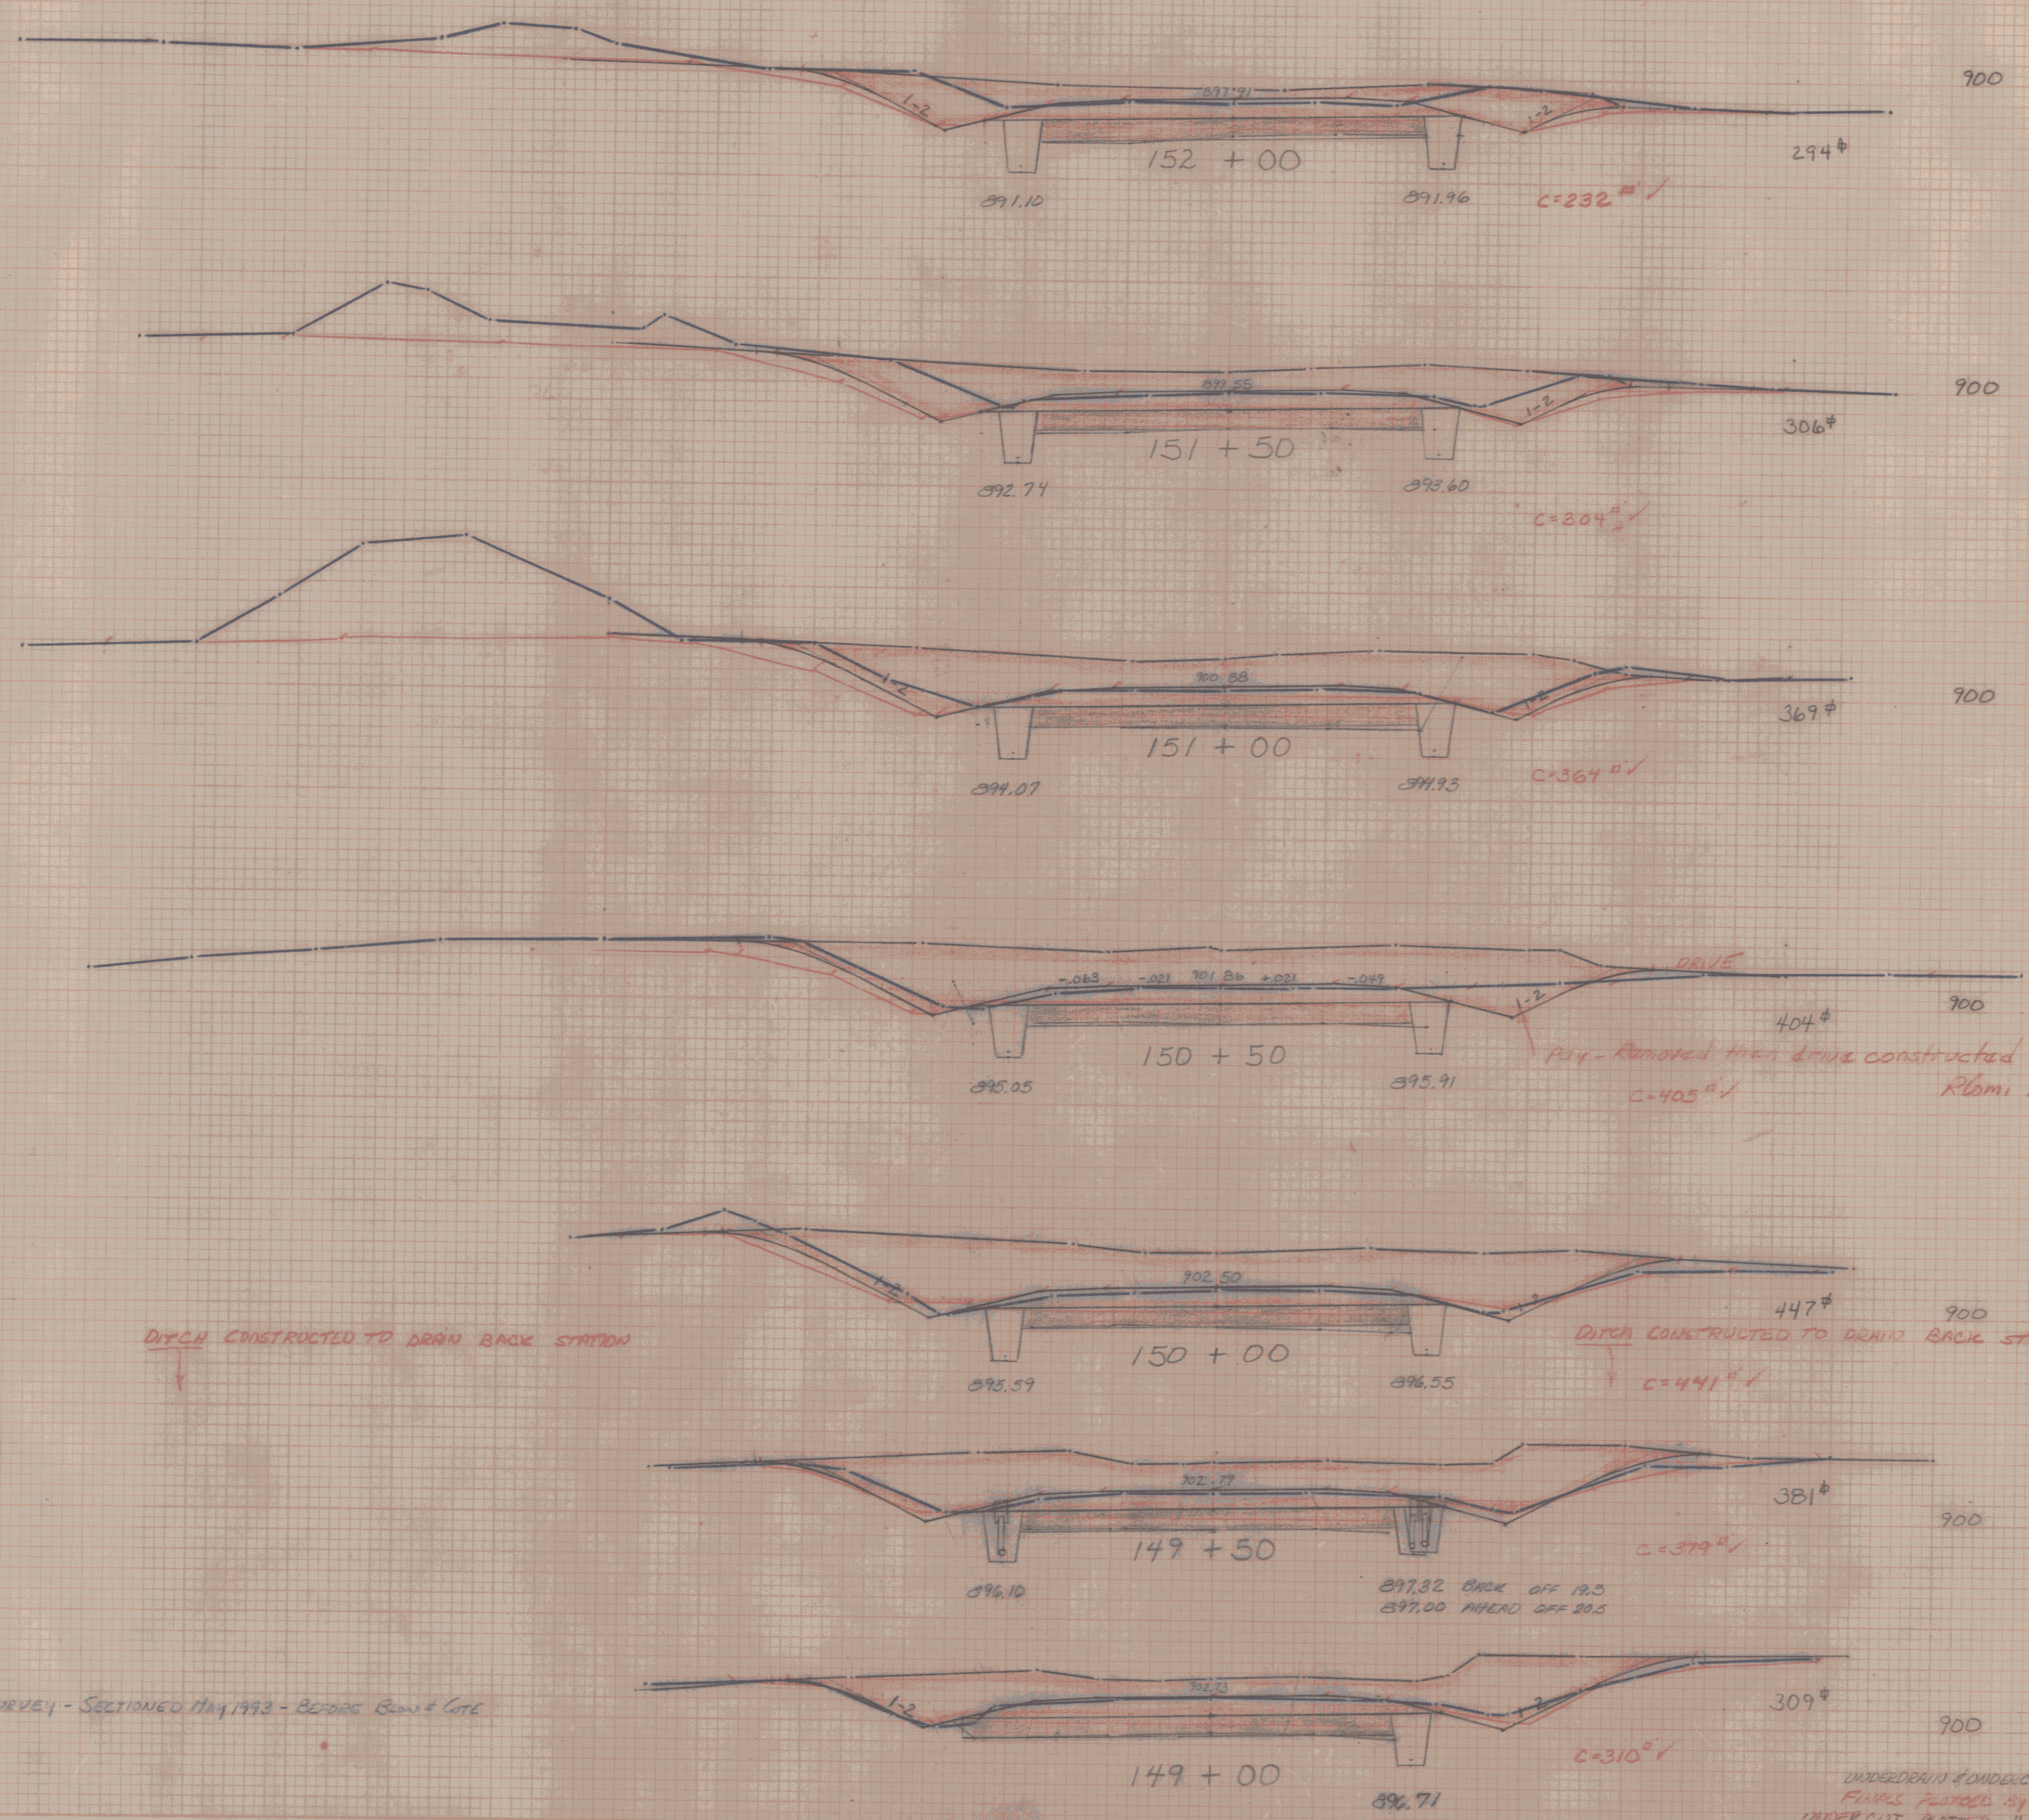

BLUE PLAT BY V.F. SURVEY - SECTIONED MAY 1993 - BEFORE BRIDGE & GATE

REV. SECTIONS  
 STA. 149+00 ~ 152+00  
 EAST MONTPELIER  
 RSEGC-RS 0246 (1)  
 SHEET 5A OF 17A

UNDERSIDE OF UNDERCUT REEMPLATED BY RLOmi 1-6-93  
 FINISH PLOTTED BY RLOmi 11-5-93  
 UNDERCUT PLOTTED " " 11-7-93  
 DRAWING BY " " 12-21-93  
 CKD PLAN BY C.B. DANA 2-1-94