


DATE  
BY  
SURVEYED  
PLOTTED  
CHECKED  
REVISIONS  
NO. DATE

DATE  
BY  
SURVEYED  
PLOTTED  
CHECKED  
REVISIONS  
NO. DATE

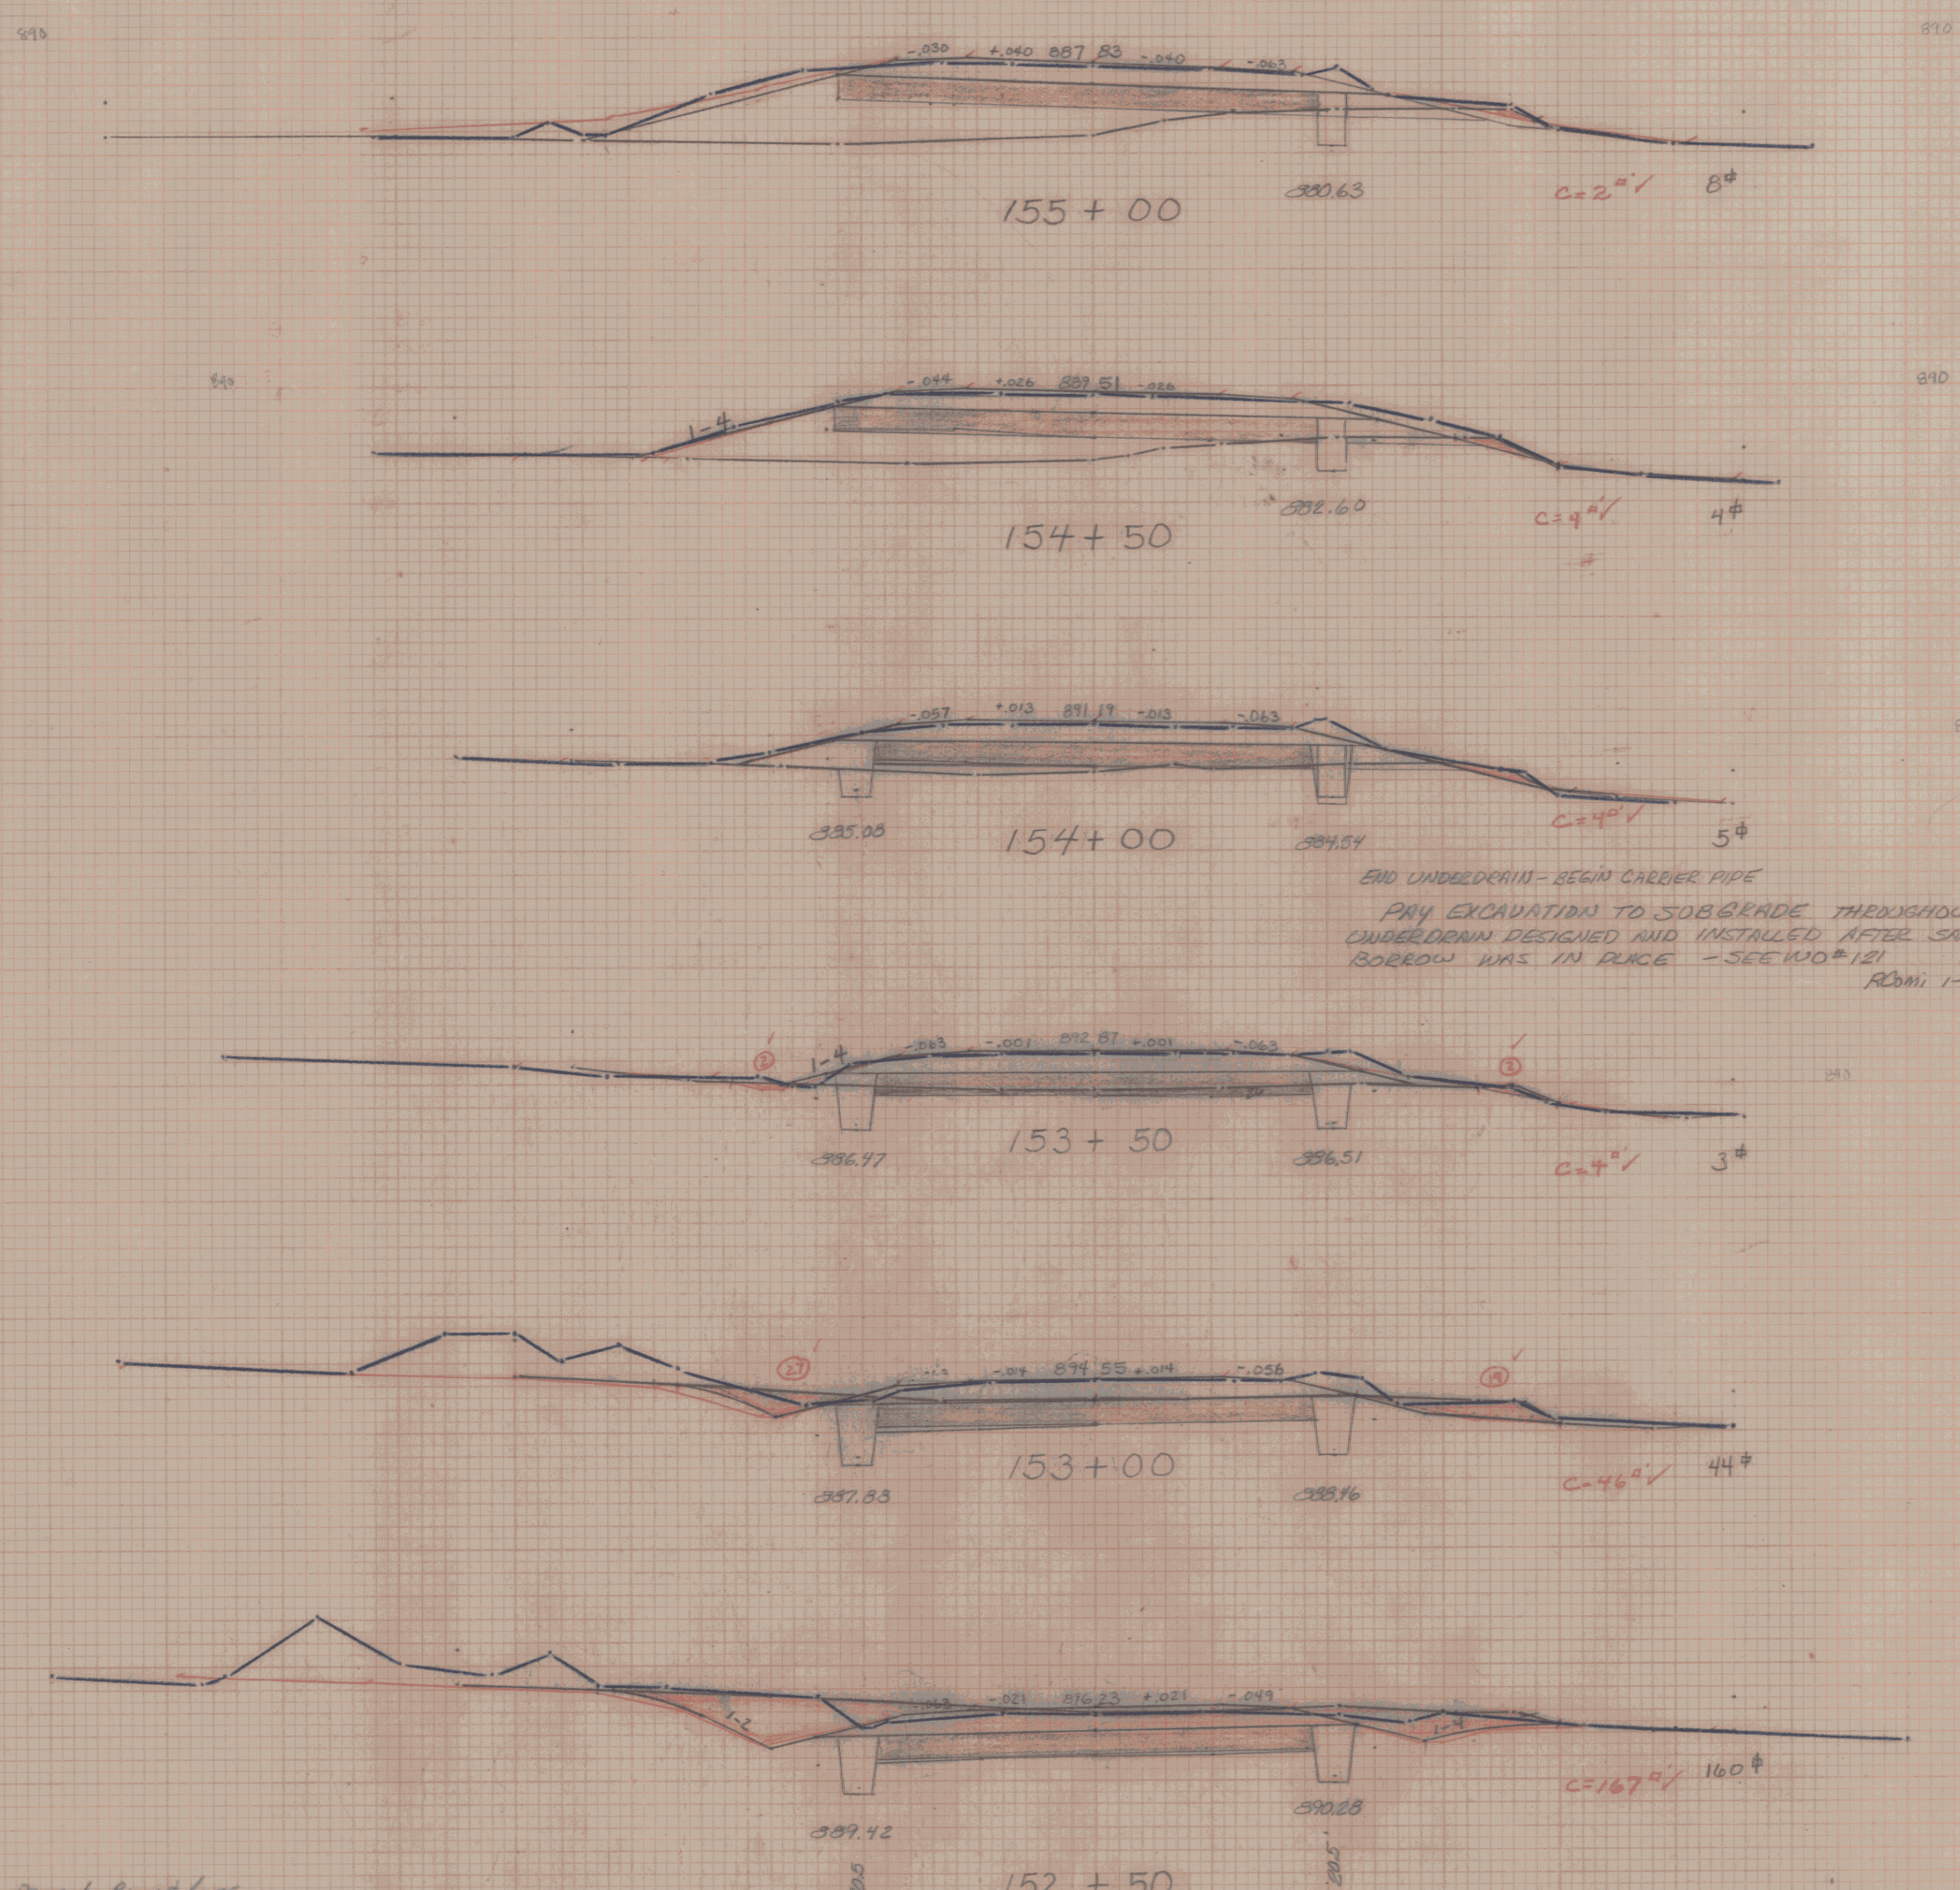

END UNDERDRAIN - BEGIN CARRIER PIPE  
 PLY EXCAVATION TO SOB GRADE THROUGHOUT.  
 UNDERDRAIN DESIGNED AND INSTALLED AFTER SAND  
 BORROW WAS IN PLACE - SEE NO# 121  
 ROOM 1-6-93

Blue Print of V Survey - Sectioned 17th 1993 - Prior to Beam & Lane

UNDERDRAIN & UNDERCUT (SAND BORROW) TEMPLATED BY ROOM 1-6-93  
 FINAL PLOTTED BY R. Com. 11-8-93  
 SAND BORROWED 11-22-93  
 PLANNED 12-22-93  
 OK'D. PLAN. BY C.E.A. HR 2-1-94

REV. SECTIONS  
 STA 152+50 ~ 155+00  
 EAST MONTPELIER  
 RSEGC RS 0246 (1)  
 SHEET 6A OF 17A