


DATE	
BY	
REVISIONS	
NO.	
DESCRIPTION	
DATE	
BY	
REVISIONS	
NO.	
DESCRIPTION	
DATE	
BY	

DATE	
BY	
REVISIONS	
NO.	
DESCRIPTION	
DATE	
BY	
REVISIONS	
NO.	
DESCRIPTION	
DATE	
BY	

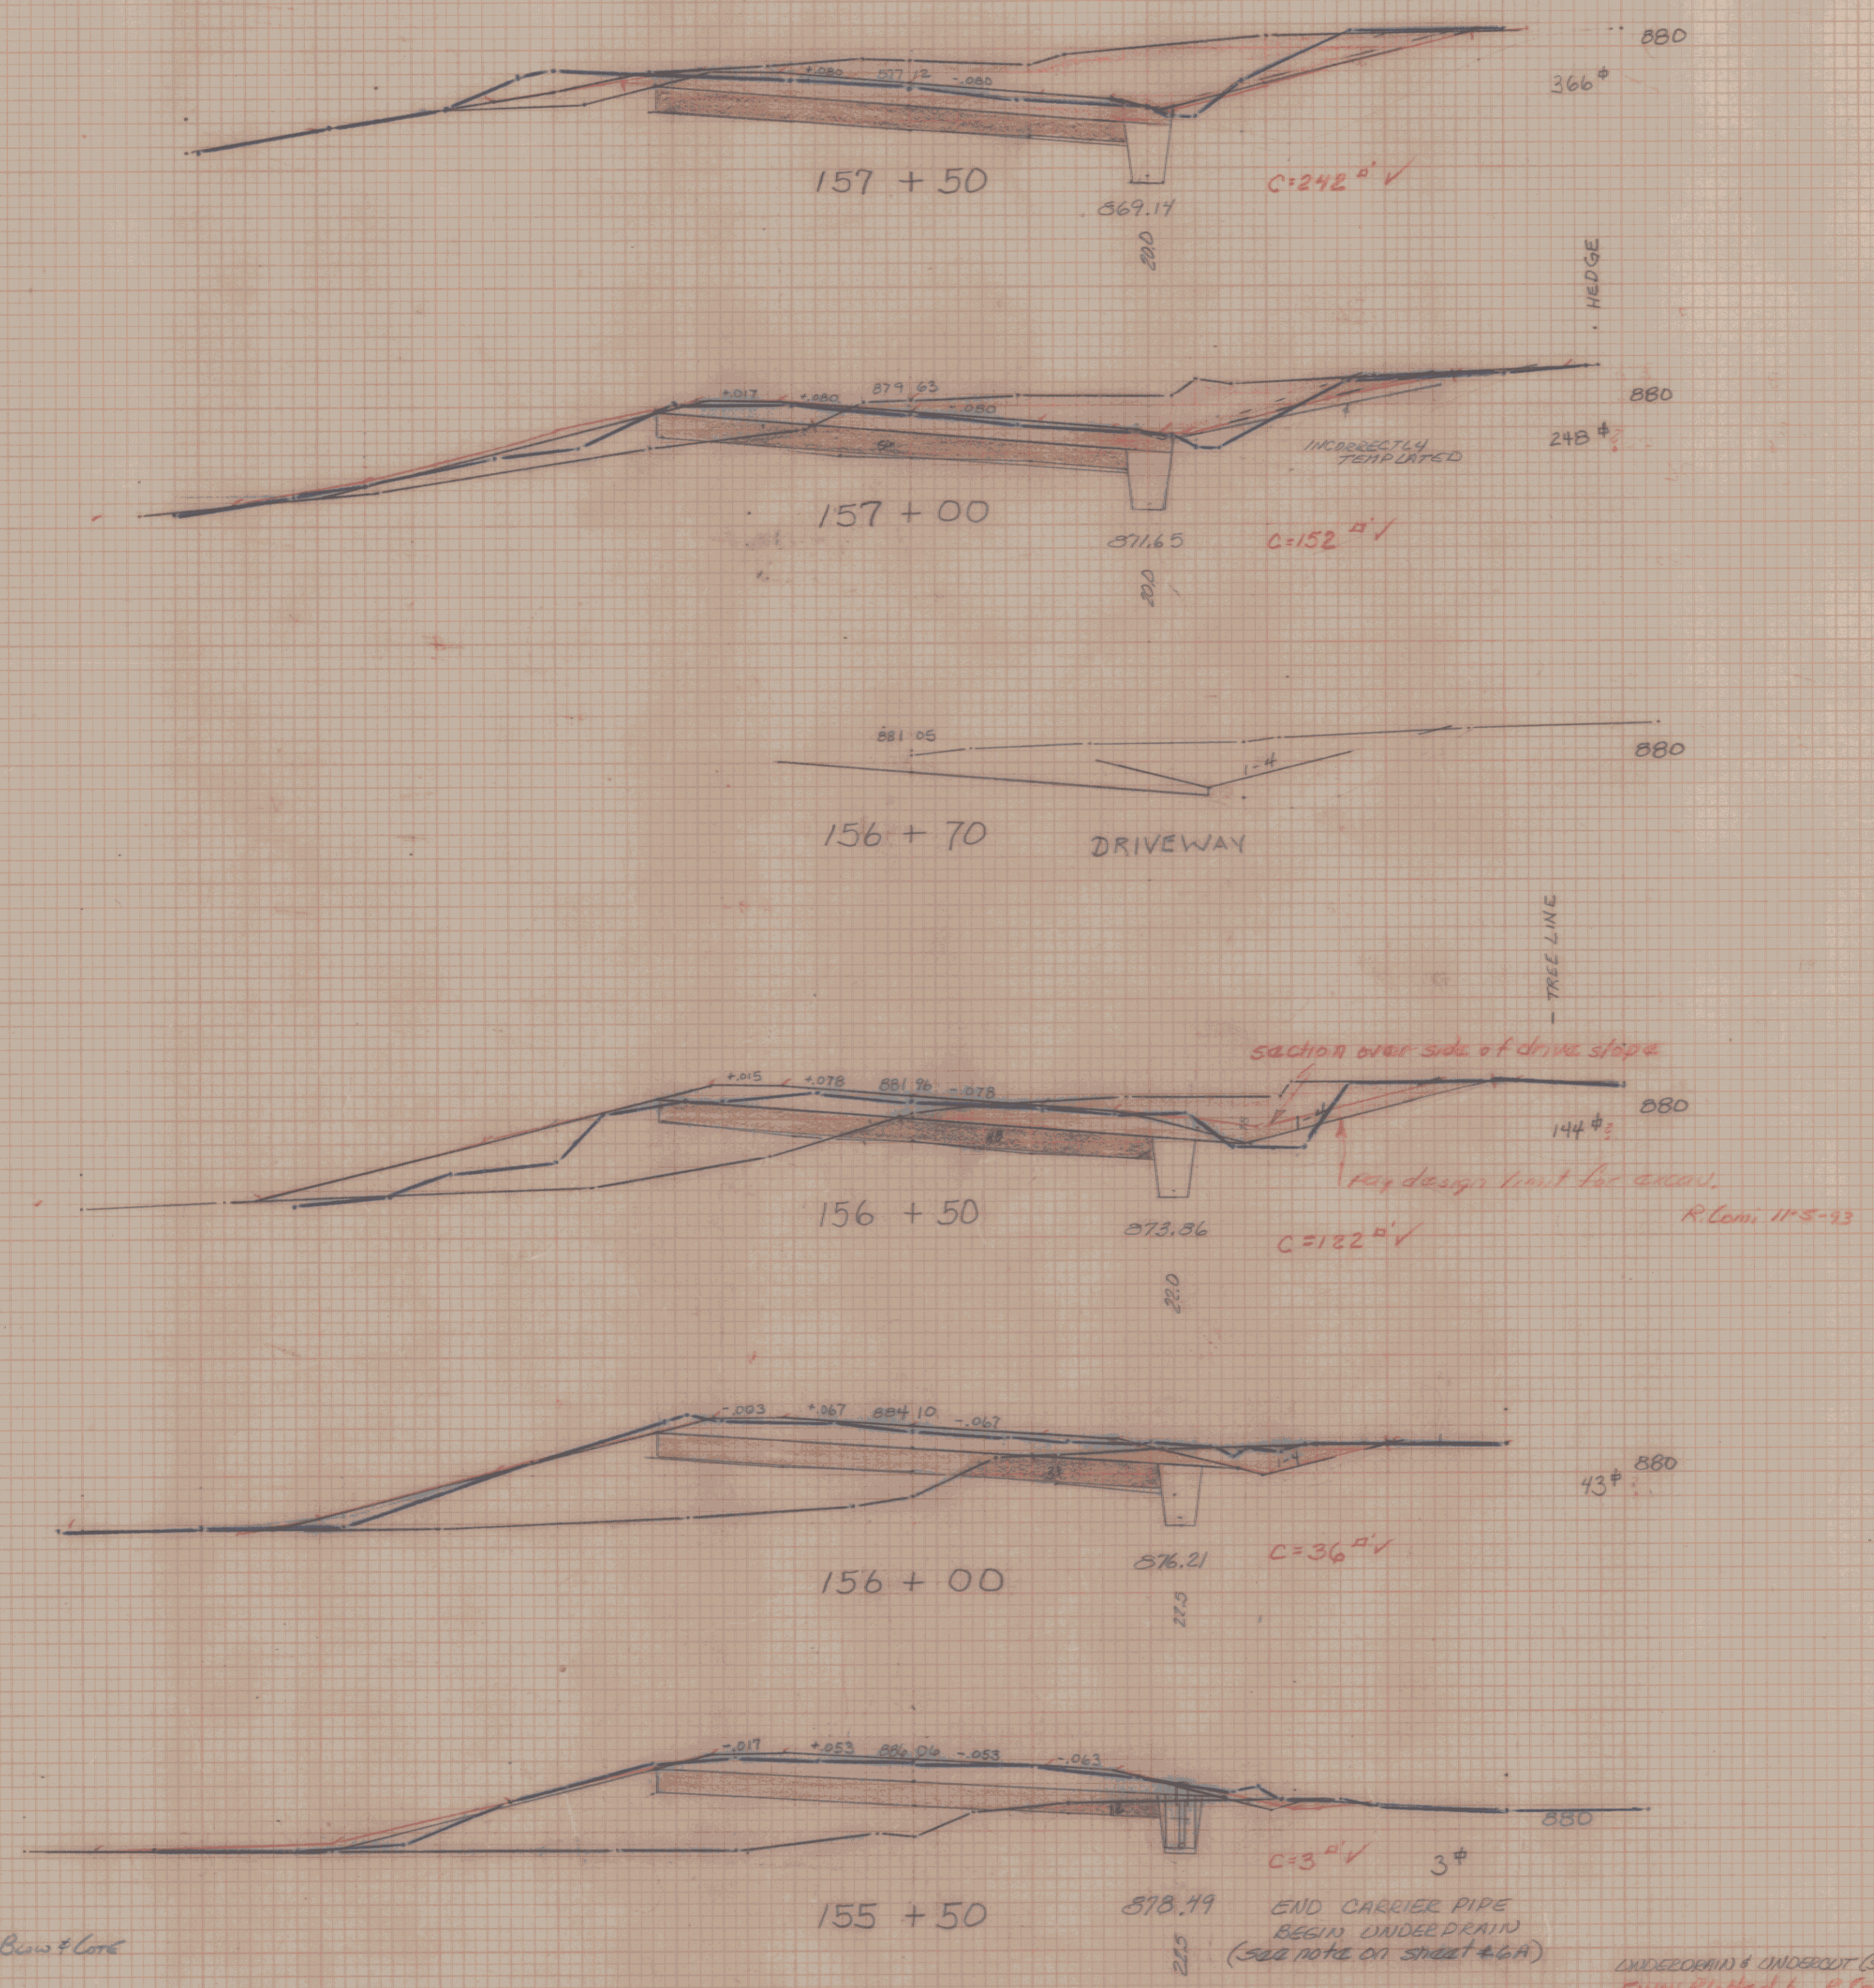

Blue Plot by VA Survey - Sectioned May 1993 - Prior to Best Lot

END CARRIER PIPE  
BEGIN UNDERDRAIN  
(See note on sheet #6A)

UNDERDRAIN & UNDERCUT (SHOULD BE BUILT) TEMPLATED BY RGM 1-6-93  
 FINISH PLOTTED BY R. COMI 11-5-93  
 11-22-93  
 12-22-93  
 CRD. PLANS BY C.E. JAMES 2-1-94

REV. SECTIONS  
 STA 155+50 ~ 157+50  
 EAST MONTPELIER  
 RSEGC RS 0246(1)  
 SHEET 7A OF 17A