


FINAL
 SURVEY
 PLANNED
 TEMPLATE
 NOTE BOOK
 AREA
 CHECKED

DATE
 REVISIONS
 TAC
 TAC
 ORIGINAL
 SURVEY
 PLANNED
 TEMPLATE
 NOTE BOOK
 AREA
 CHECKED

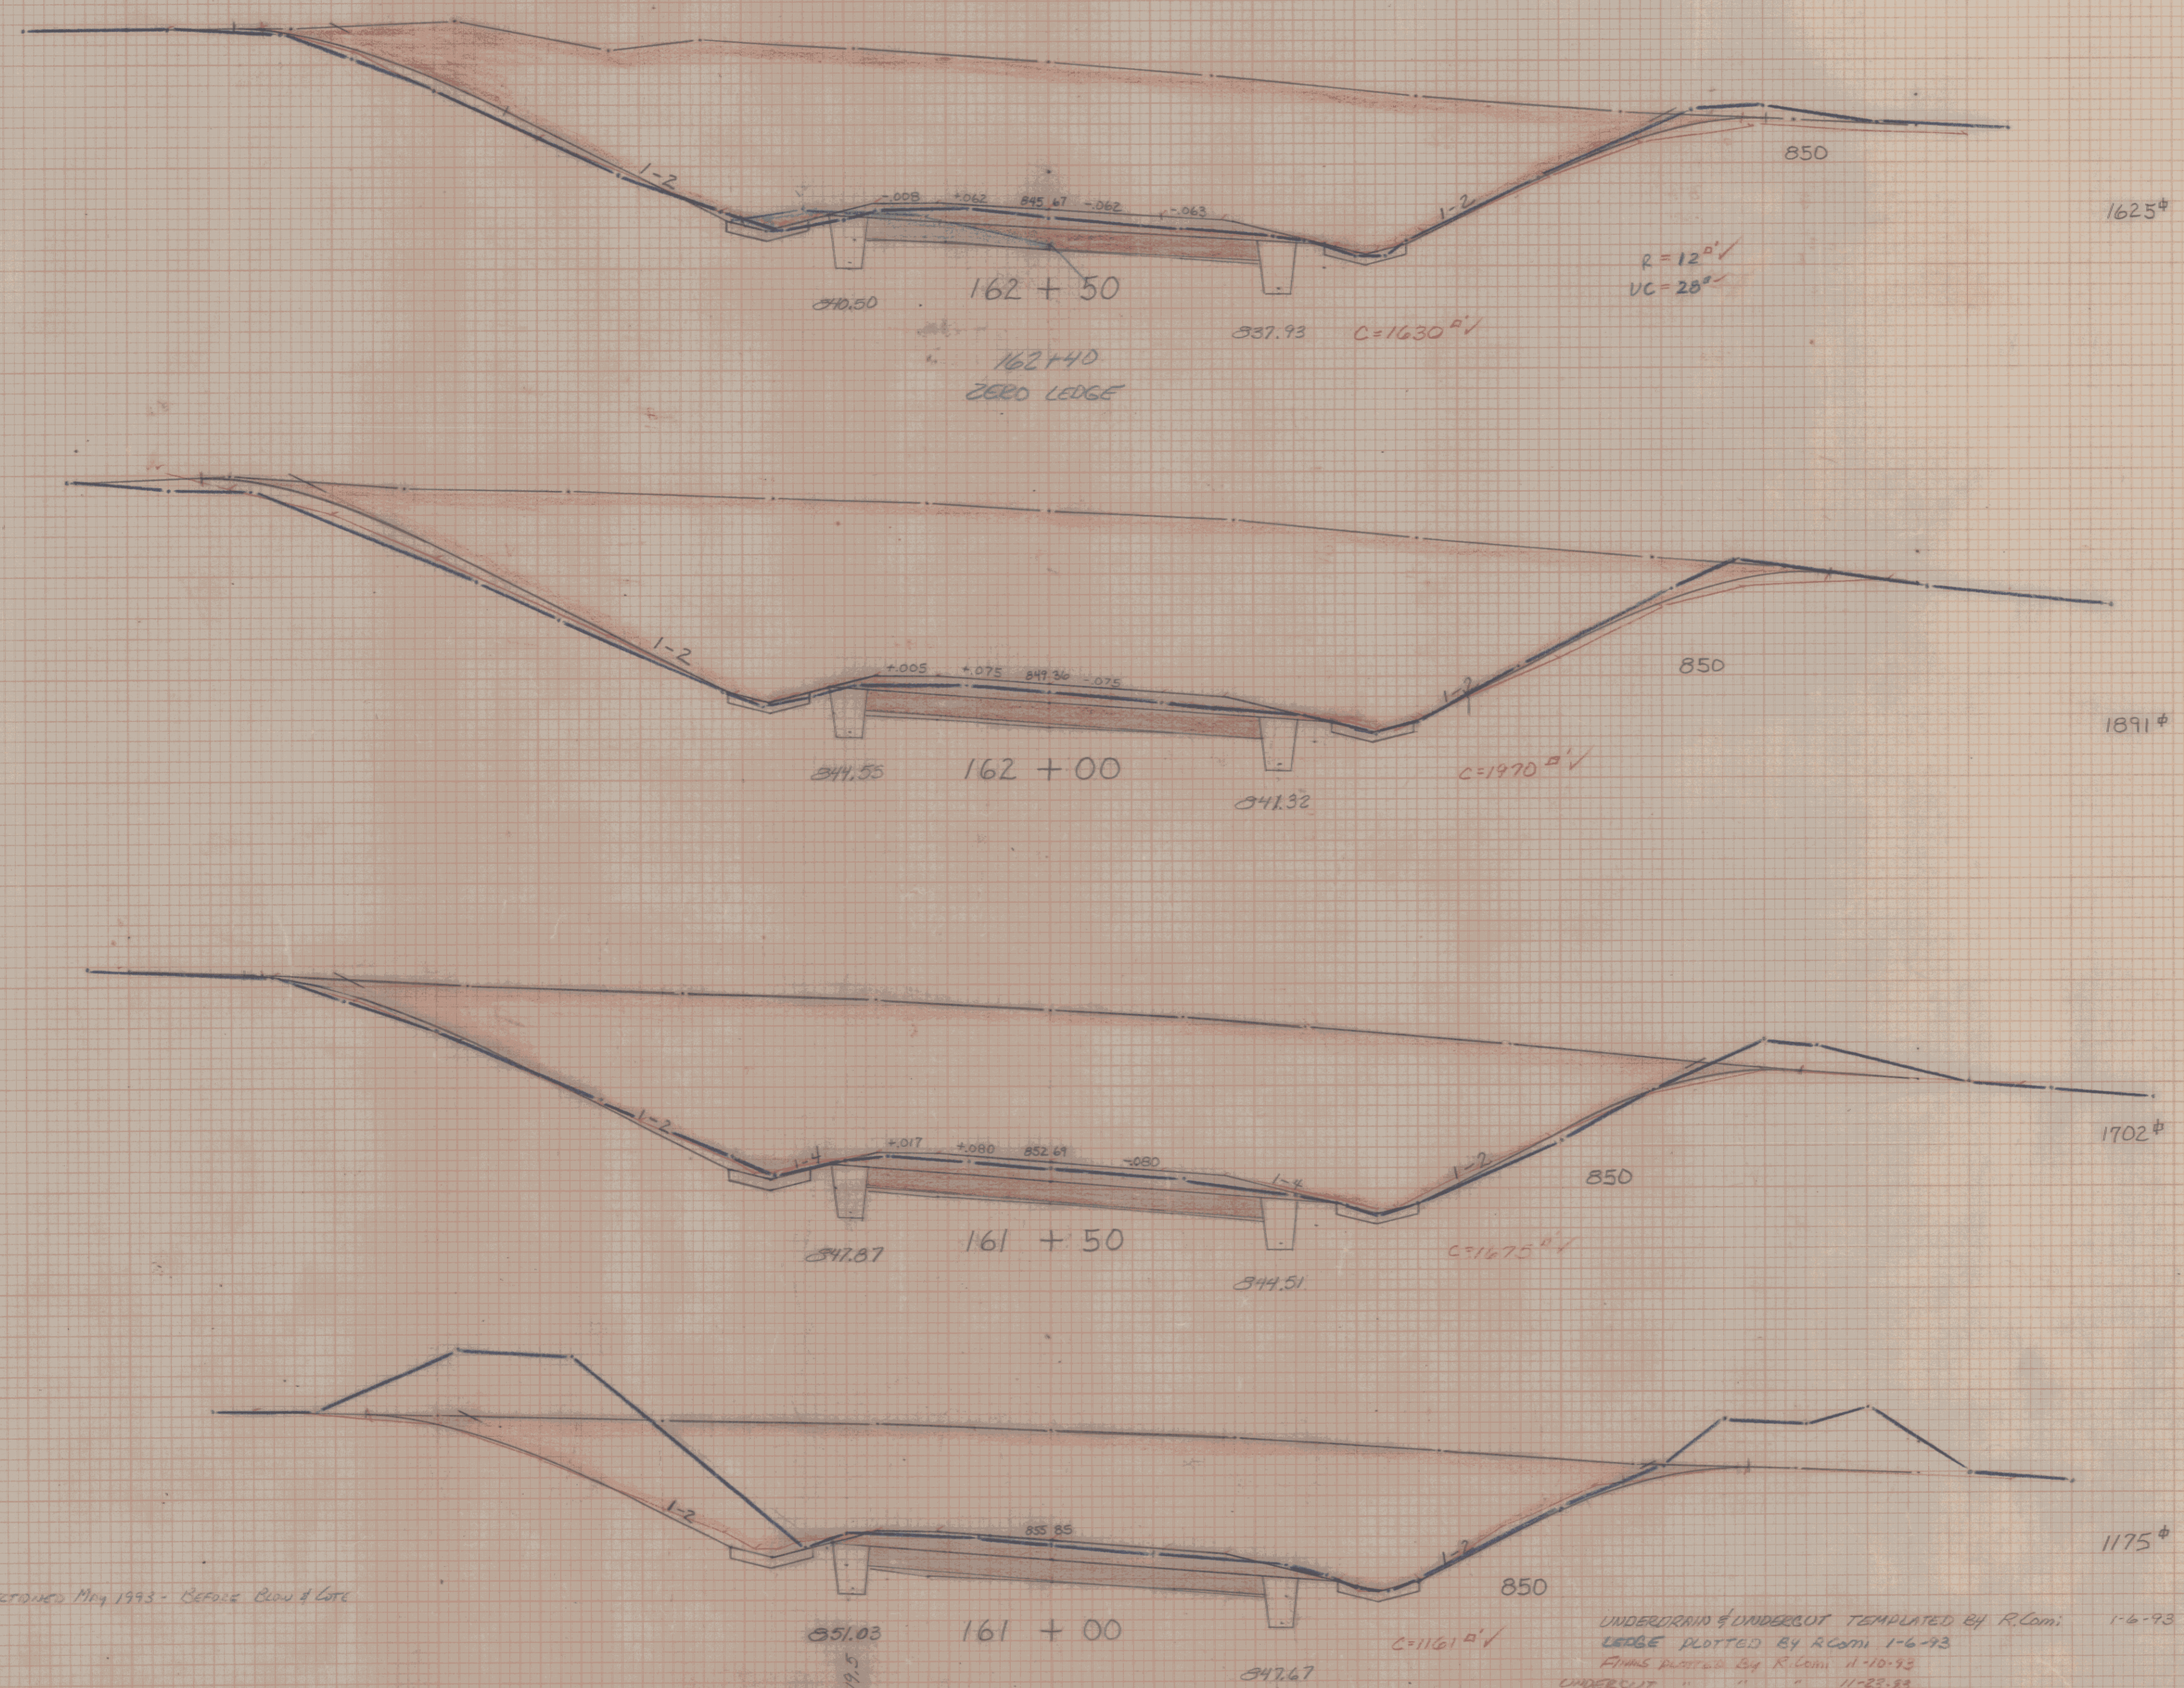

Base Plan by W. Sawyer - Sections May 1993 - Before Road & Gate

REV. SECTIONS
 STA 161+00 ~ 162+50
 EAST MONTPELIER
 RSEGC RS 0246(1)
 SHEET 9A OF 17A

Kearney & Esser Company

PLATE & CROSS SECTION 487056 MADE IN U.S.A.

UNDERCUT & UNDERCUT TEMPLATED BY R.Com. 1-6-93
 LERGE PLOTTED BY R.Com. 1-6-93
 FINISH PLOTTED BY R.Com. 1-10-93
 UNDERCUT " " 11-23-93
 PLAN " " 11-23-93
 C.D. PLAN BY C.E. 1994 2-1-94
 1-DWG. LIPG BY C.E. 1994 2-1-94

155+5