


FINAL SURVEY
 SURVEYED
 PLANNED
 AREAS
 CHECKED

DATE
 BY
 SURVEYED
 PLANNED
 AREAS
 CHECKED

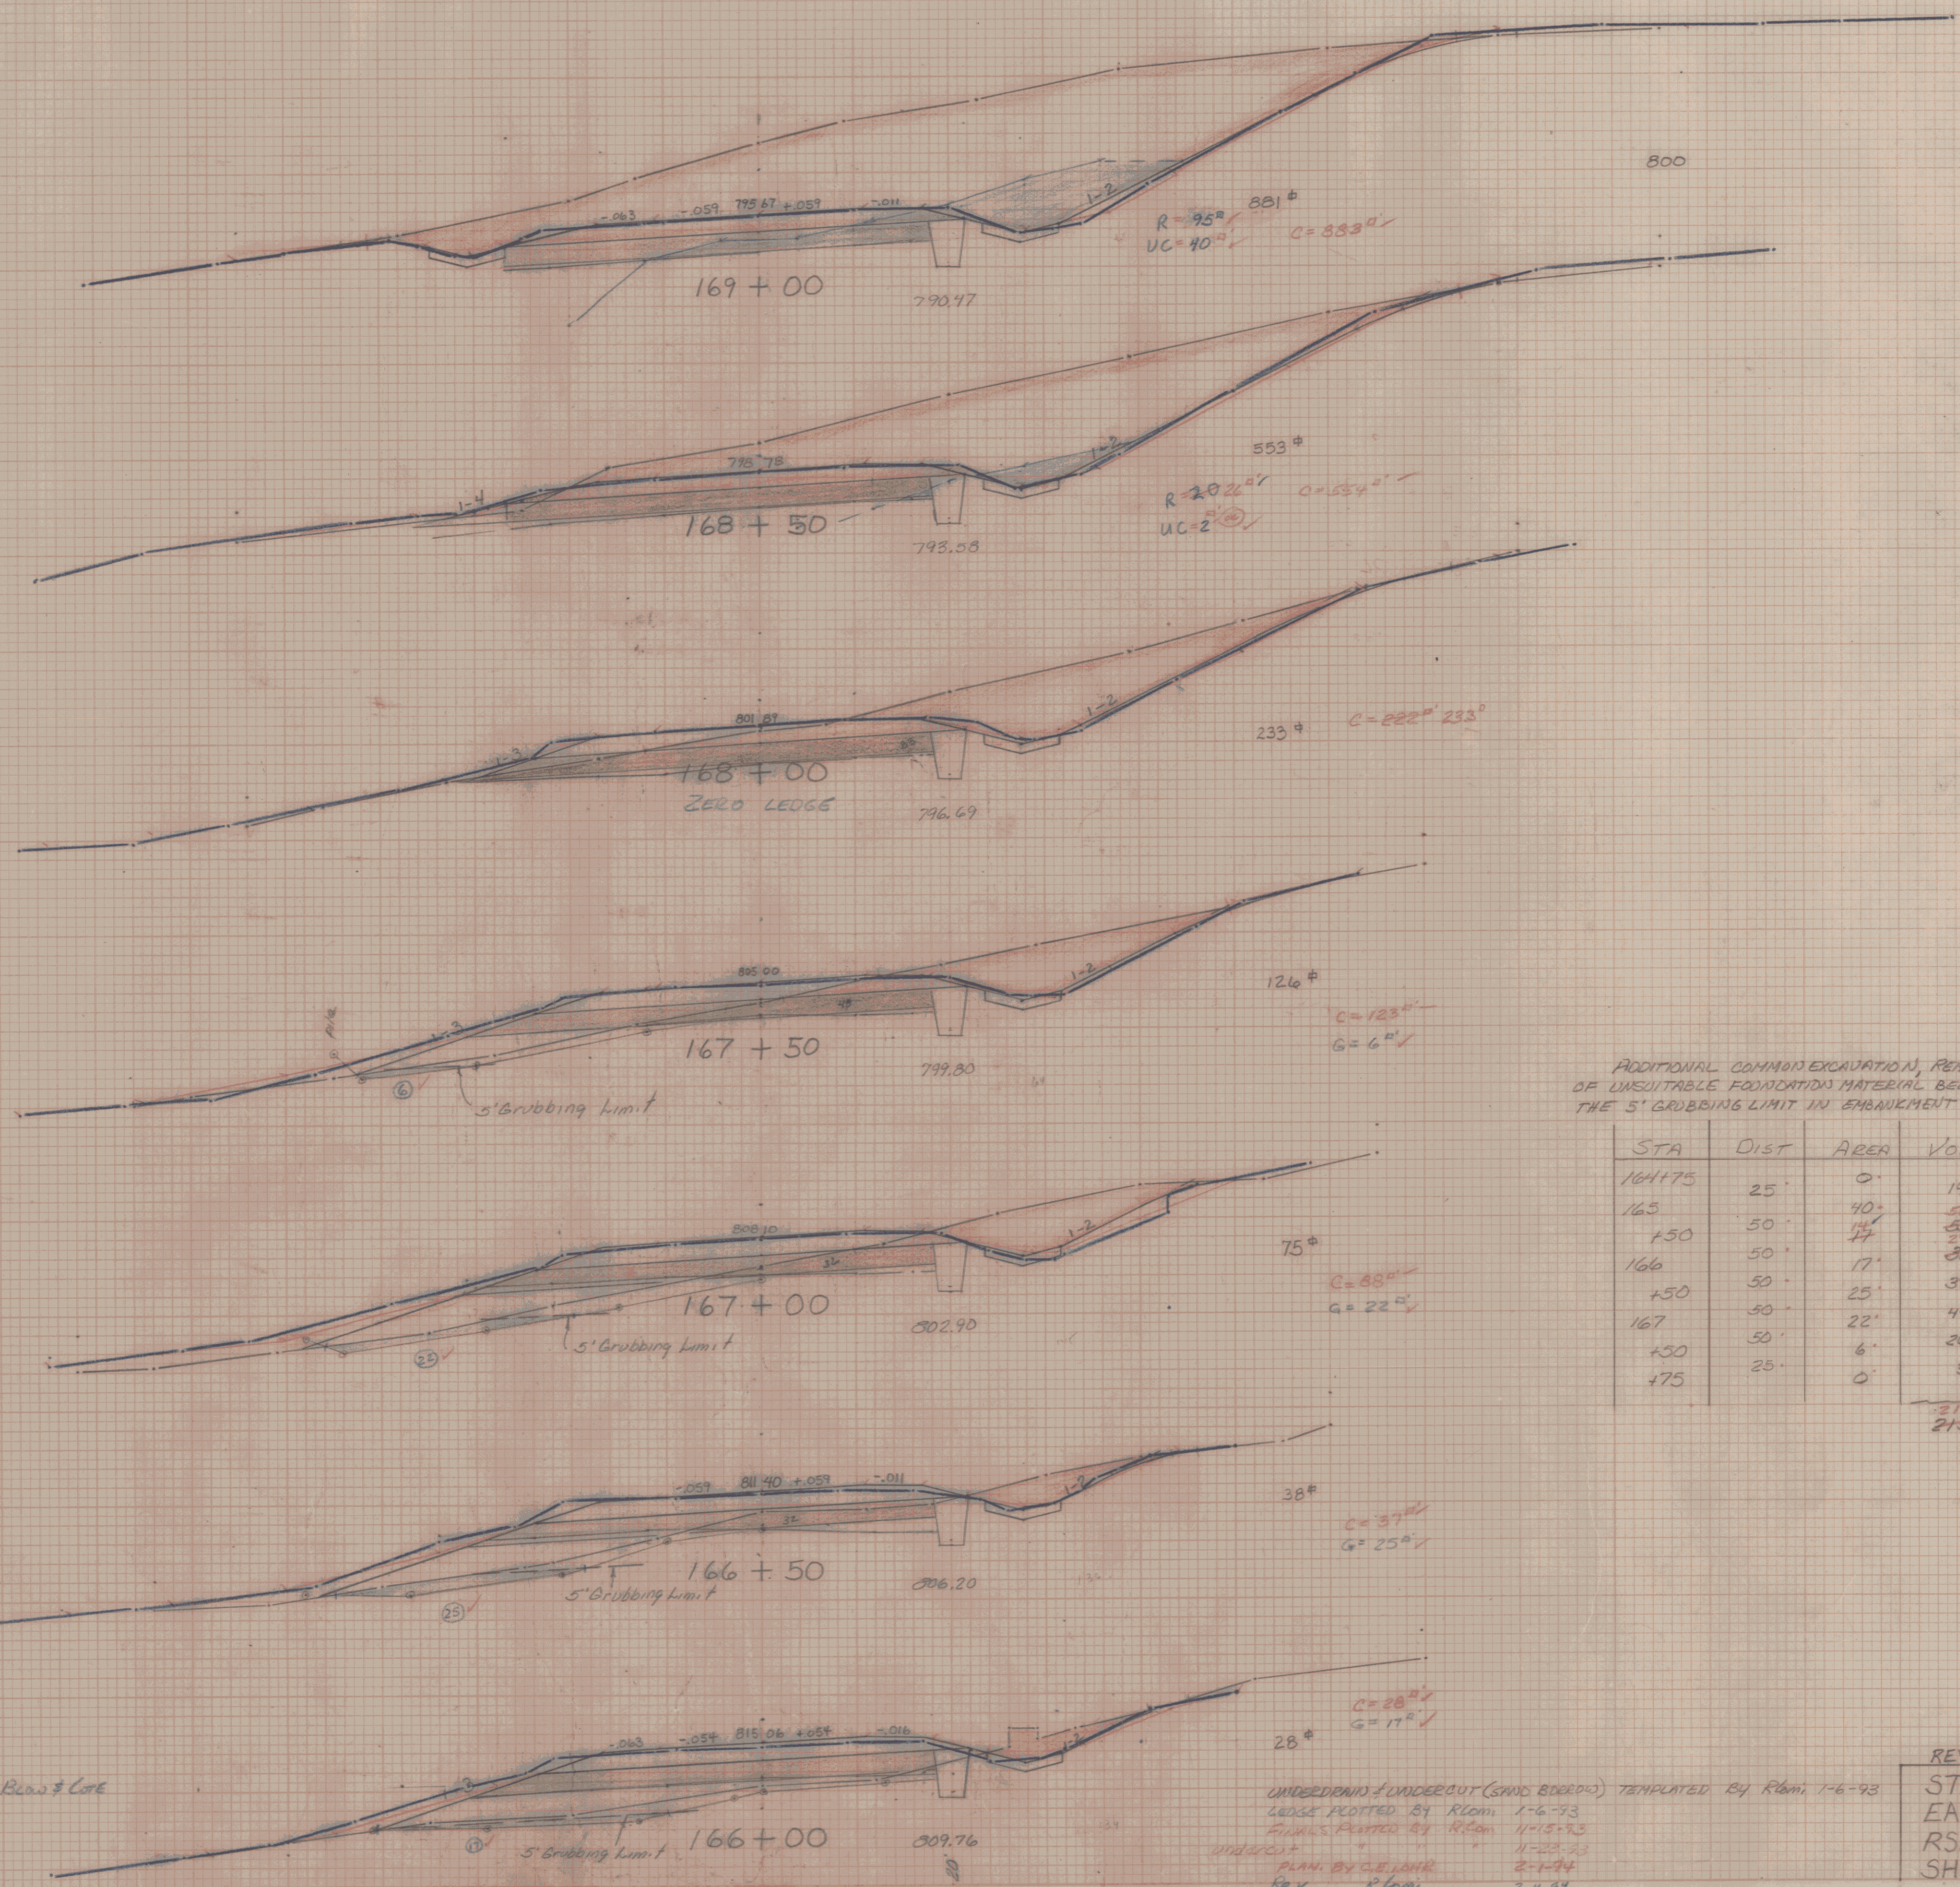

ADDITIONAL COMMON EXCAVATION, REMOVAL OF UNSUITABLE FOUNDATION MATERIAL BELOW THE 5' GRUBBING LIMIT IN EMBANKMENT AREA

STA	DIST	AREA	VOL
164+75	25'	0'	19'
165	40'	50'	50'
150	50'	17'	31'
166	50'	17'	39'
150	50'	25'	44'
167	50'	22'	36'
150	25'	6'	3'
175	25'	0'	3'

216'
 215' c/v
 R.L. 1-20-94
 c/v. 2-1-94
 R.L. 2-4-94

OKD GRUBBING BY C.E. LHR 2-1-94 (SCALED)
 OKD LEDGE BY C.E. LHR 2-1-94

BLUE PLOTTED BY VA SURVEY - SECTIONED MAY 1993 - BEFORE BLEND & CORE

UNDERBENT UNDERCUT (SHAD BERRIDG) TEMPORARY BY R.L. 1-6-93
 LEDGE PLOTTED BY R.L. 1-6-93
 PLANS PLOTTED BY R.L. 11-15-93
 UNDERCUT
 PLAN BY C.E. LHR 2-1-94
 Rev R.L. 2-4-94

REV. SECTIONS
 STA 166+00 ~ 169+00
 EAST MONTPELIER
 RSEGC RS 0246
 SHEET 11A OF 17A