


DATE	
BY	
REVISIONS	
NO.	
DESCRIPTION	
DATE	
BY	
REVISIONS	
NO.	
DESCRIPTION	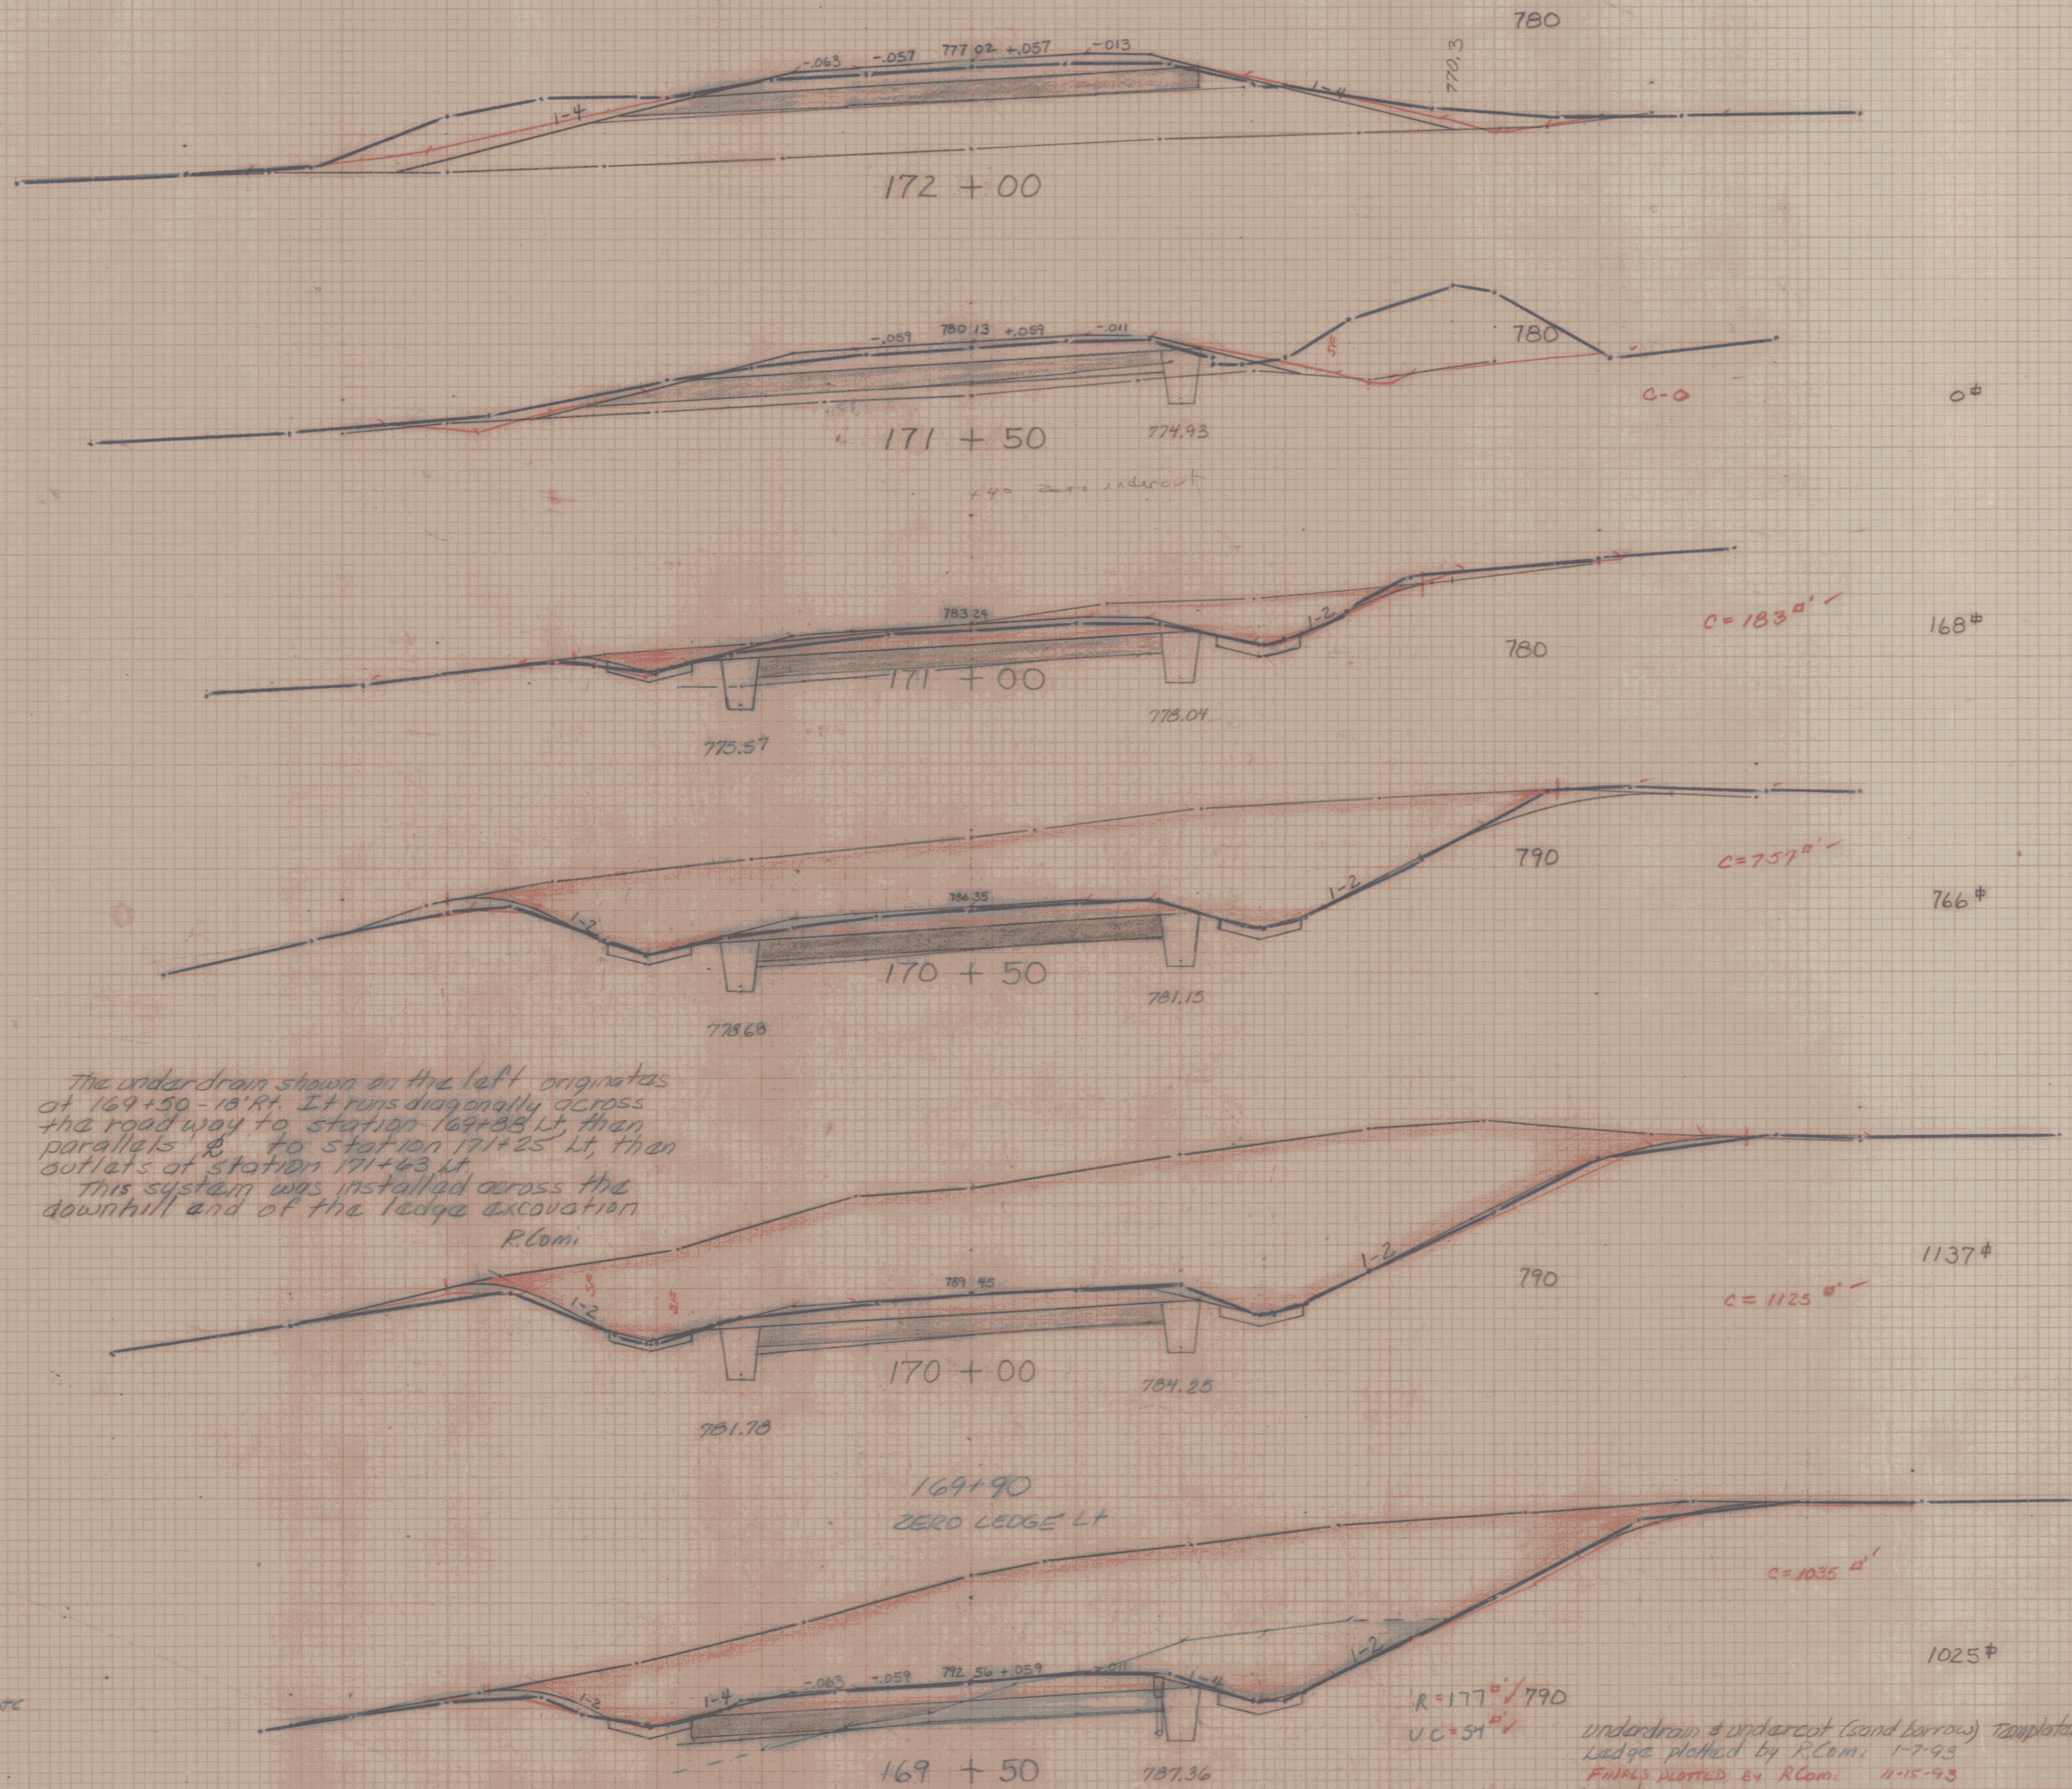
REVIC PLOTTED by W. SPREYER - SECTIONS May 1993 - BEFORE BEANS & COLE

Underdrain & Undercut (Sand Parrow) templated by R.Lom. 1-7-93
 Ledge plotted by R.Lom. 1-7-93
 FINALS PLOTTED BY R.Lom. 11-15-93
 UNDERCUT & SAND 11-23-93
 PLAN BY G.E. LOHR 2-2-94
 CADD CHECK BY G.E. LOHR 2-2-94
 PLAN BY R.Lom. 2-4-94

REV. SECTIONS
 STA 169 + 50 ~ 172 + 00
 EAST MONTPELIER
 RSEGC RSO246(1)
 SHEET 12A OF 17A