


DATE
 BY
 CHECKED
 APPROVED
 FINAL
 REVIEWED

DATE
 BY
 CHECKED
 APPROVED
 FINAL
 REVIEWED

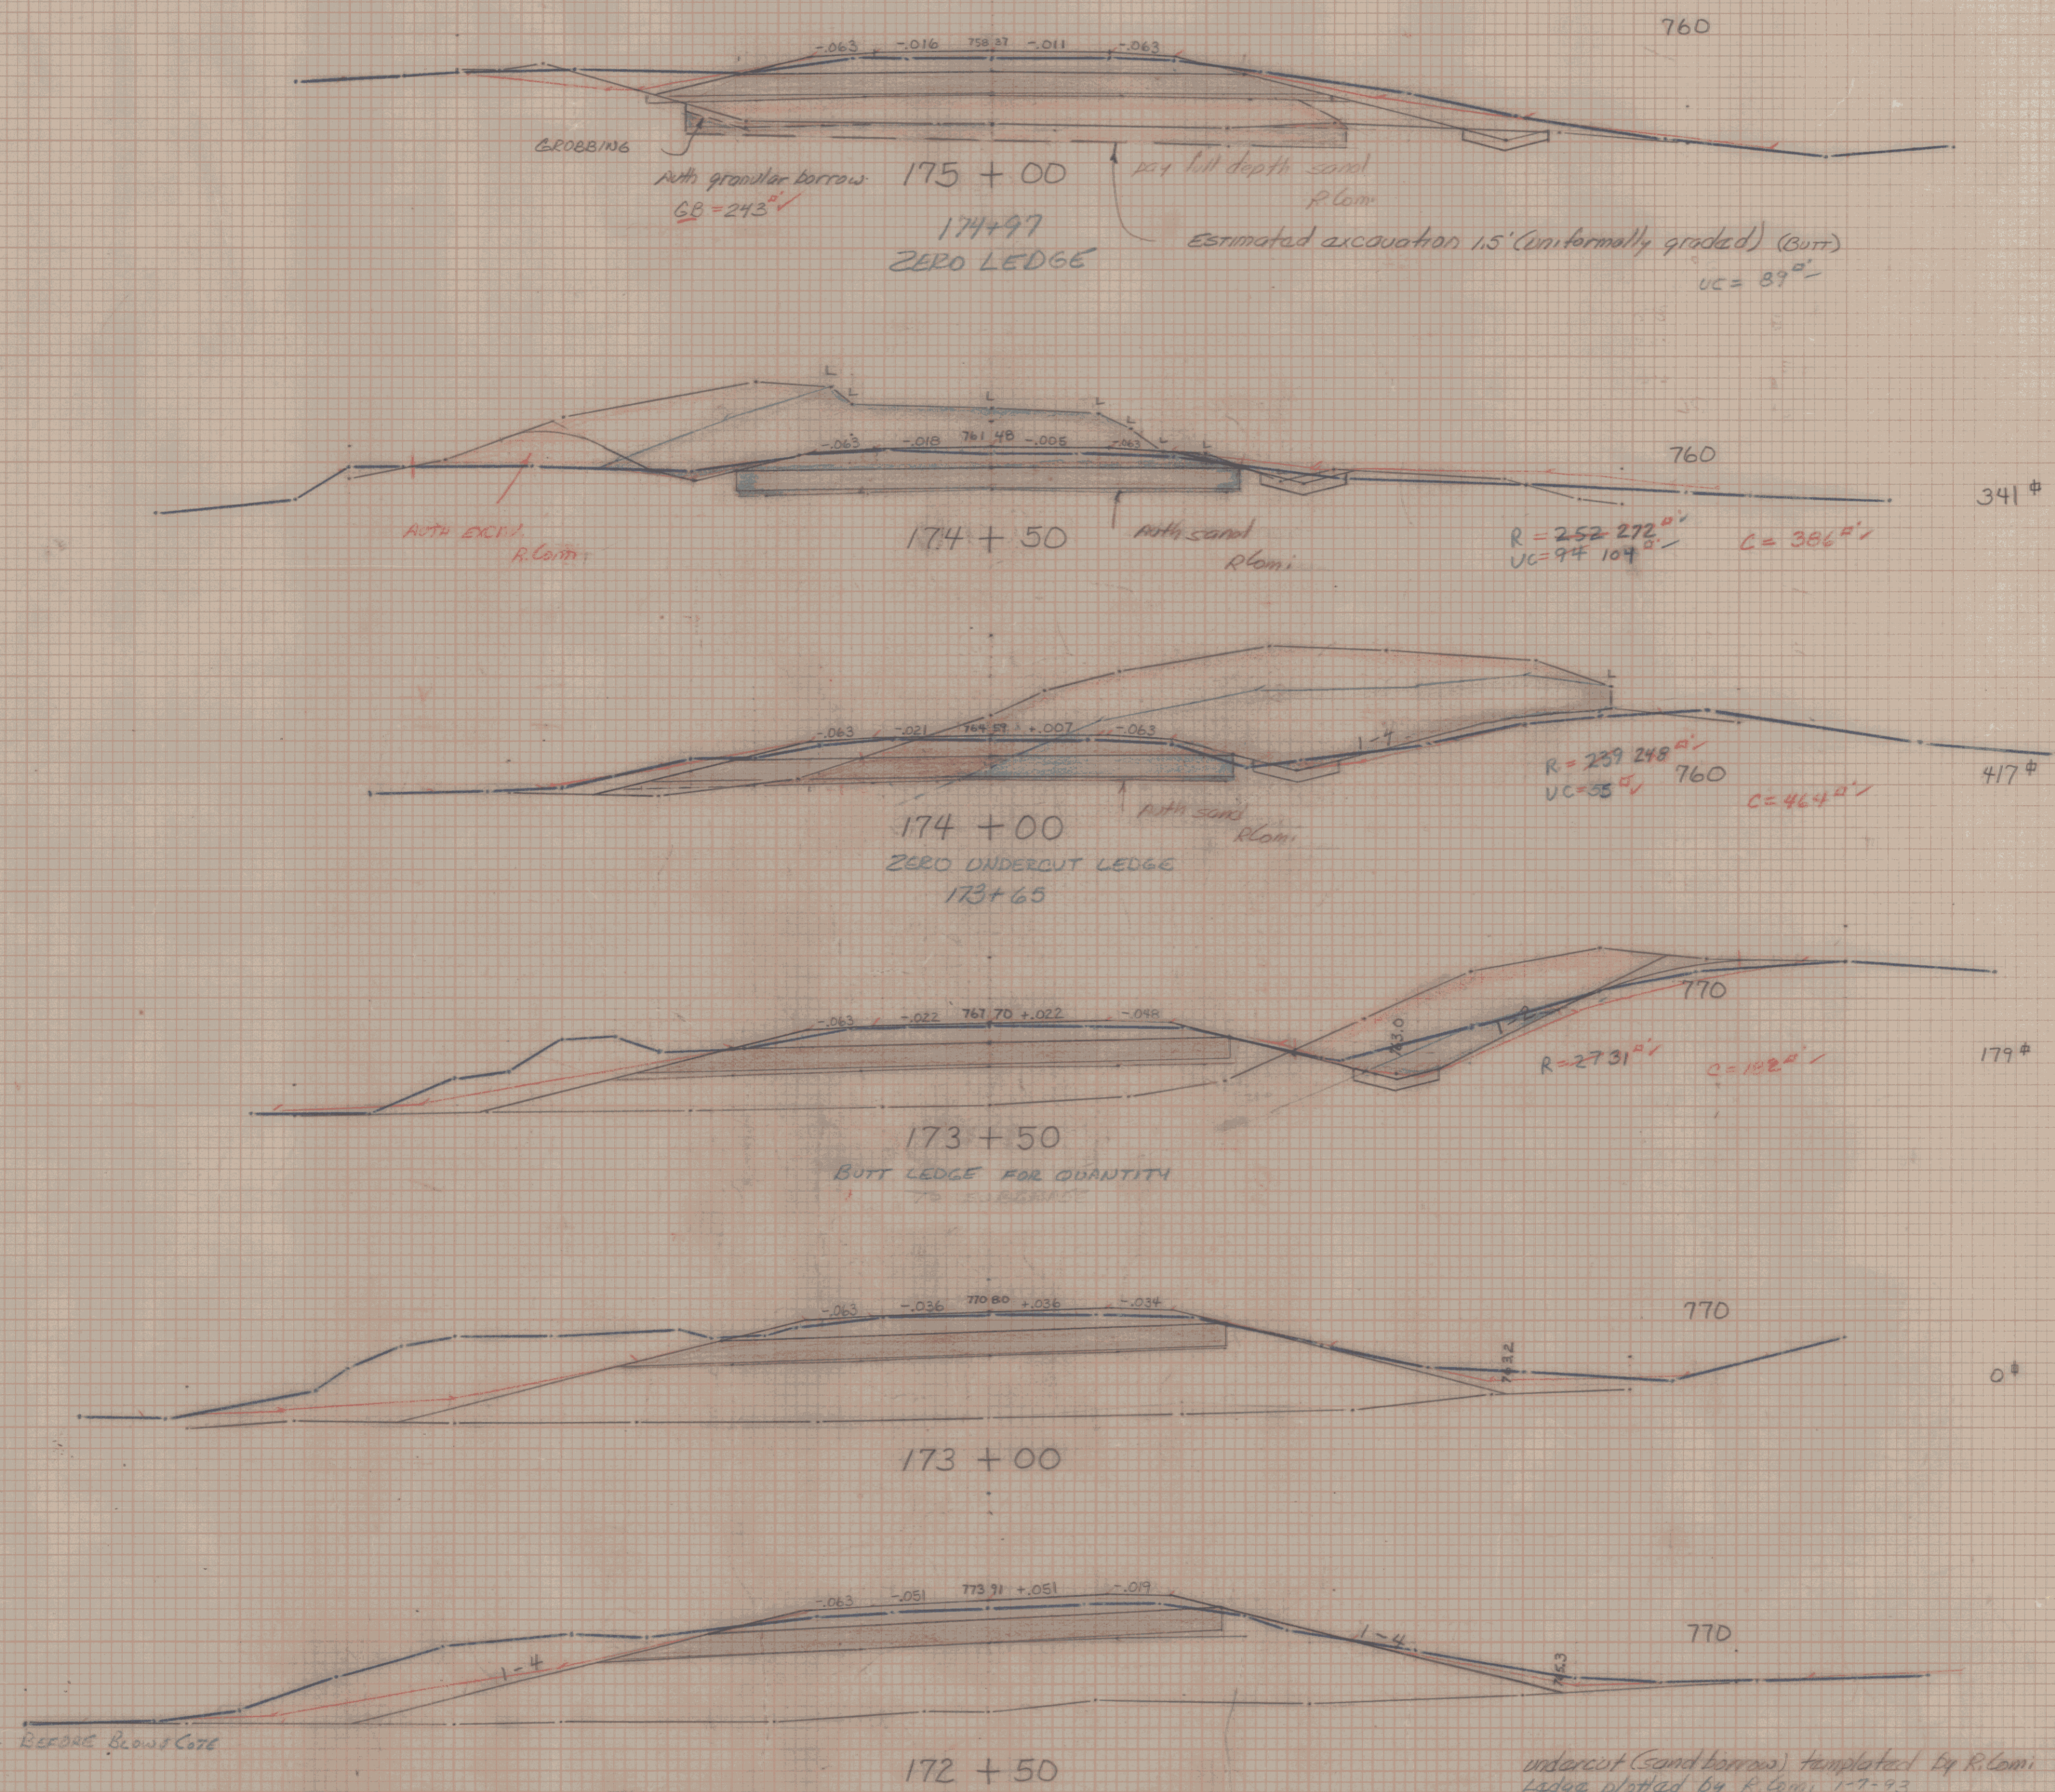

BLUE PLOTTER BY VLSURLEY - SECTIONS MAY 1993 - BEFORE BLOWN COTE

undercut (sand borrow) templated by R.Loni 1-7-93
 ledge plotted by R.Loni 1-7-93
 finish plotted by R.Loni 11-18-93
 PLAN BY C.E. LONG 2-2-94
 OLD LEDGE BY C.E. LONG 2-2-94
 VC PLAN BY C.E. LONG 2-2-94
 G/L R.Loni 2-4-94
 G.B. C.D. G.E. LONG 2-16-94

REV. SECTIONS
 STA 172+50~175+00
 EAST MONTPELIER
 RSEGC R30246 (1)
 SHEET 13A OF 17A

Kentel & Egan Company

PLATE CROSS SECTION 407056