


DATE: 12-23-77
 BY: JAC
 CHECKED: JAC

DATE: 12-23-77
 BY: JAC
 CHECKED: JAC

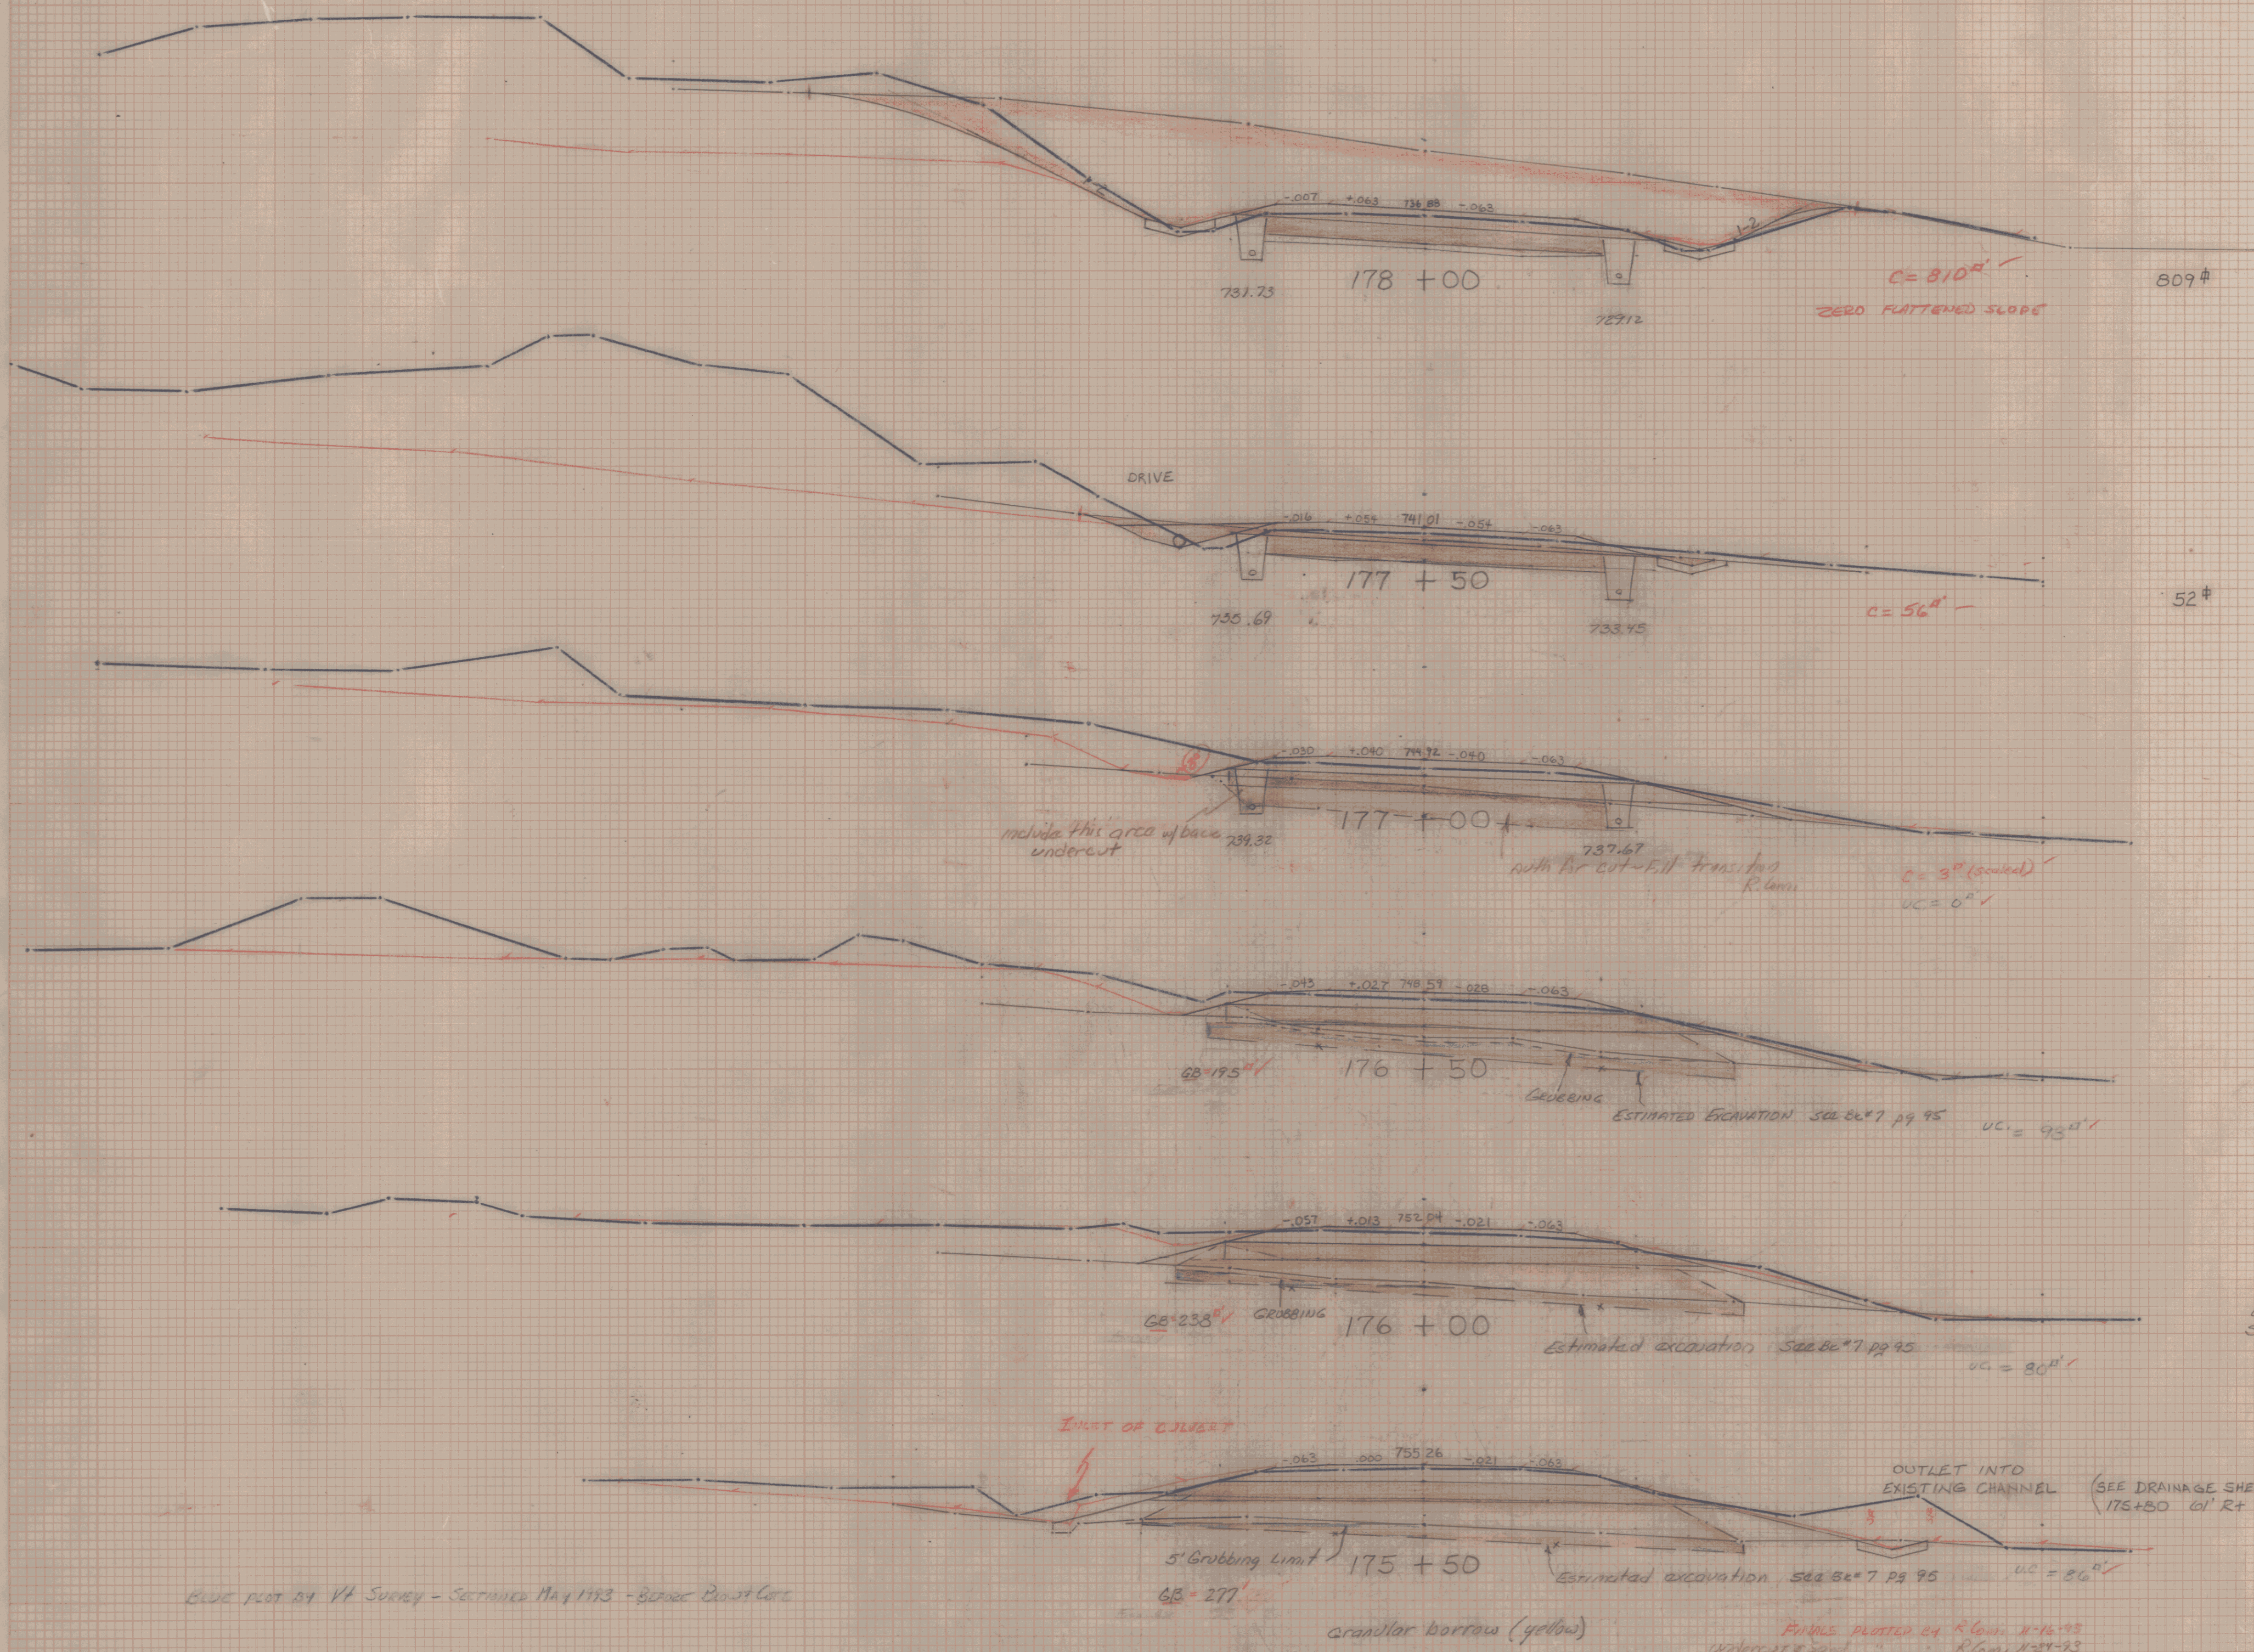

Authorized in place BRANDINE BORROW
 from 177+50 - 177+0

STA	DIST	AREA	VOL	EXCAVATION AREA	VOL
175	50	0	225	0	82
175	50	243	481	89	162
176	50	277	477	80	154
176	50	238	408	98	165
177	50	195	131	0	91
			1744 cu	657 cu	
			1765	R.L. Comi 4-12-74	
			x 1.15	2029 cu	
			2030	R.L. Comi 4-31-74	
			2031	R.L. Comi 4-12-74	
			1749 cu	R.L. Comi 4-12-74	

sand borrow base fill around
 culvert at station 175+50
 see drainage sheet #2 & B.C. 2 pg 176 (CHH-115) - 281

REV. SECTIONS
 STA 175+50 ~ 178+00
 EAST MONTPELIER
 RSEGC RS 0246(1)
 SHEET 14A OF 17A

BLUE PLAN BY VA SURVEY - SECTIONED MAY 1993 - BRIDGE B.O. ST. CLOS.

POINTS PLANTED BY R. Comi 11-16-73
 UNDERCUT & SAND R. Comi 11-29-73
 OR PLAN U.C. BY C.E. LOHR 2-2-74
 PLAN C. BY E. LOHR 2-2-74
 G.B. C.K.D. C.E. LOHR 2-16-74