

FINAL SURVEY NOTE BOOK No. \_\_\_\_\_

DATE \_\_\_\_\_

BY \_\_\_\_\_

NO. \_\_\_\_\_

PLotted \_\_\_\_\_

AREA CHECKED \_\_\_\_\_

ORIGINAL SURVEY NOTE BOOK No. \_\_\_\_\_


DATE 11-27-92

BY RSC, JAC, JAC, JAC

SURVEYED \_\_\_\_\_

PLotted \_\_\_\_\_

AREA CHECKED \_\_\_\_\_

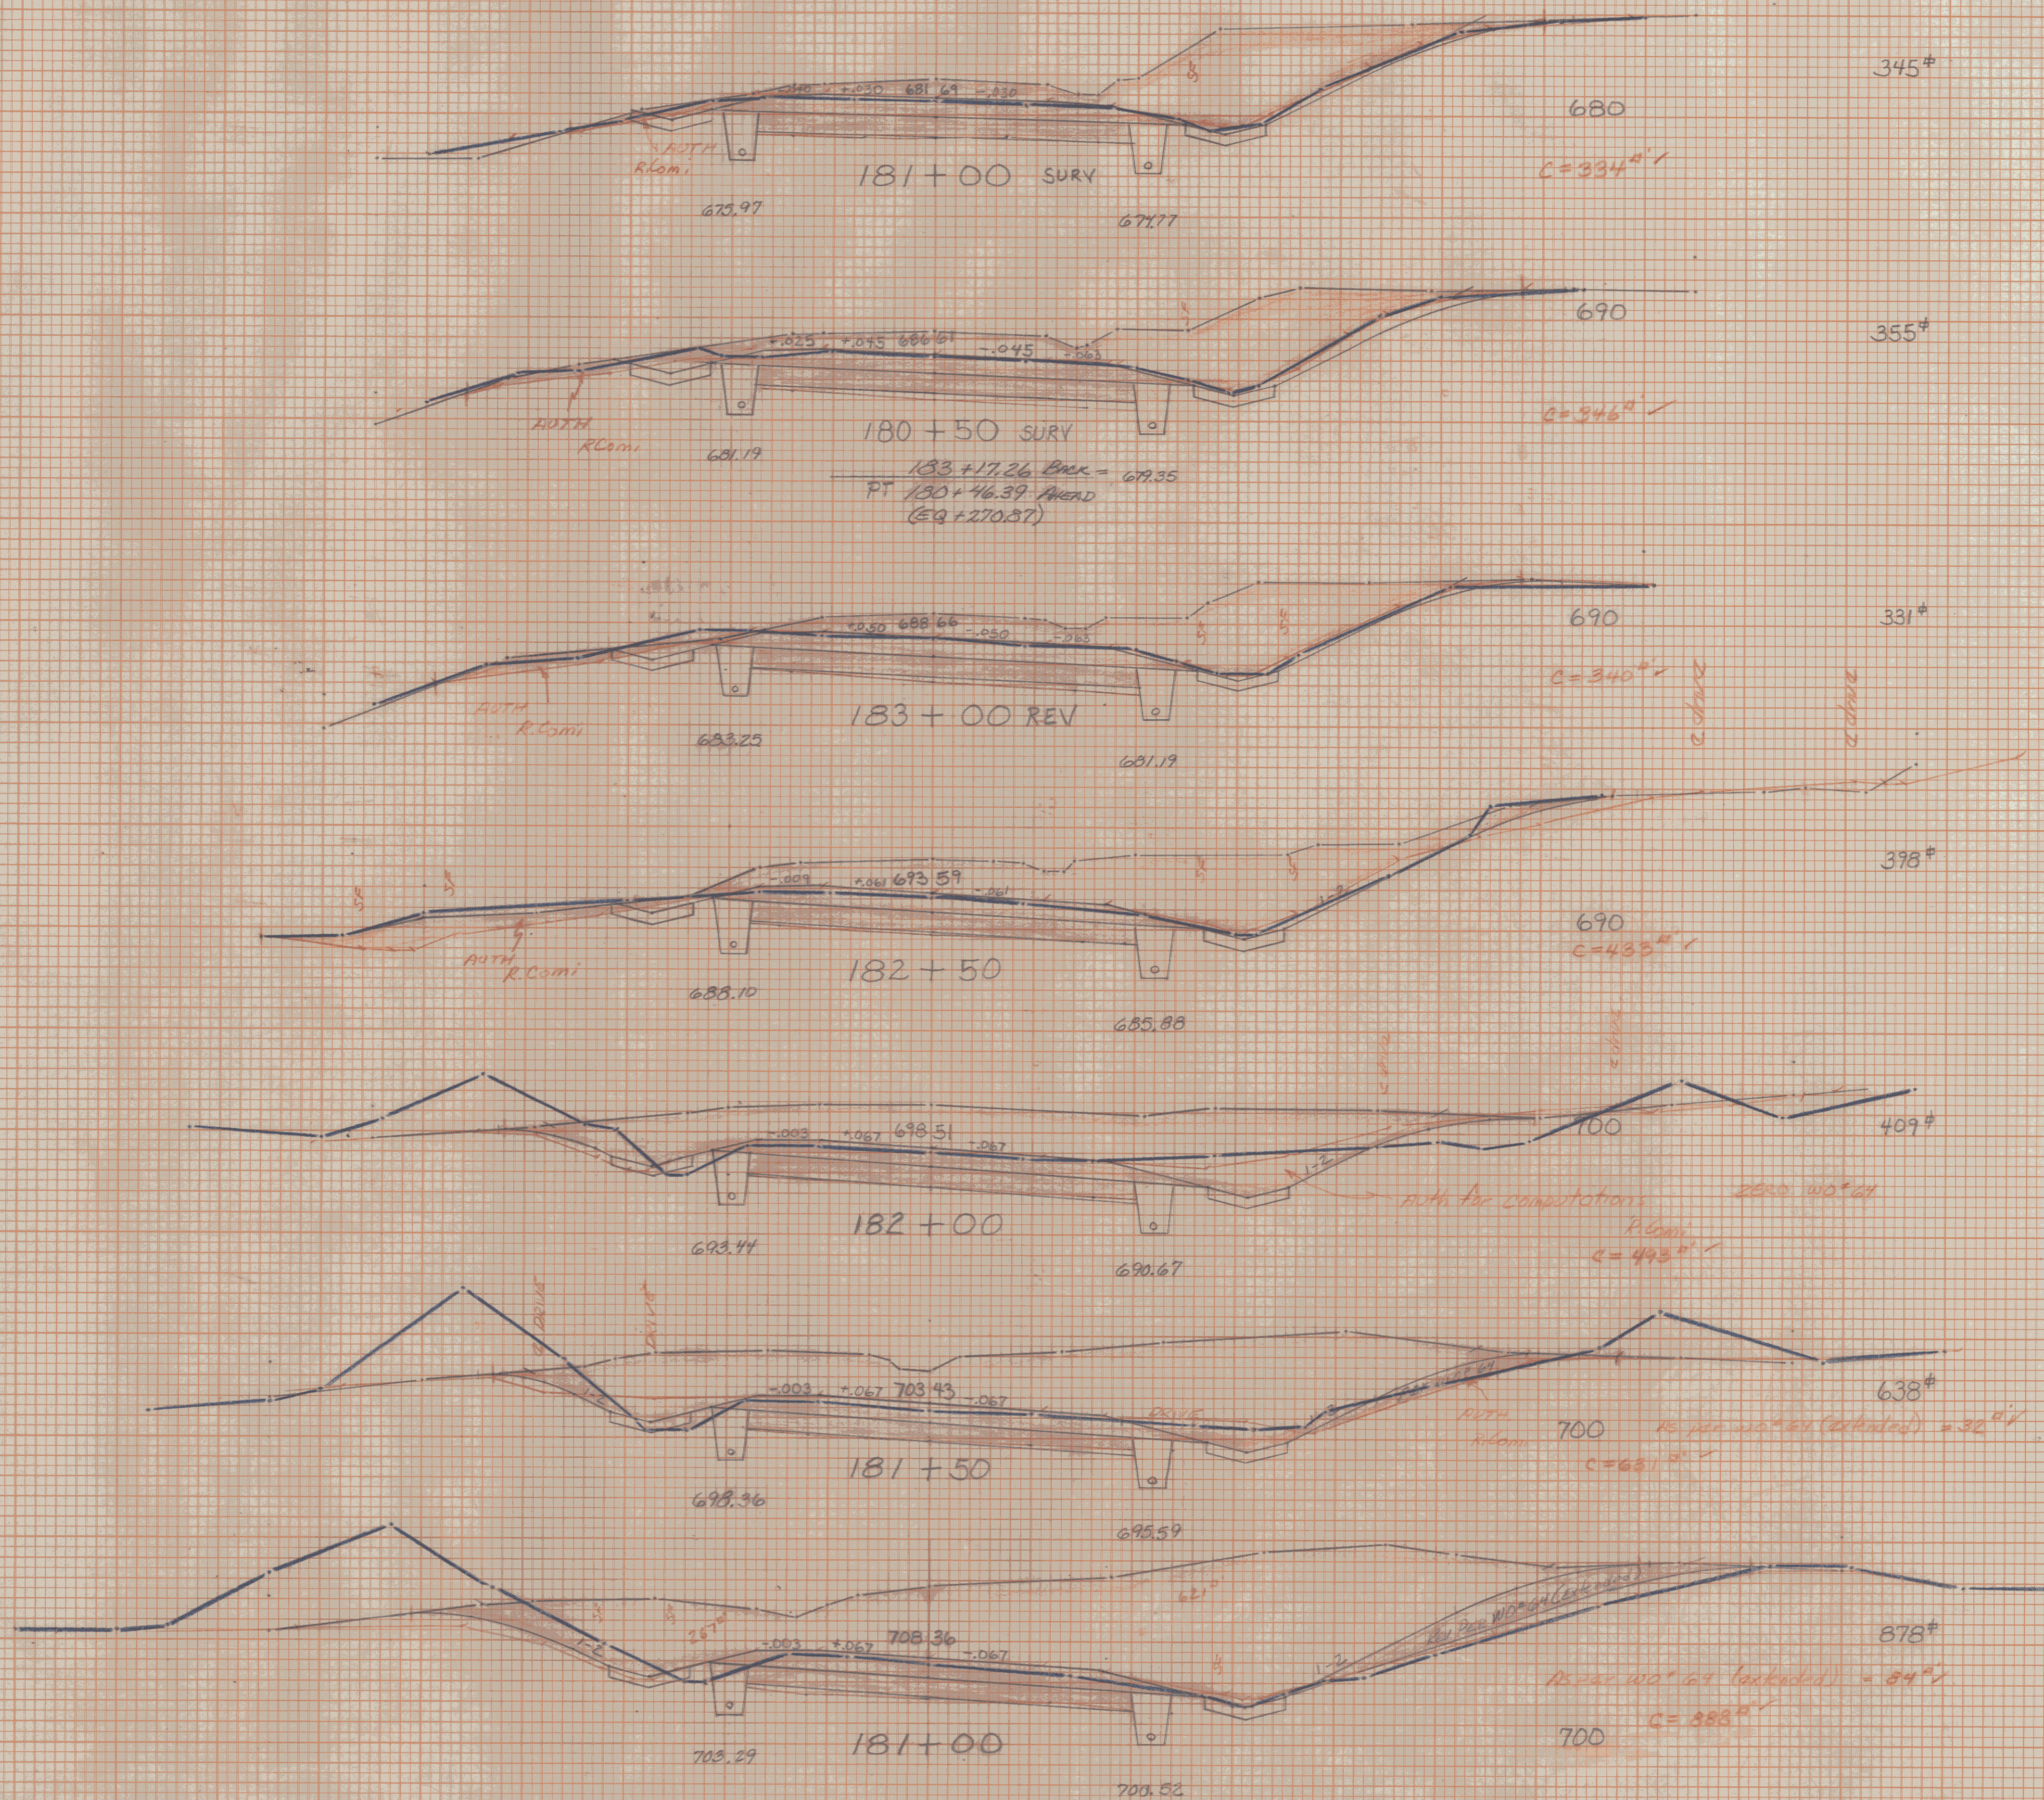

Printed by H. S. Sibley - September, 1992 - Boston, MA

PLANS DRAWN BY R.COM 11-17-92  
 UNDERST. TYPED BY R.COM 12-7-92  
 UNDERST. DRAWN BY R.COM 12-7-92  
 C. PLAN BY C. J. LEHR 12-3-92  
 W.D. C.D. BY C. J. LEHR 12-3-92  
 R.COM 12-7-92

REV. SECTIONS  
 STA 181+00REV ~ 181+00 SURV  
 EAST MONTPELIER  
 RSEGC RS 0246 (1)  
 SHEET 16A OF 17A