

THIS SHEET TO BE USED  
FOR ROW. INFORMATION ONLY

CONSTRUCT SIDEWALK RAMP  
LEFT  
64+48 (TYPE 6)

VERTICAL GRANITE CURB


LEFT		RIGHT	
62+04	62+44	62+00	62+11
REV 62+57	64+16	REV 62+31	63+33
REV 64+35	REV 64+45	REV 63+45	REV 63+66
REV 64+50	REV 64+57	REV 63+86	REV 64+92
REV 64+82	REV 66+29	REV 65+04	REV 66+38
REV 66+47	REV 67+55	REV 66+84	REV 67+60

CONSTRUCT DRIVES

LEFT	RIGHT
62+00 12' WIDE (PAVED)	62+19 20' WIDE (PAVED)
REV 62+50 10' WIDE (PAVED)	REV 63+39 12' WIDE (GRAVEL)
REV 64+27 16' WIDE (PAVED)	REV 63+80 16' WIDE (GRAVEL)
REV 66+37 16' WIDE (GRAVEL)	REV 65+00 24' WIDE (PAVED)
REV 67+70 32' WIDE (GRAVEL)	REV 66+60 24' WIDE (PAVED)

CONSTRUCT APPROACH  
REV 64+80.85 LT SHERWOOD DR. 28' WIDE (PAVED)

CONSTRUCT WALK (PAVED)  
LEFT  
REV 63+90 (3' WIDE)

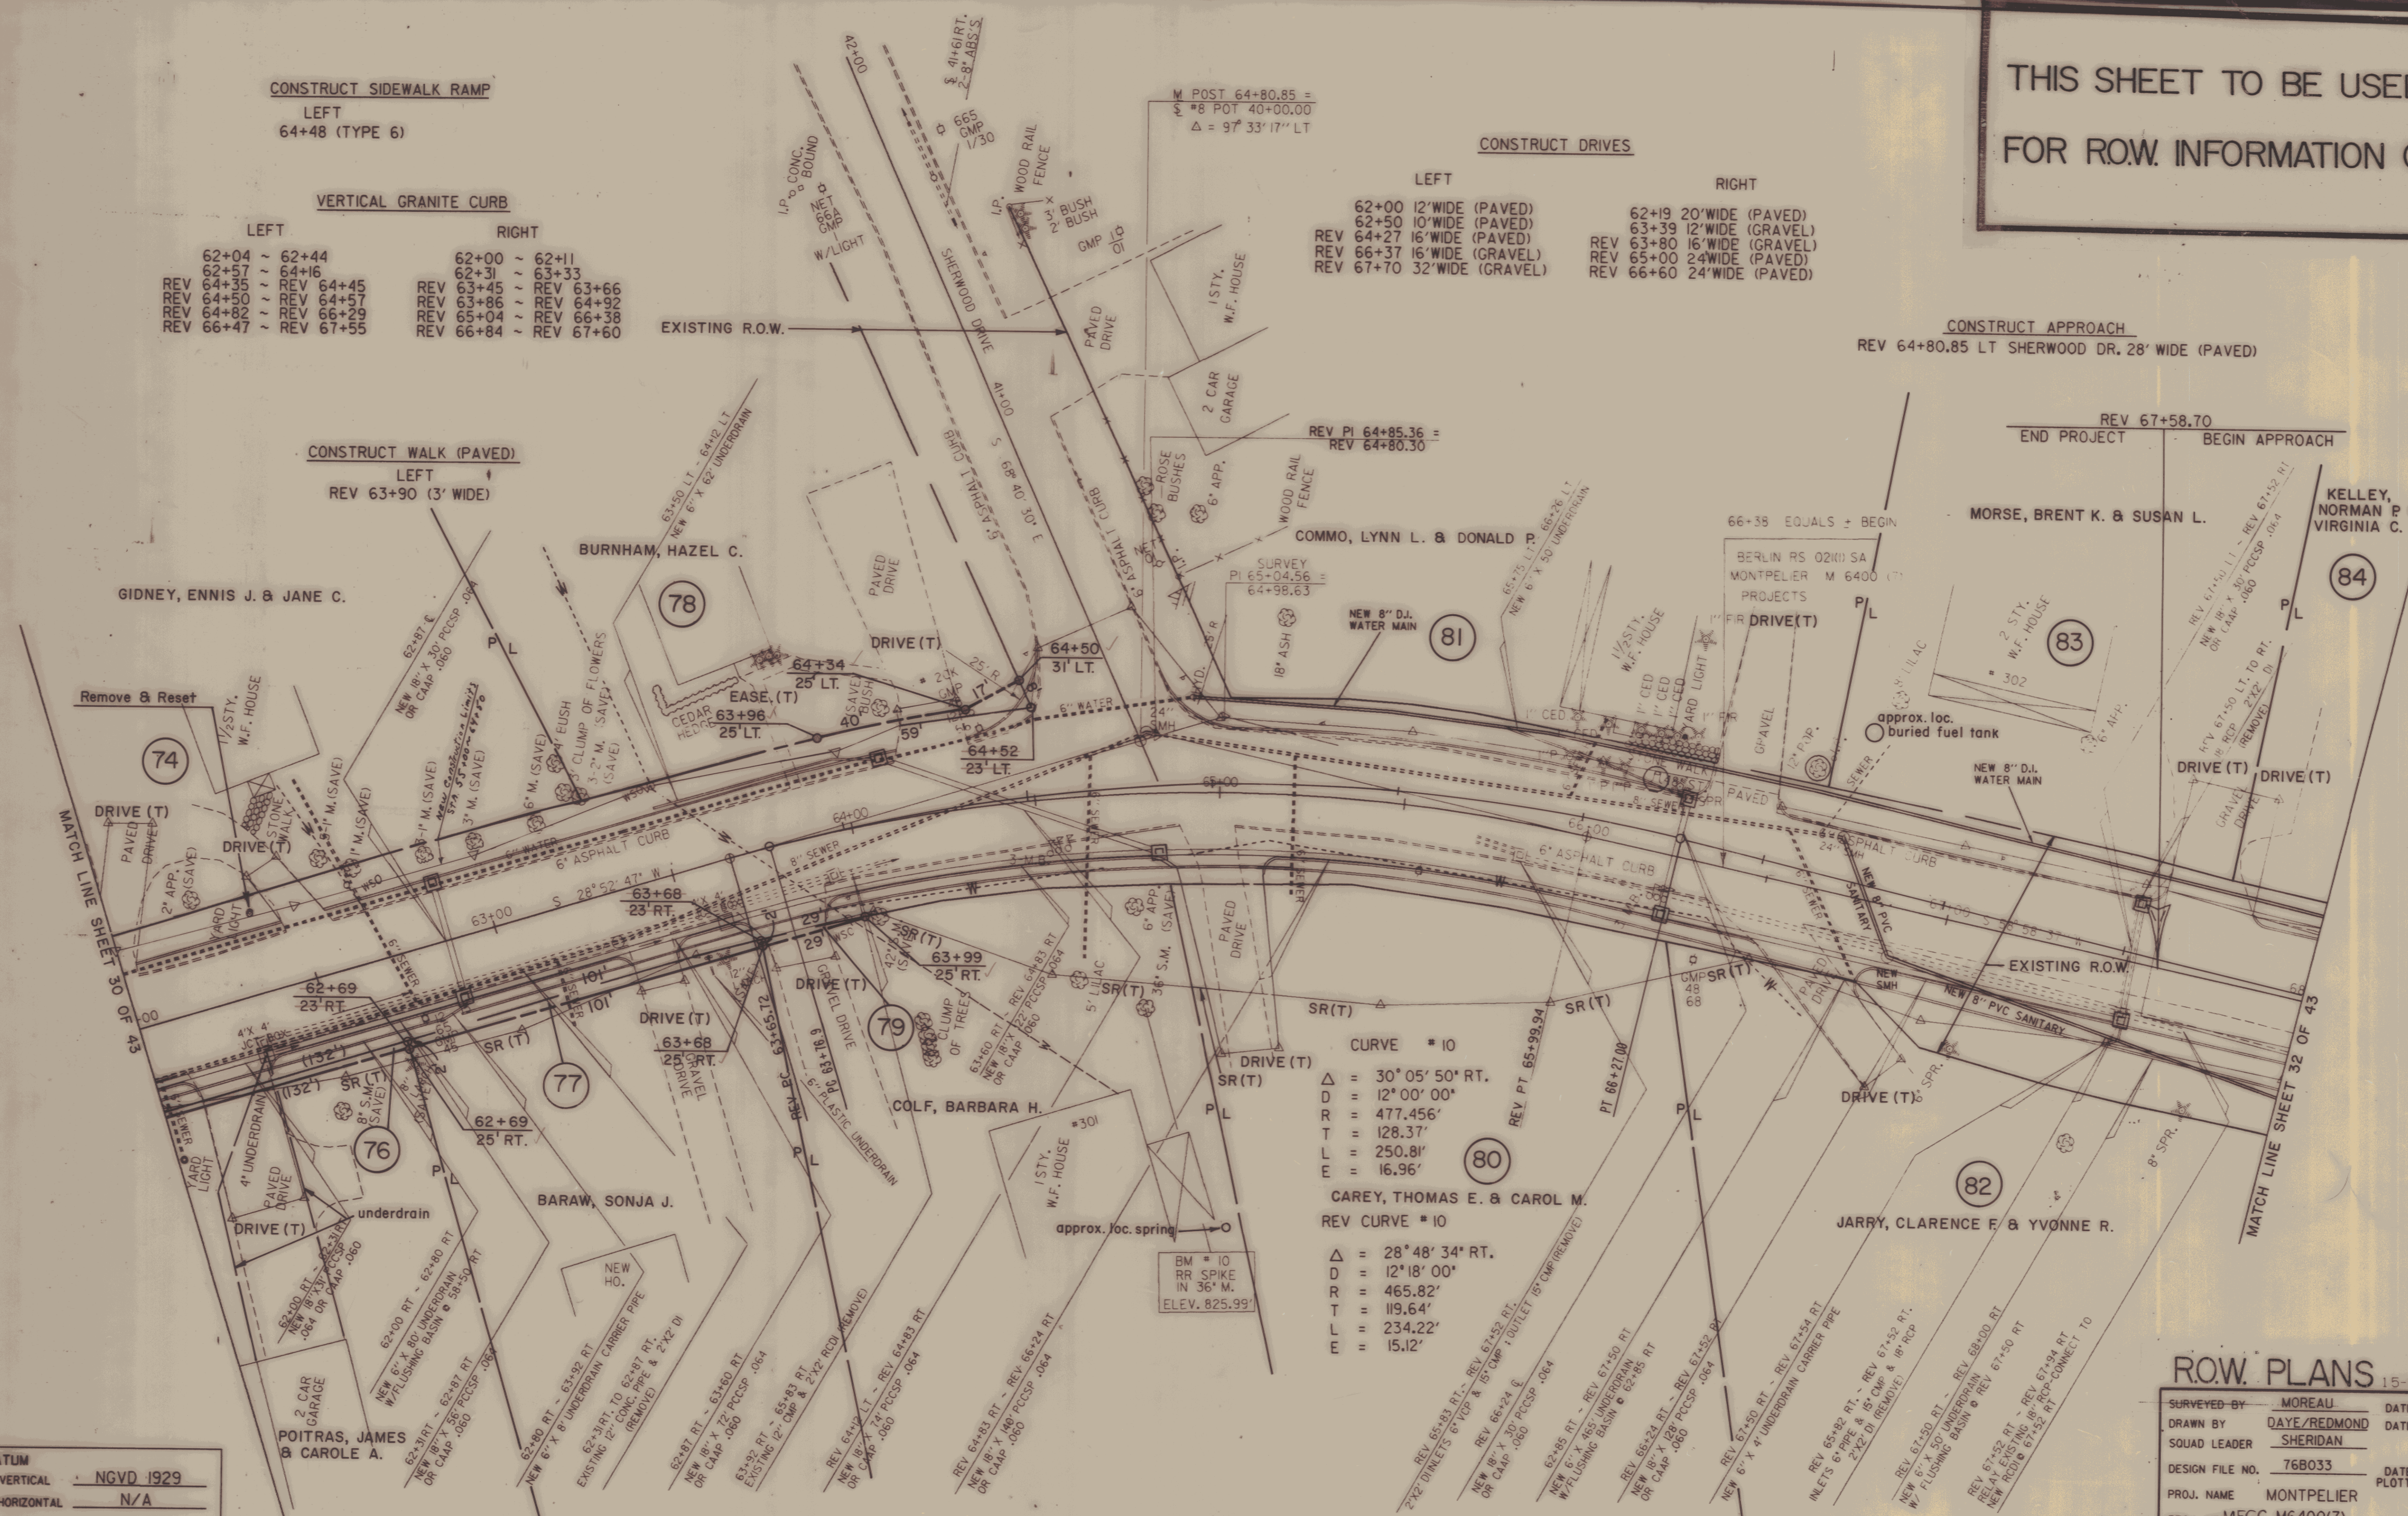

CURVE #10  
 $\Delta = 30^{\circ} 05' 50''$  RT.  
 $D = 12^{\circ} 00' 00''$   
 $R = 477.456'$   
 $T = 128.37'$   
 $L = 250.81'$   
 $E = 16.96'$

CAREY, THOMAS E. & CAROL M.  
 REV CURVE #10  
 $\Delta = 28^{\circ} 48' 34''$  RT.  
 $D = 12^{\circ} 18' 00''$   
 $R = 465.82'$   
 $T = 119.64'$   
 $L = 234.22'$   
 $E = 15.12'$

DATUM  
 VERTICAL NGVD 1929  
 HORIZONTAL N/A

ROW PLANS 15-FEB-1989

SURVEYED BY	MOREAU	DATE	7-85
DRAWN BY	DAYE/REDMOND	DATE	4-88
SQUAD LEADER	SHERIDAN		
DESIGN FILE NO.	76B033	DATE PLOTTED	
PROJ. NAME	MONTPELIER		
PROJ. NO./MEGC	M6400(7)		
R.O.W. SHEET	55 OF 385		