




THIS SHEET TO BE USED
FOR ROW INFORMATION ONLY

CONSTRUCT DRIVE
LEFT
68+28 34' WIDE(GRAVEL)

REV 69+08.74 =
SURV. 69+10.35
EQ=-1.61
END APPROACH

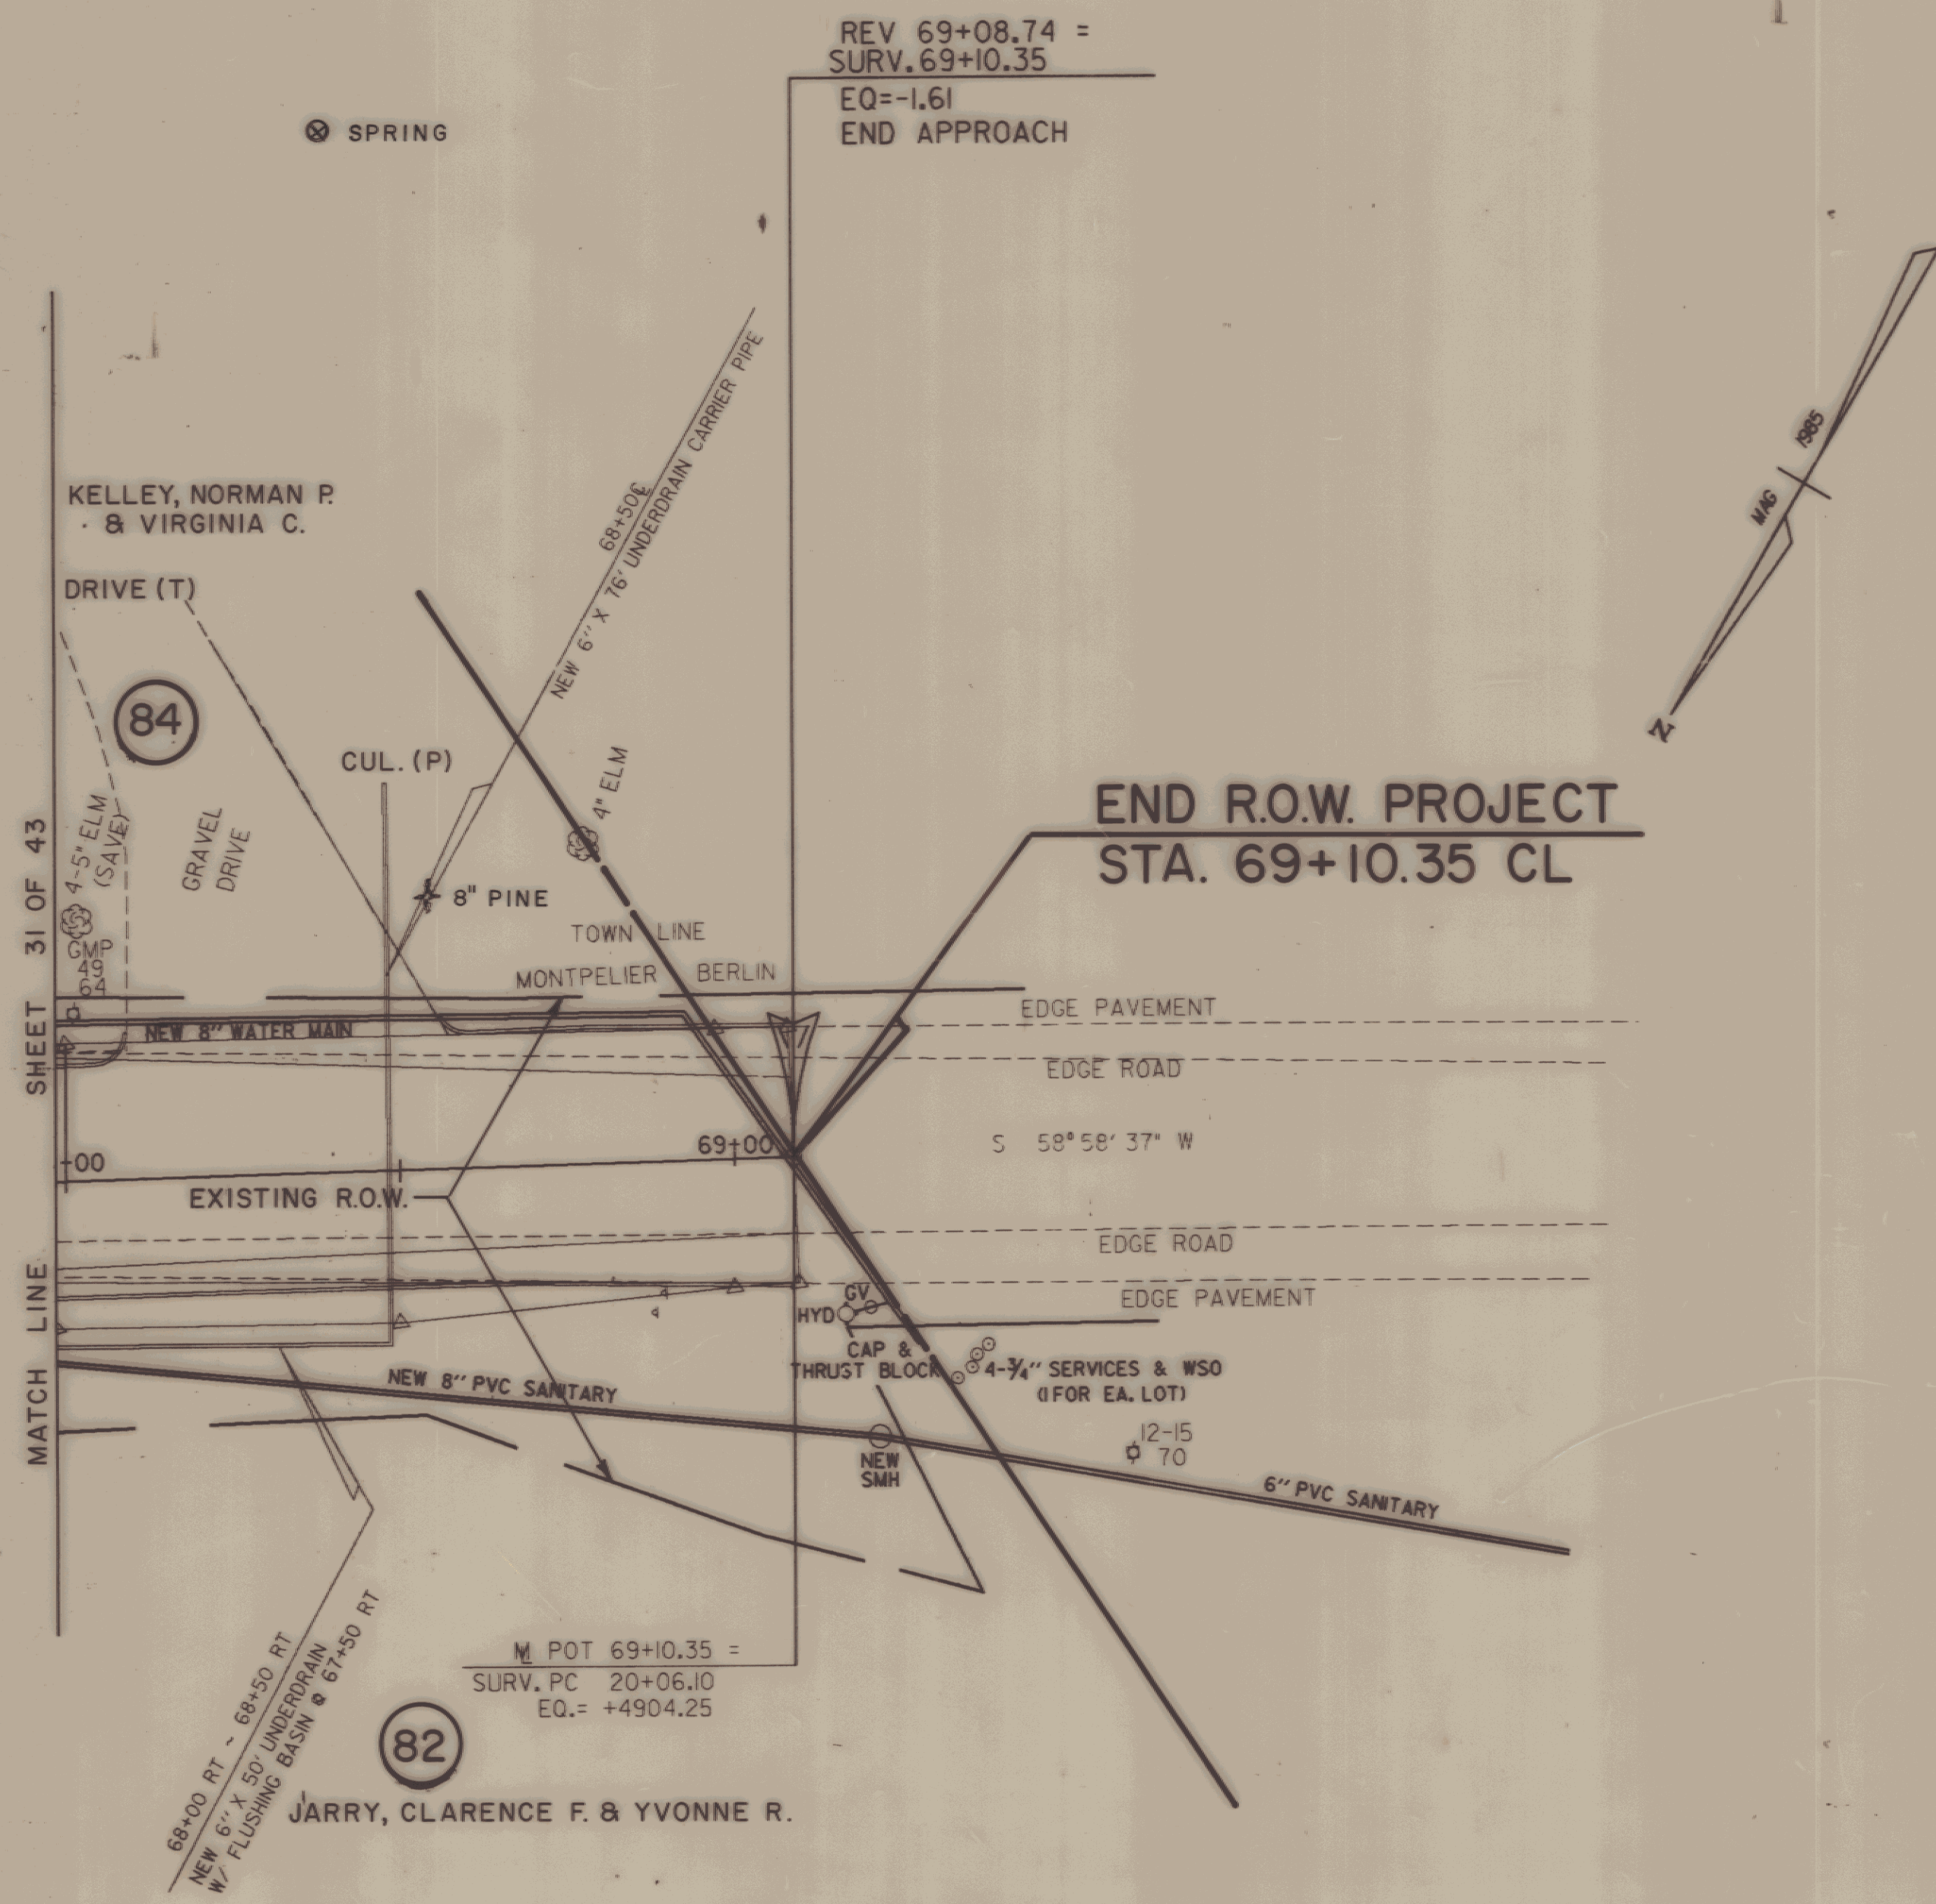

END R.O.W. PROJECT
STA. 69+10.35 CL

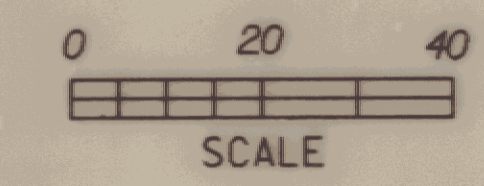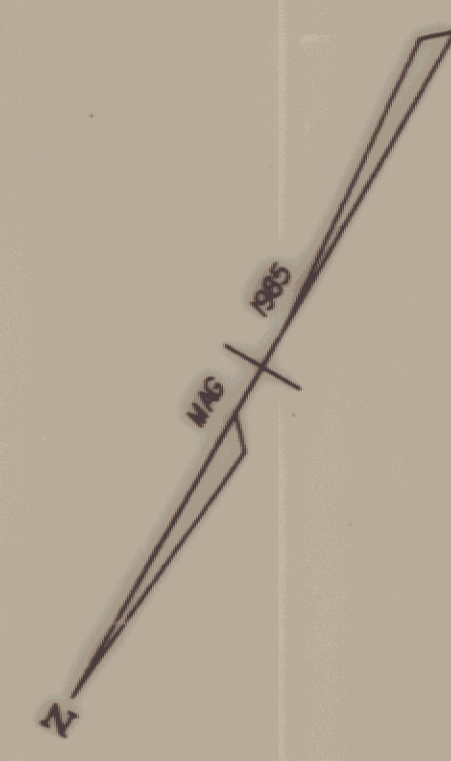

DATUM
VERTICAL NGVD 1929
HORIZONTAL N/A

R.O.W. PLANS		15-FEB-1989
SURVEYED BY	MOREAU	DATE 7-85
DRAWN BY	DAYE/REDMOND	DATE 4-88
SQUAD LEADER	SHERIDAN	
DESIGN FILE NO.	76B033	DATE PLOTTED
PROJ. NAME	MONTPELIER	
PROJ. NO.	MEGCM6400(7)	
R.O.W. SHEET 56 OF 335		