

CONSTRUCT RETAINING WALL ✓  
WITH METAL HANDRAIL

LT  
18+42 ~ 18+95  
19+00 ~ 19+20  
18+42 ~ 19+22 LT

CONSTRUCT CONCRETE STAIRWAY ✓  
WITH METAL HANDRAIL ✓

LT  
18+97.5 (5' WIDE) ✓  
19+81 (4' WIDE) ✓  
20+59 (4' WIDE) ✓

CONSTRUCT SIDEWALK RAMP ✓

LT RT  
18+84 (TYPE 6) 18+84 (TYPE 6)

PORTLAND CEMENT CONCRETE SIDEWALK-5" ✓

17+00 RT ~ 19+09 RT (5' WIDE)  
18+75 LT ~ 19+37 LT (3.5' WIDE)  
19+37 LT ~ 21+00 LT (5' WIDE)  
19+82 LT (4' WIDE PVT. WALK) ✓  
20+59 LT (2' WIDE PVT. WALK) ✓  
18+81 LT ~ 18+86 LT (5' W)  
18+86 LT ~ 19+21.4 LT (3.6' W)  
19+21.4 LT ~ 21+00 LT (5' W)

TRANSPLANTING TREES

19+01 ~ 19+04 RT (LILAC/HEST. 5)  
TREES TO BE PLANTED IN A LOCATION MUTUALLY  
AGREEABLE WITH THE PROPERTY OWNER AND RESIDENT  
ENGINEER.

EVERGREEN TREES

18+42 ~ 19+20 LT (3'-4' CEDAR HEDGE) (EST. 40) 79  
TREES TO BE PLANTED IN A LOCATION MUTUALLY  
AGREEABLE WITH THE PROPERTY OWNER AND RESIDENT  
ENGINEER.

DECIDUOUS TREES ✓

19+50 ~ 20+00 LT. (2-1 1/2" SUGAR MAPLES) ✓  
(SUGAR MAPLES TO BE PLANTED OUTSIDE  
OF R.O.W. IN A LOCATION MUTUALLY AGREEABLE  
WITH THE PROPERTY OWNER AND THE RESIDENT  
ENGINEER.

EXCAVATION OF SURFACES & PAVEMENTS ✓

RT  
17+00 - 17+55 (SIDEWALK)

LEFT  
19+30 12' WIDE (GRAVEL)  
19+96 12' WIDE (PAVED)  
20+14 12' WIDE (GRAVEL)  
20+70 12' WIDE (PAVED)


RIGHT  
17+57 12' WIDE (PAVED)  
18+67 12' WIDE (GRAVEL)  
19+98 14' WIDE (PAVED)  
21+00 12' WIDE (PAVED)

VERTICAL GRANITE CURB

LEFT	RIGHT
17+00 ~ 18+81	17+00 ~ 17+46
18+87 ~ 19+19	17+68 ~ 18+56
19+41 ~ 19+85	18+78 ~ 19+25
20+25 ~ 20+59	19+52 ~ 19+91
20+81 ~ 21+00	20+05 ~ 20+94
18+86 ~ 21+00	17+00 ~ 21+00

FINAL STATIONS DO NOT  
INCLUDE BREAKS FOR DRIVES

DATUM  
VERTICAL NGVD 1929  
HORIZONTAL N/A

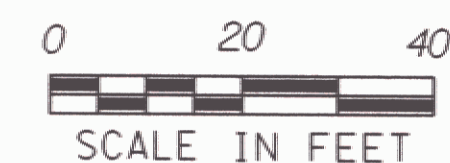

BITUMINOUS CONCRETE SIDEWALK  
18+99 LT (3'-WIDE PVT. WALK)  
DONE AS CONCRETE

□ DENOTES REMOVAL, NON-GOV'T. PARTICIPATION  
○ DENOTES REMOVAL, GOV'T. PARTICIPATION

SURVEYED BY MOREAU DATE 7-85  
DRAWN BY COTA/NAILOR DATE 4-88  
SQUAD LEADER SHERIDAN  
DESIGN FILE NO. Z60-[50,116]PETED.DGN; 1  
IFIRM FILE PETED2.PRF DATE PLOTTED 9-FEB-1996  
PROJ. NAME MONTPELIER  
PROJ. NO. MEGC M 6400(7)  
SHEET 63 OF 355 SHEETS

